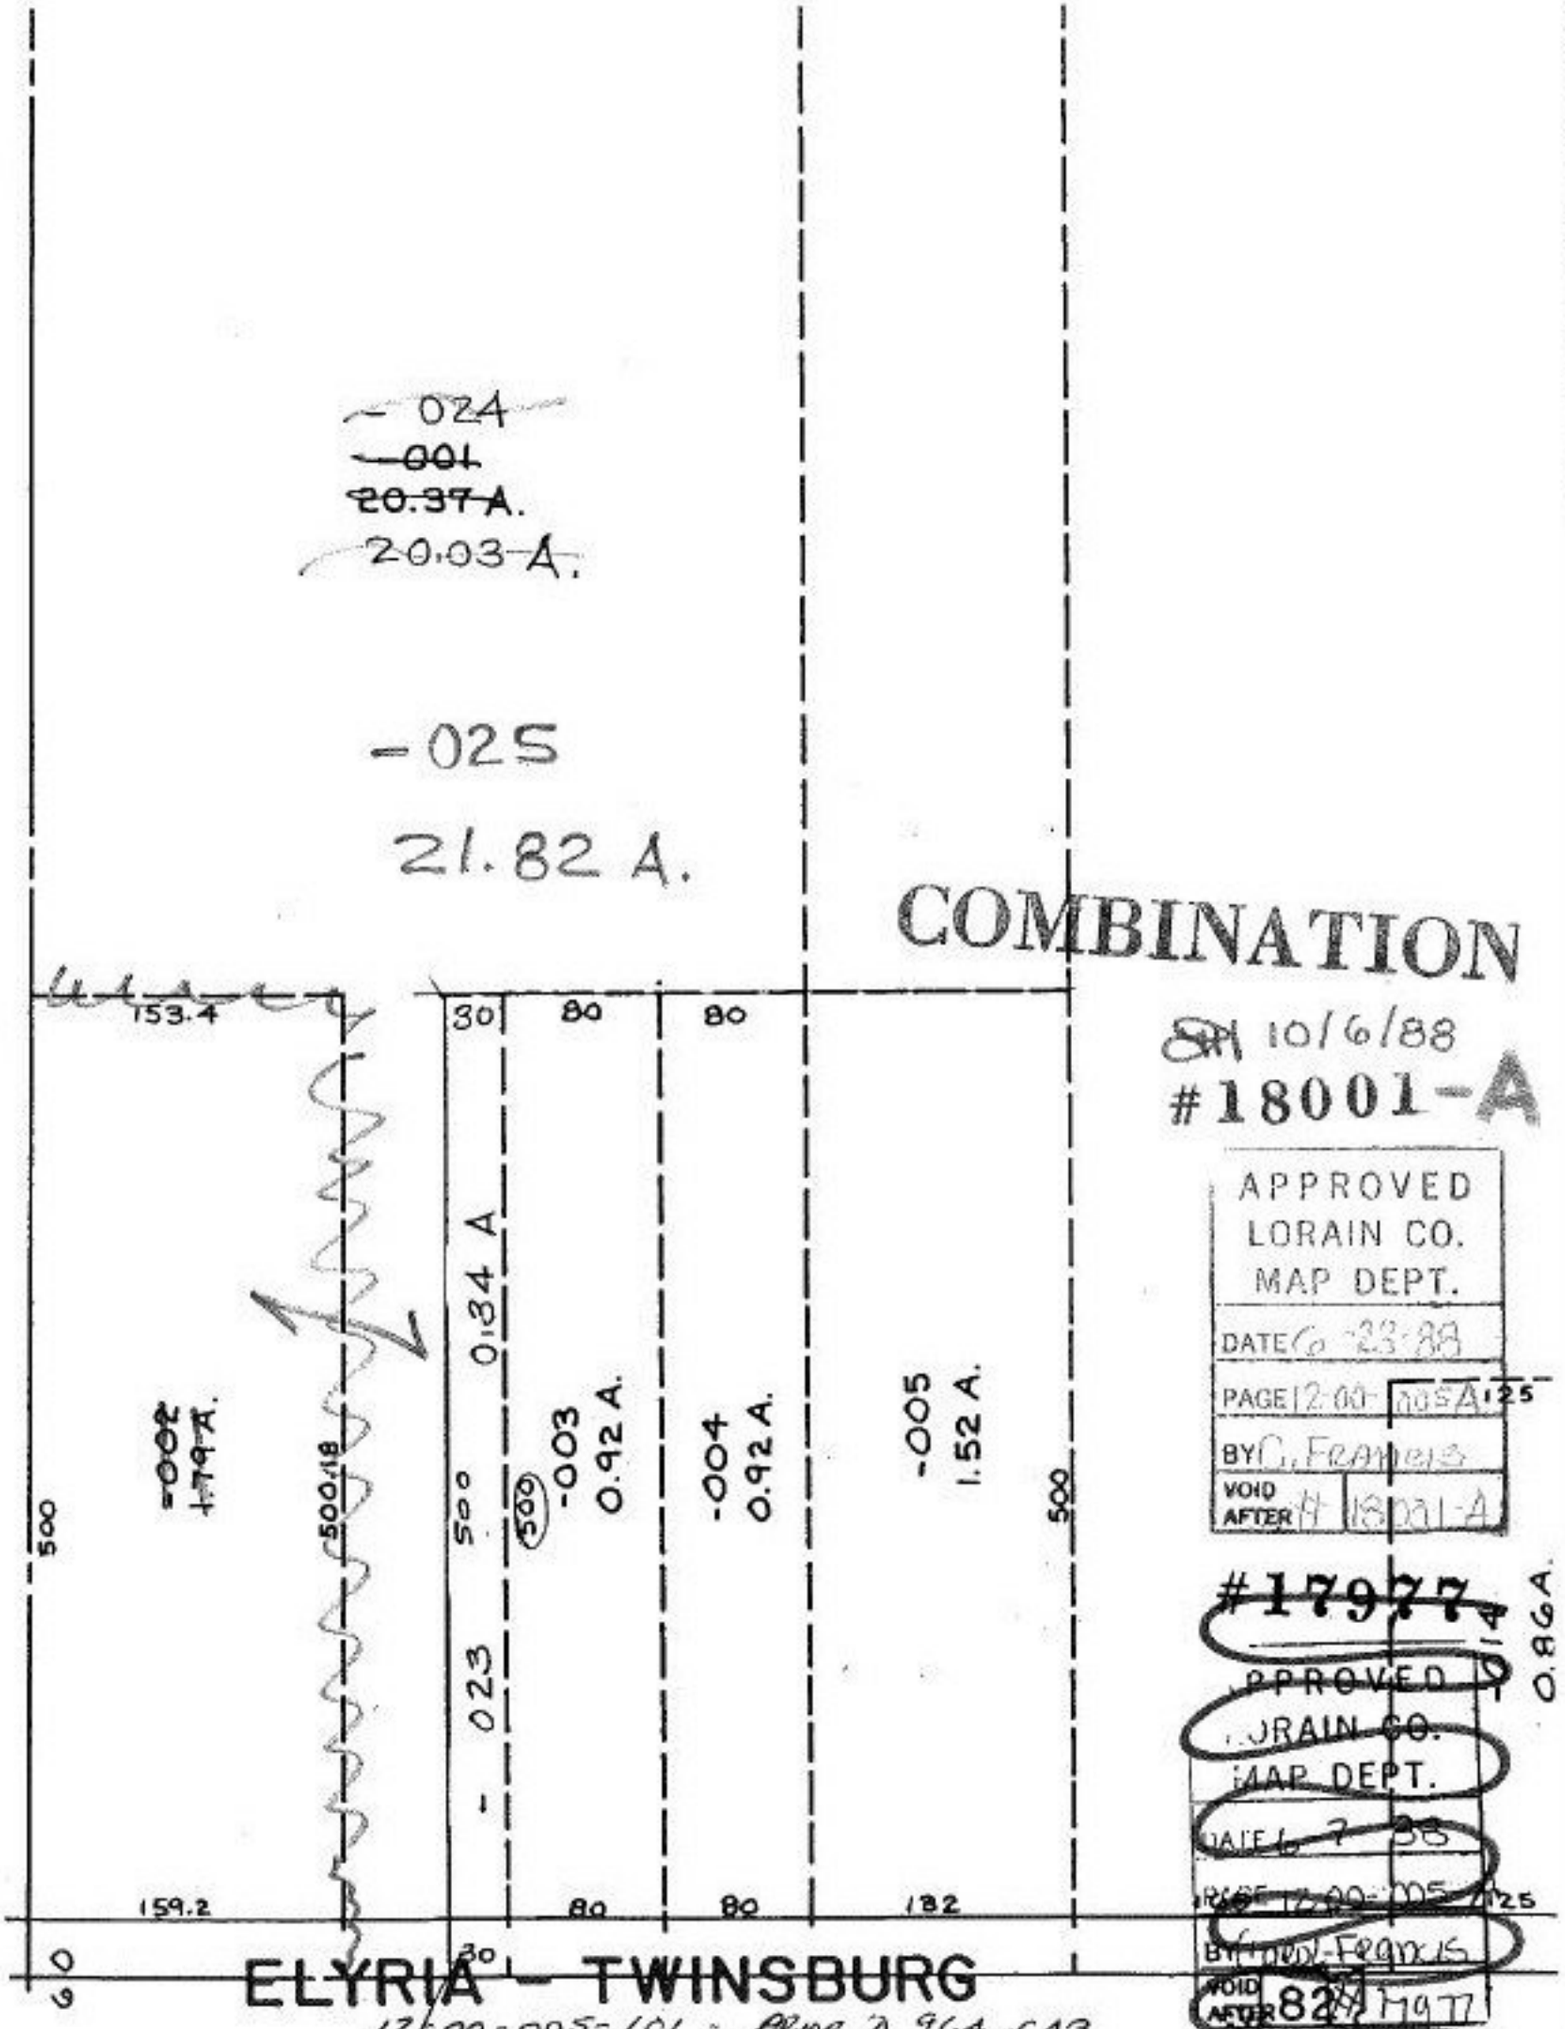
-024
-001
20.37 A.
20.03 A.
-025
21.82 A.
COMBINATION
10/6/88
#18001-A
APPROVED
LORAIN CO.
MAP DEPT.
PAGE 12-00-005A 125
BY C. Frances
VOID AFTER #18001-A
#17977
APPROVED
LORAIN CO.
MAP DEPT.
DATE 6-7-88
PAGE 12-00-005 125
BY Fred-Frances
VOID AFTER 82 17977
SEE
153.4
30
80
80
0.84 A
-002
1.79 A.
500.18
500
500
-003
0.92 A.
-004
0.92 A.
-005
1.52 A.
500
-023
159.2
80
80
182
60
30
ELYRIA - TWINSBURG
12-00-005-101 - Arlon D, 964-643
938-961
Survey by, John Hamilton