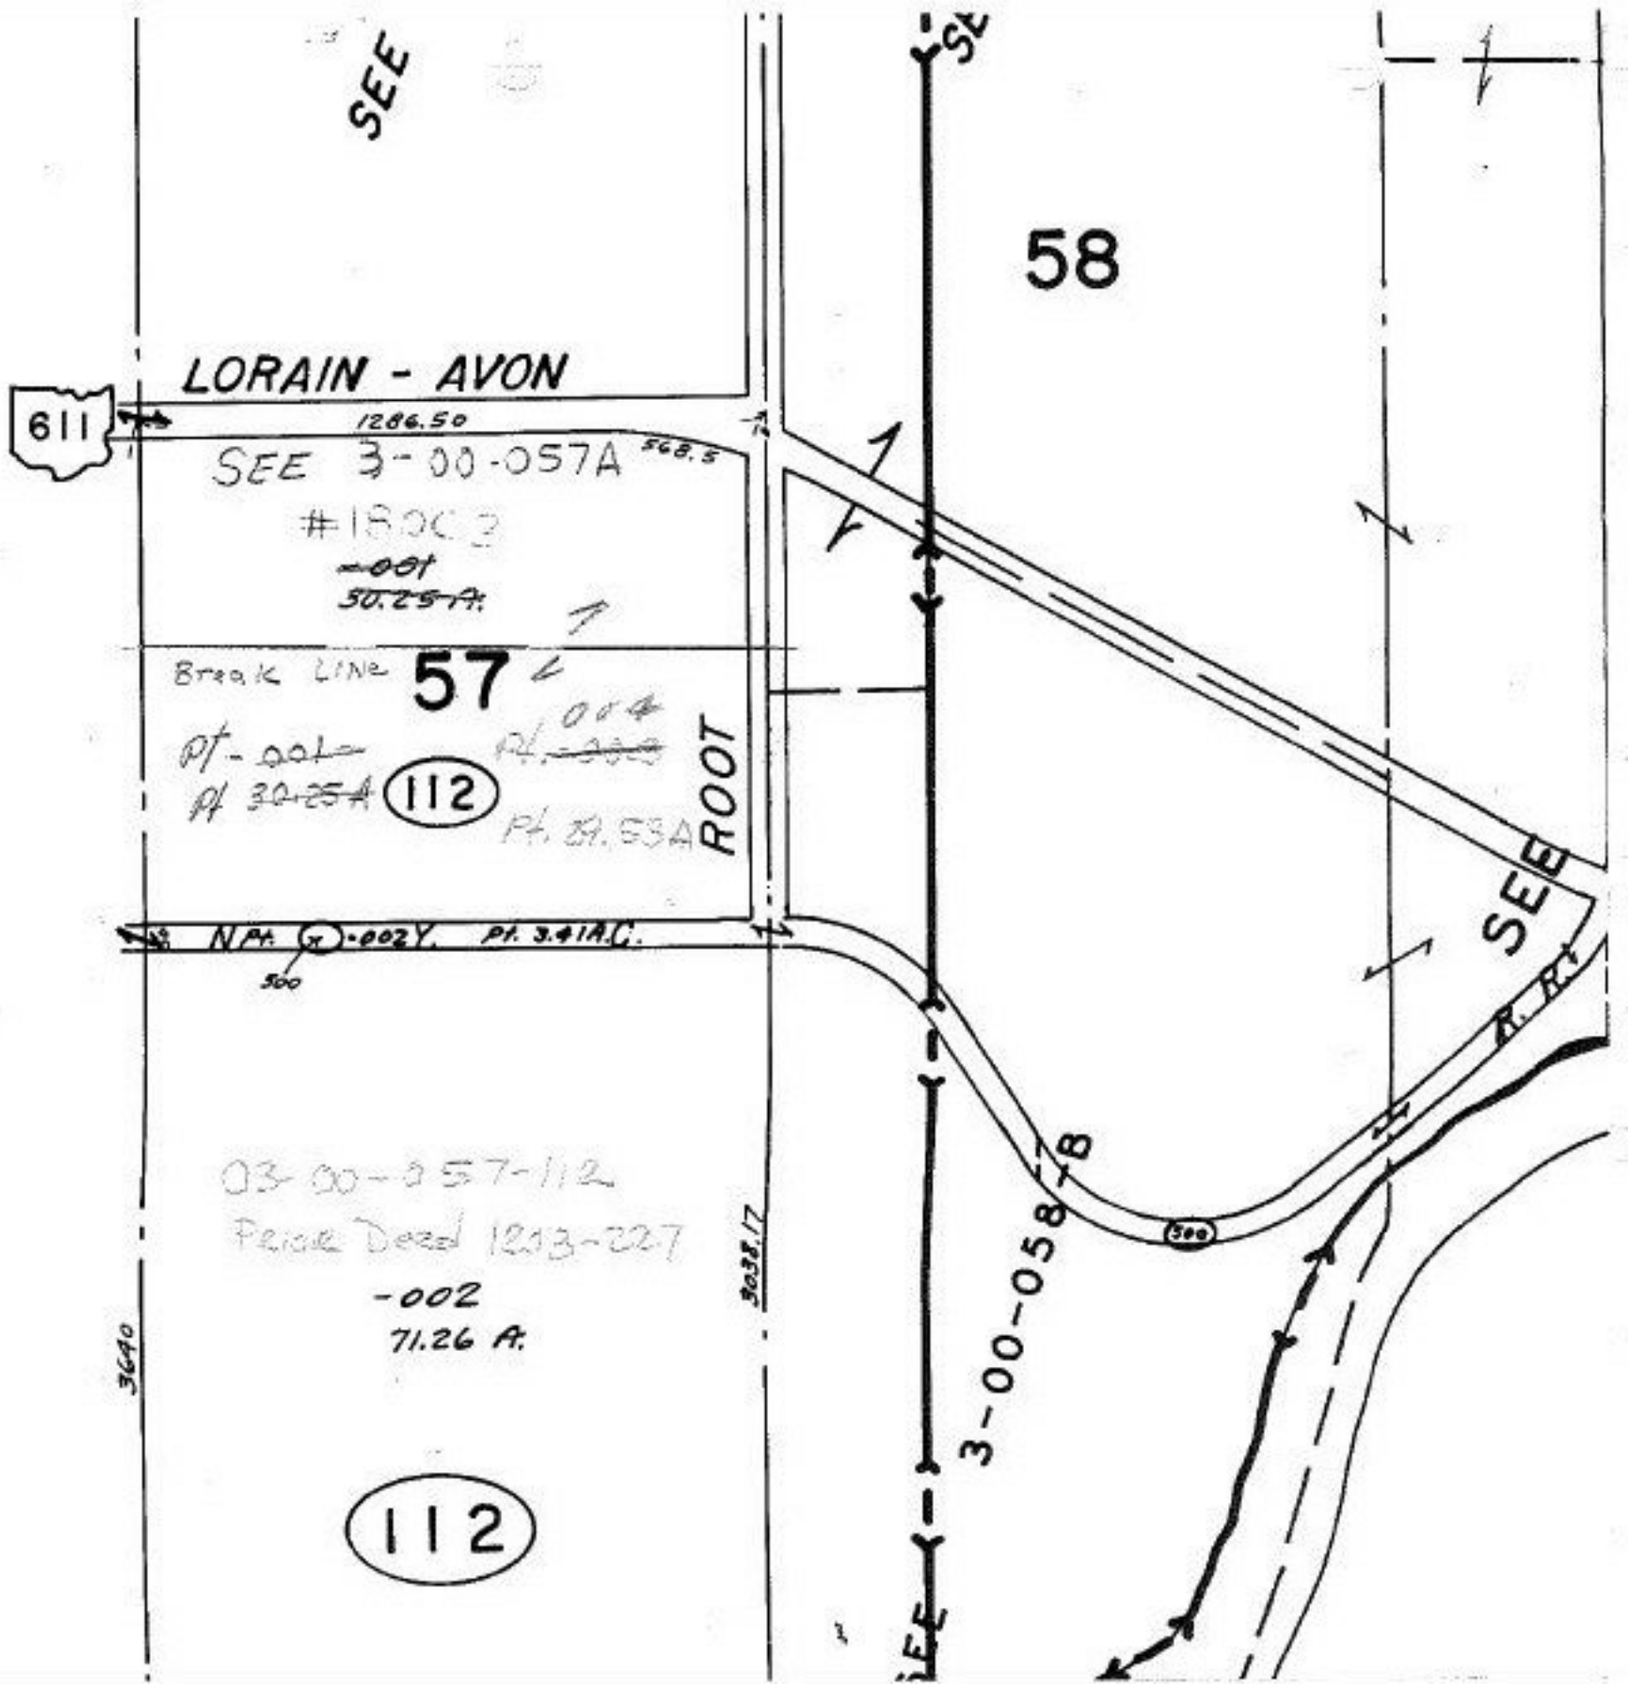

SH 7/21/88
#18003

APPROVED
LORAIN CO.
MAP DEPT.

DATE 6-22-88
PAGE 3-B
BY [illegible]
VOID AFTER SH 18003