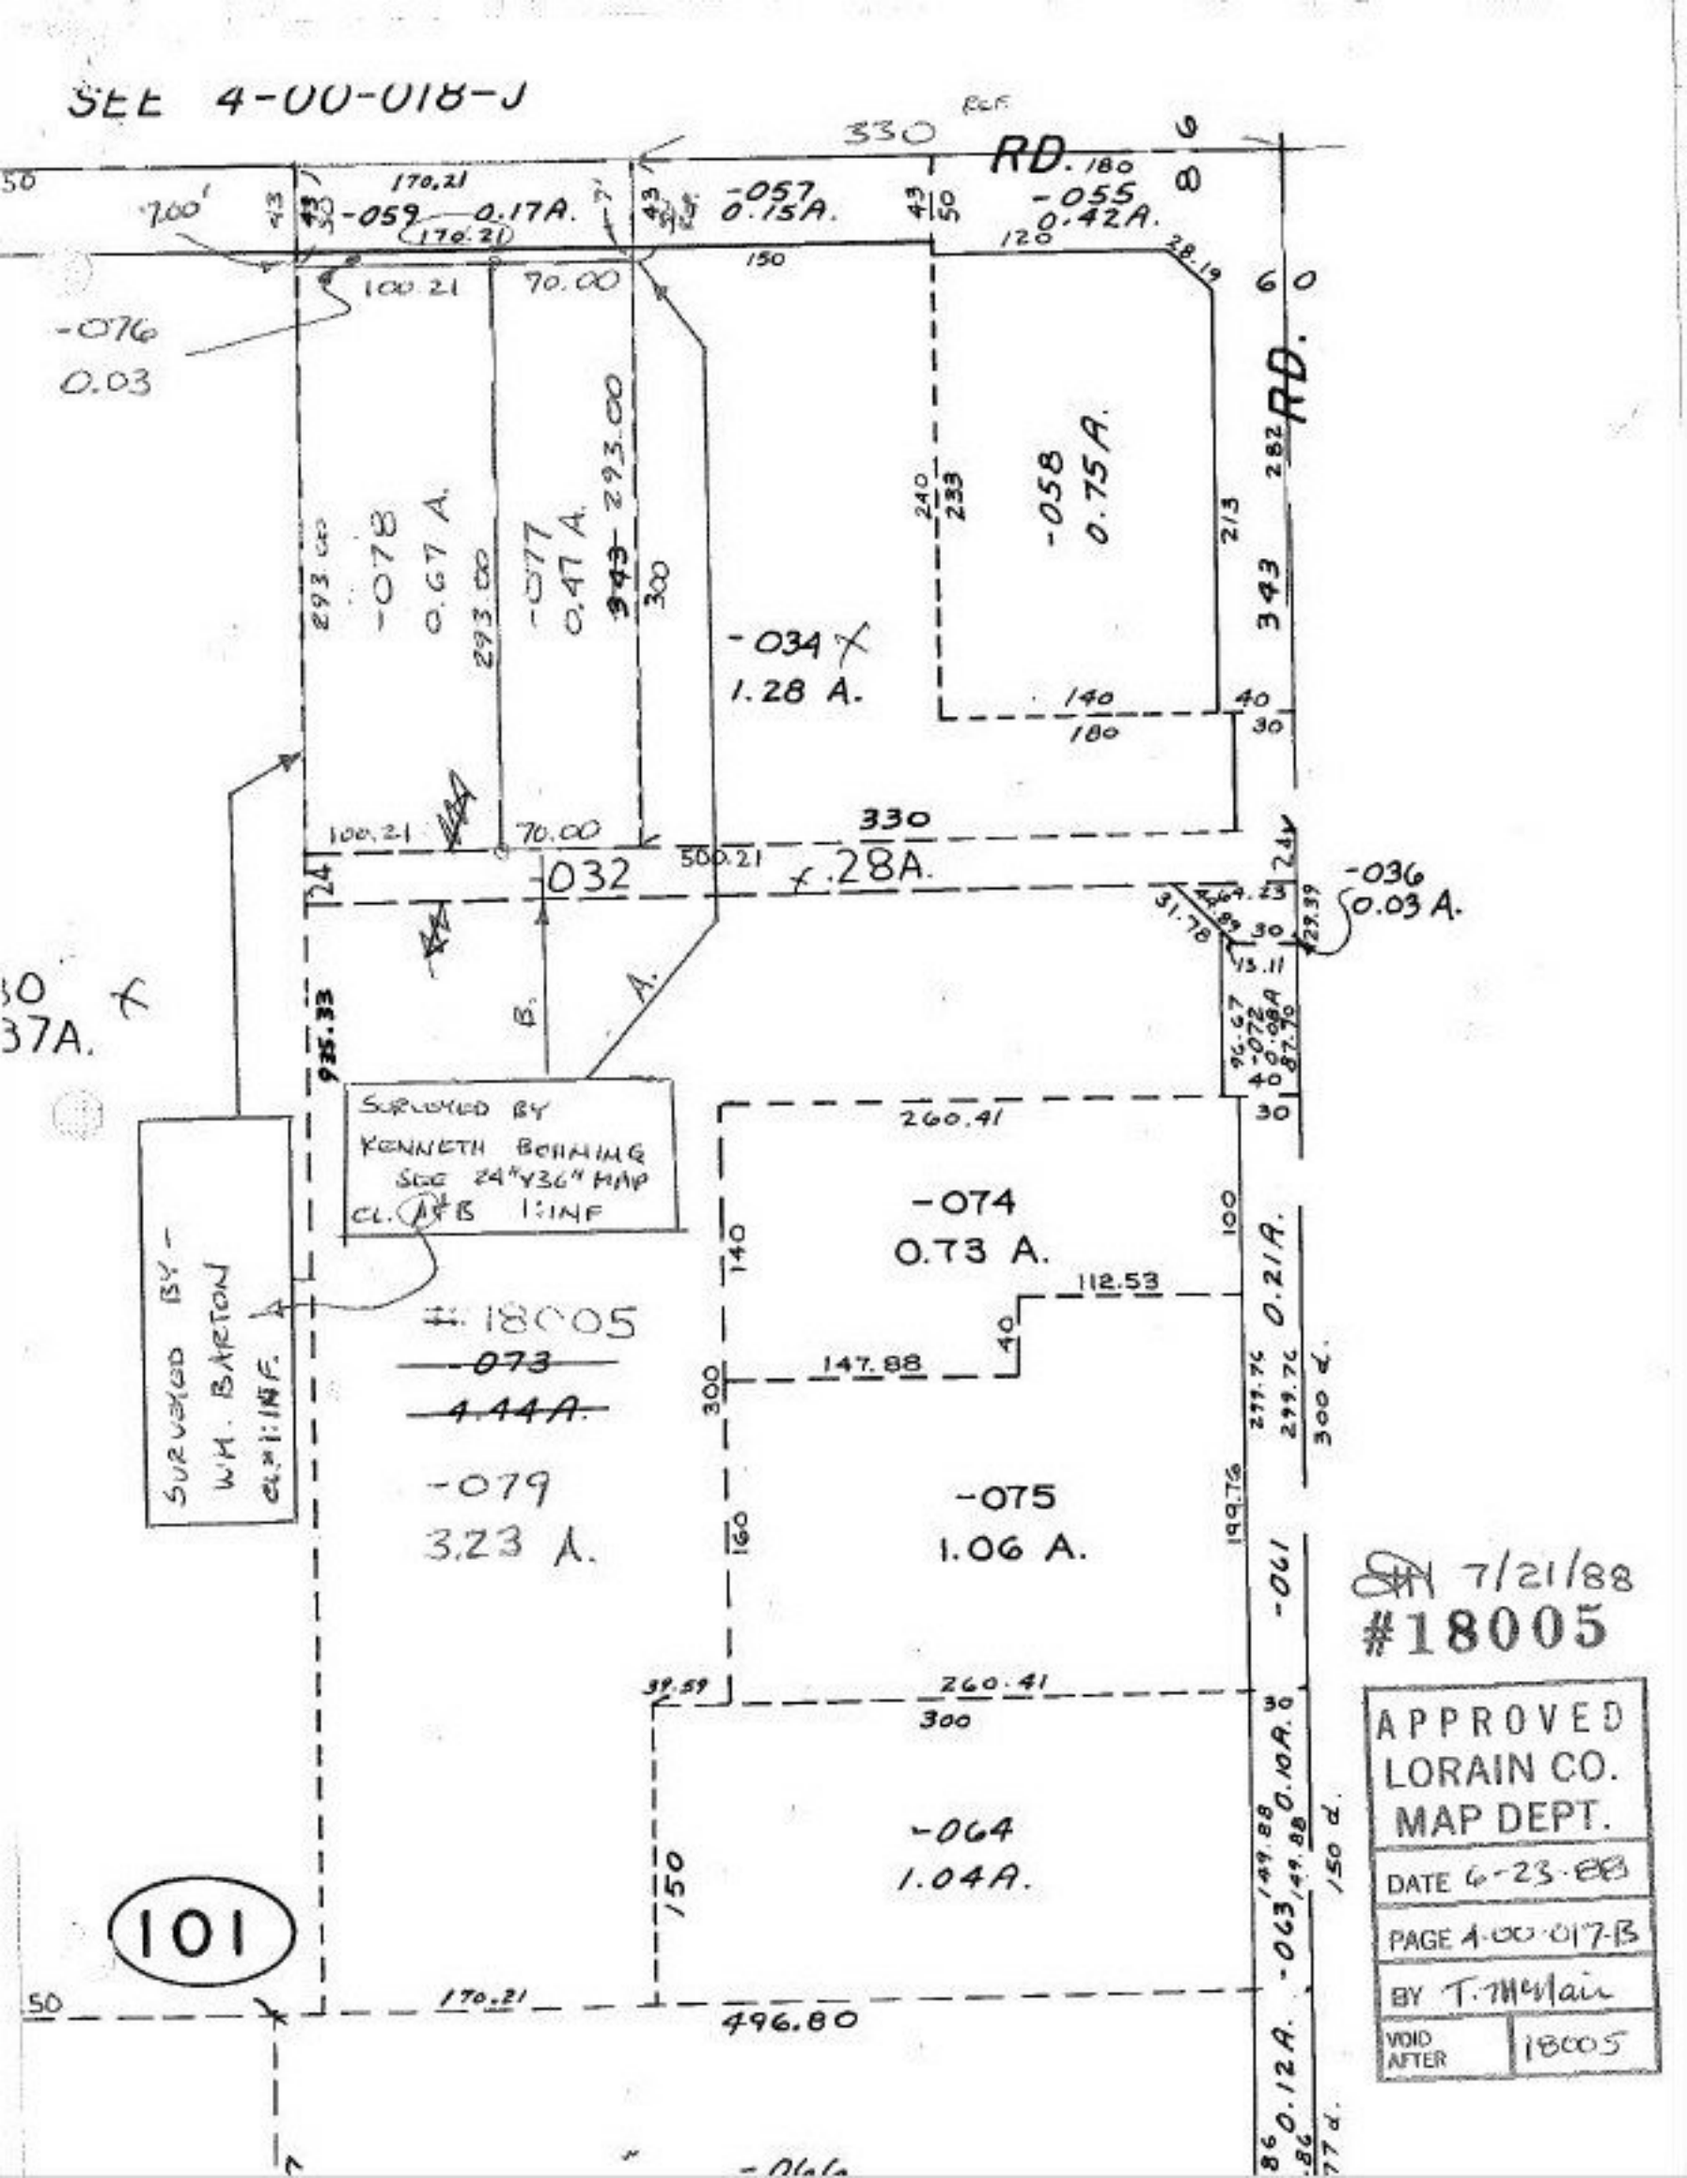
SEE 4-00-018-J
330
RD.
-057
0.15A.
-055
0.42A.
-059
0.17A.
-076
0.03
-078
0.67 A.
-077
0.47 A.
-034
1.28 A.
-058
0.75A.
-032
1.28A.
-036
0.03 A.
SURVEYED BY
KENNETH BOEHMER
CL. A&B 1:INF
SURVEYED BY -
W.H. BARTON
CL. B 1:INF.
#18005
-073
4.44A.
-079
3.23 A.
-074
0.73 A.
-075
1.06 A.
-064
1.04A.
-061
0.21A.
-063
0.10A.
0.12A.
101
496.80
7/21/88
#18005
APPROVED
LORAIN CO.
MAP DEPT.
DATE 6-23-88
PAGE 4-00-017-B
BY T. McMain
VOID AFTER
18005