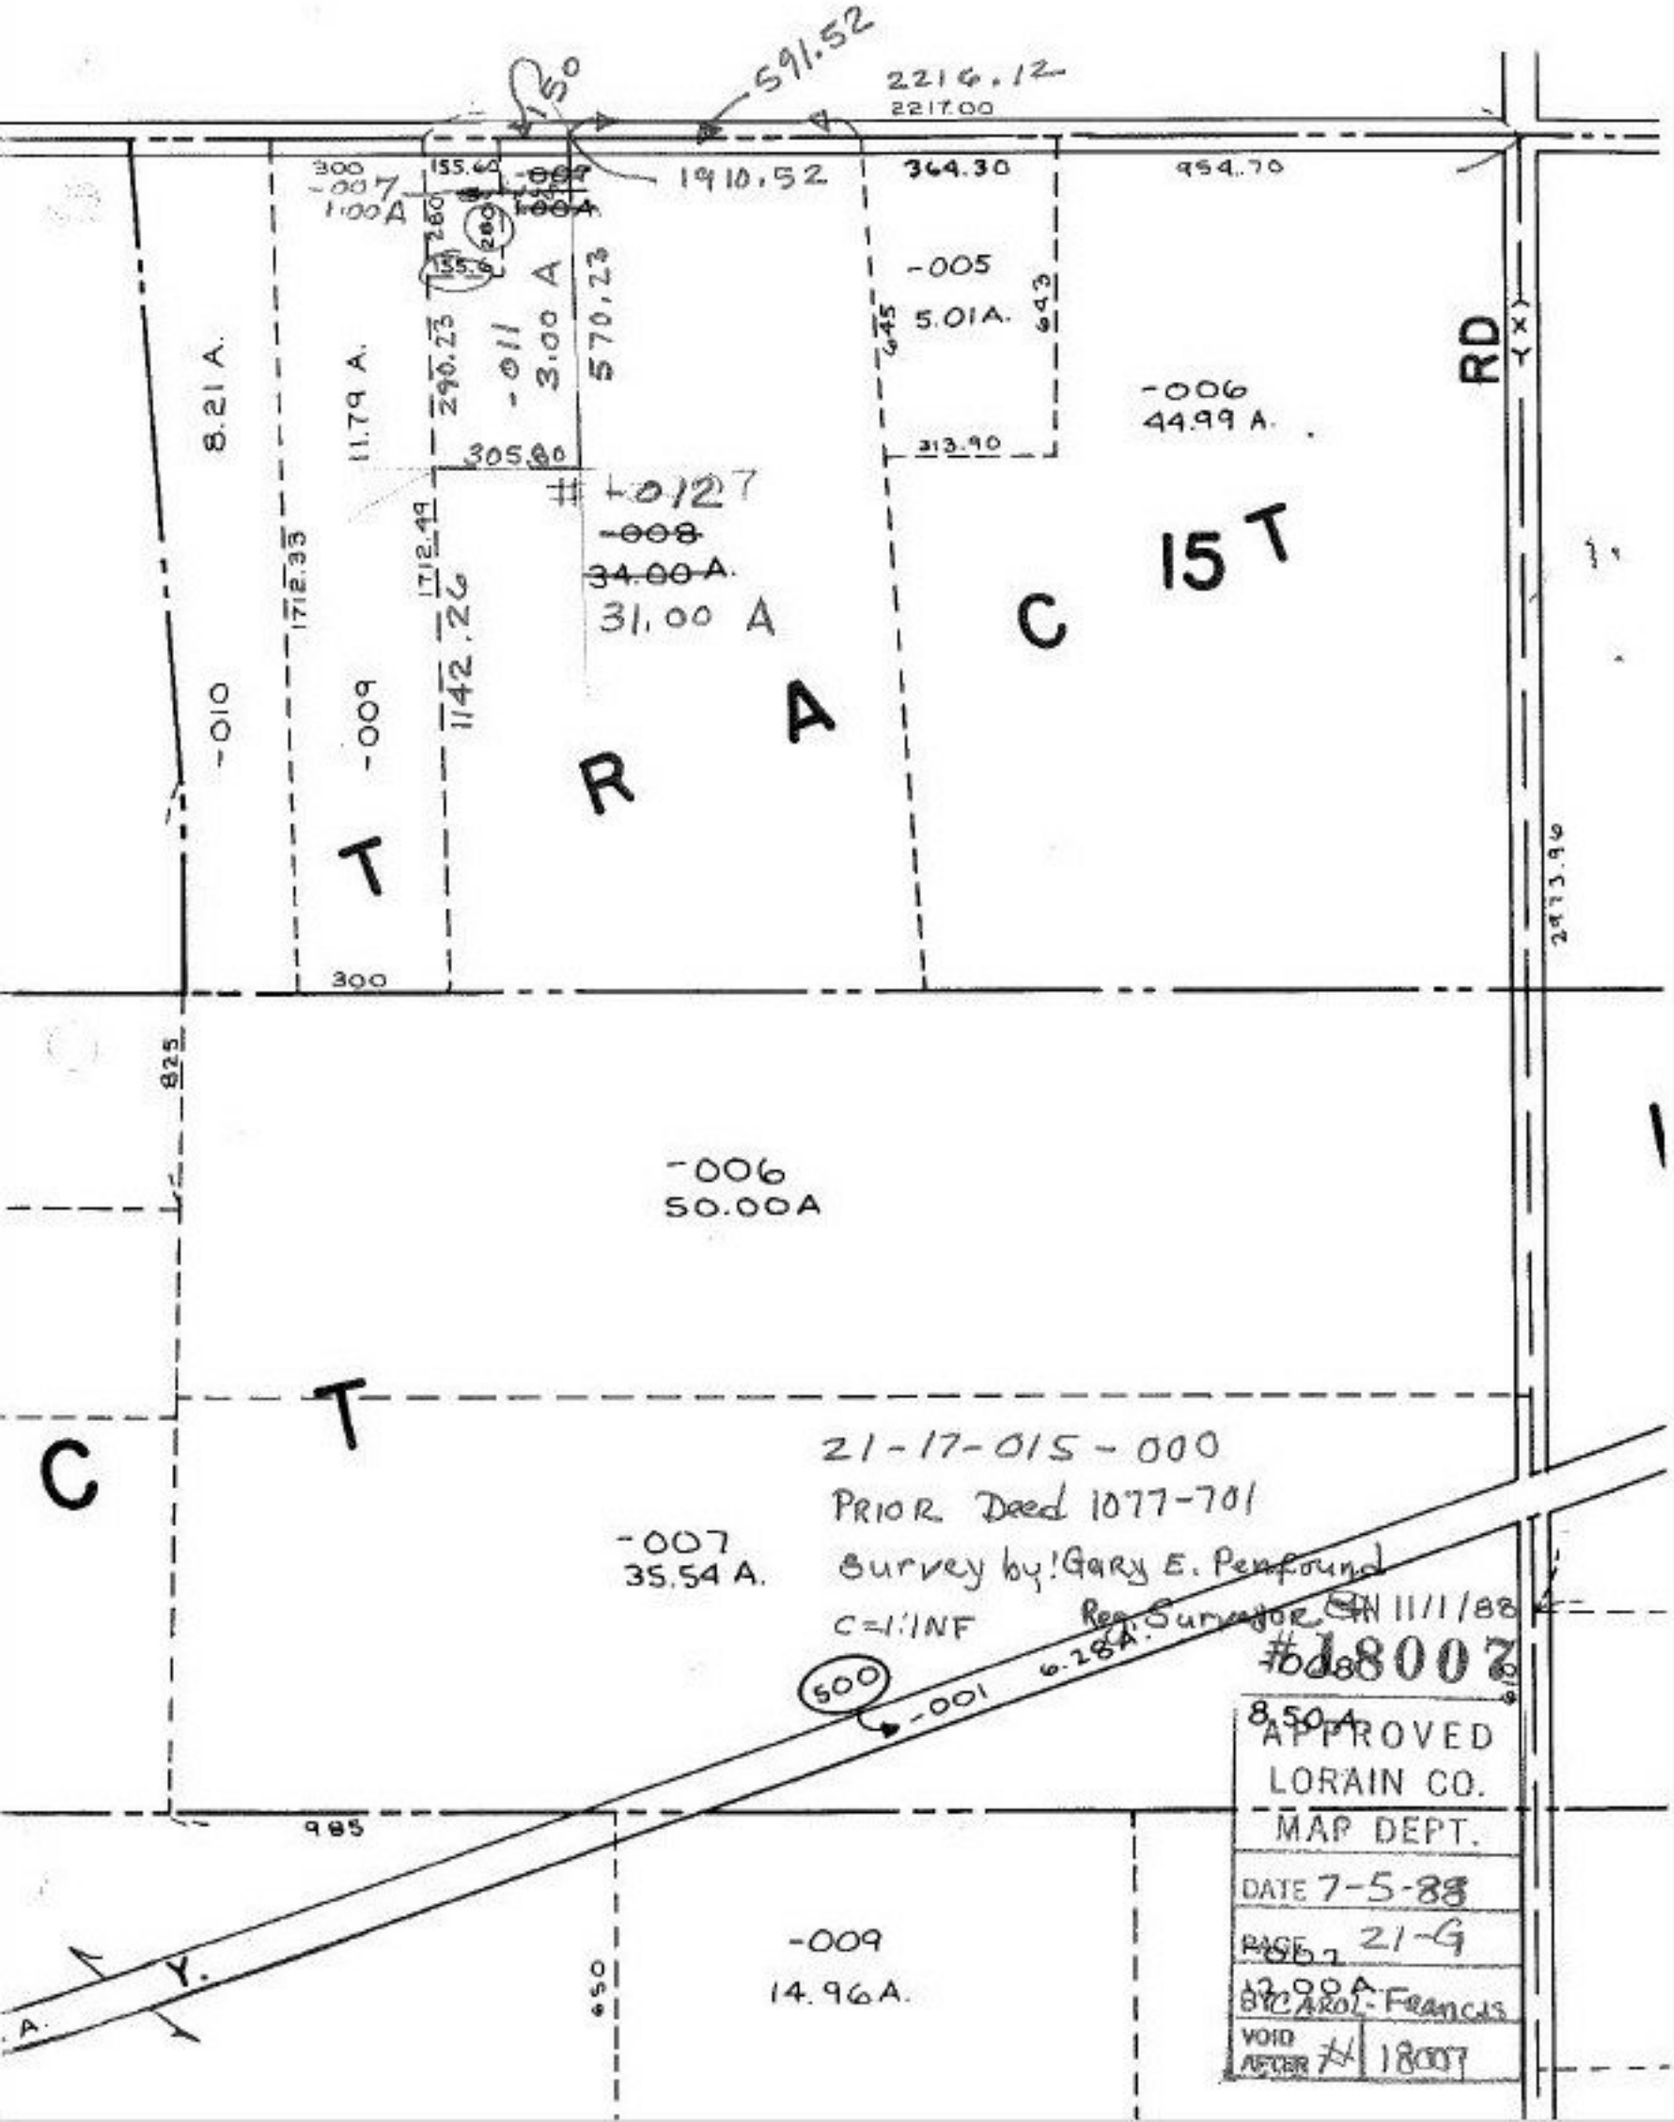
591.52
2216.12
2217.00
1910.52
364.30
954.70
300
-007
1.00A
155.60
155.6
-011
3.00 A
570.23
290.23
-005
5.01A.
645
643
-006
44.99 A.
313.90
305.80
8.21 A.
11.79 A.
1712.33
1712.49
1142.26
#-0127
-008
34.00 A.
31.00 A
-010
-009
T R A C 15 T
RD
2973.96
300
825
-006
50.00A
C T
21-17-015-000
PRIOR Deed 1077-701
Survey by: Gary E. Penfound
C=1:1NF
Reg. Surveyor
11/1/88
-007
35.54 A.
500
-001
6.28A.
#18007
8.50A.
985
-009
14.96A.
650
Y.
APPROVED
LORAIN CO.
MAP DEPT.
DATE 7-5-88
PAGE 21-G
12.00A
BY CAROL Francis
VOID AFTER # 18007