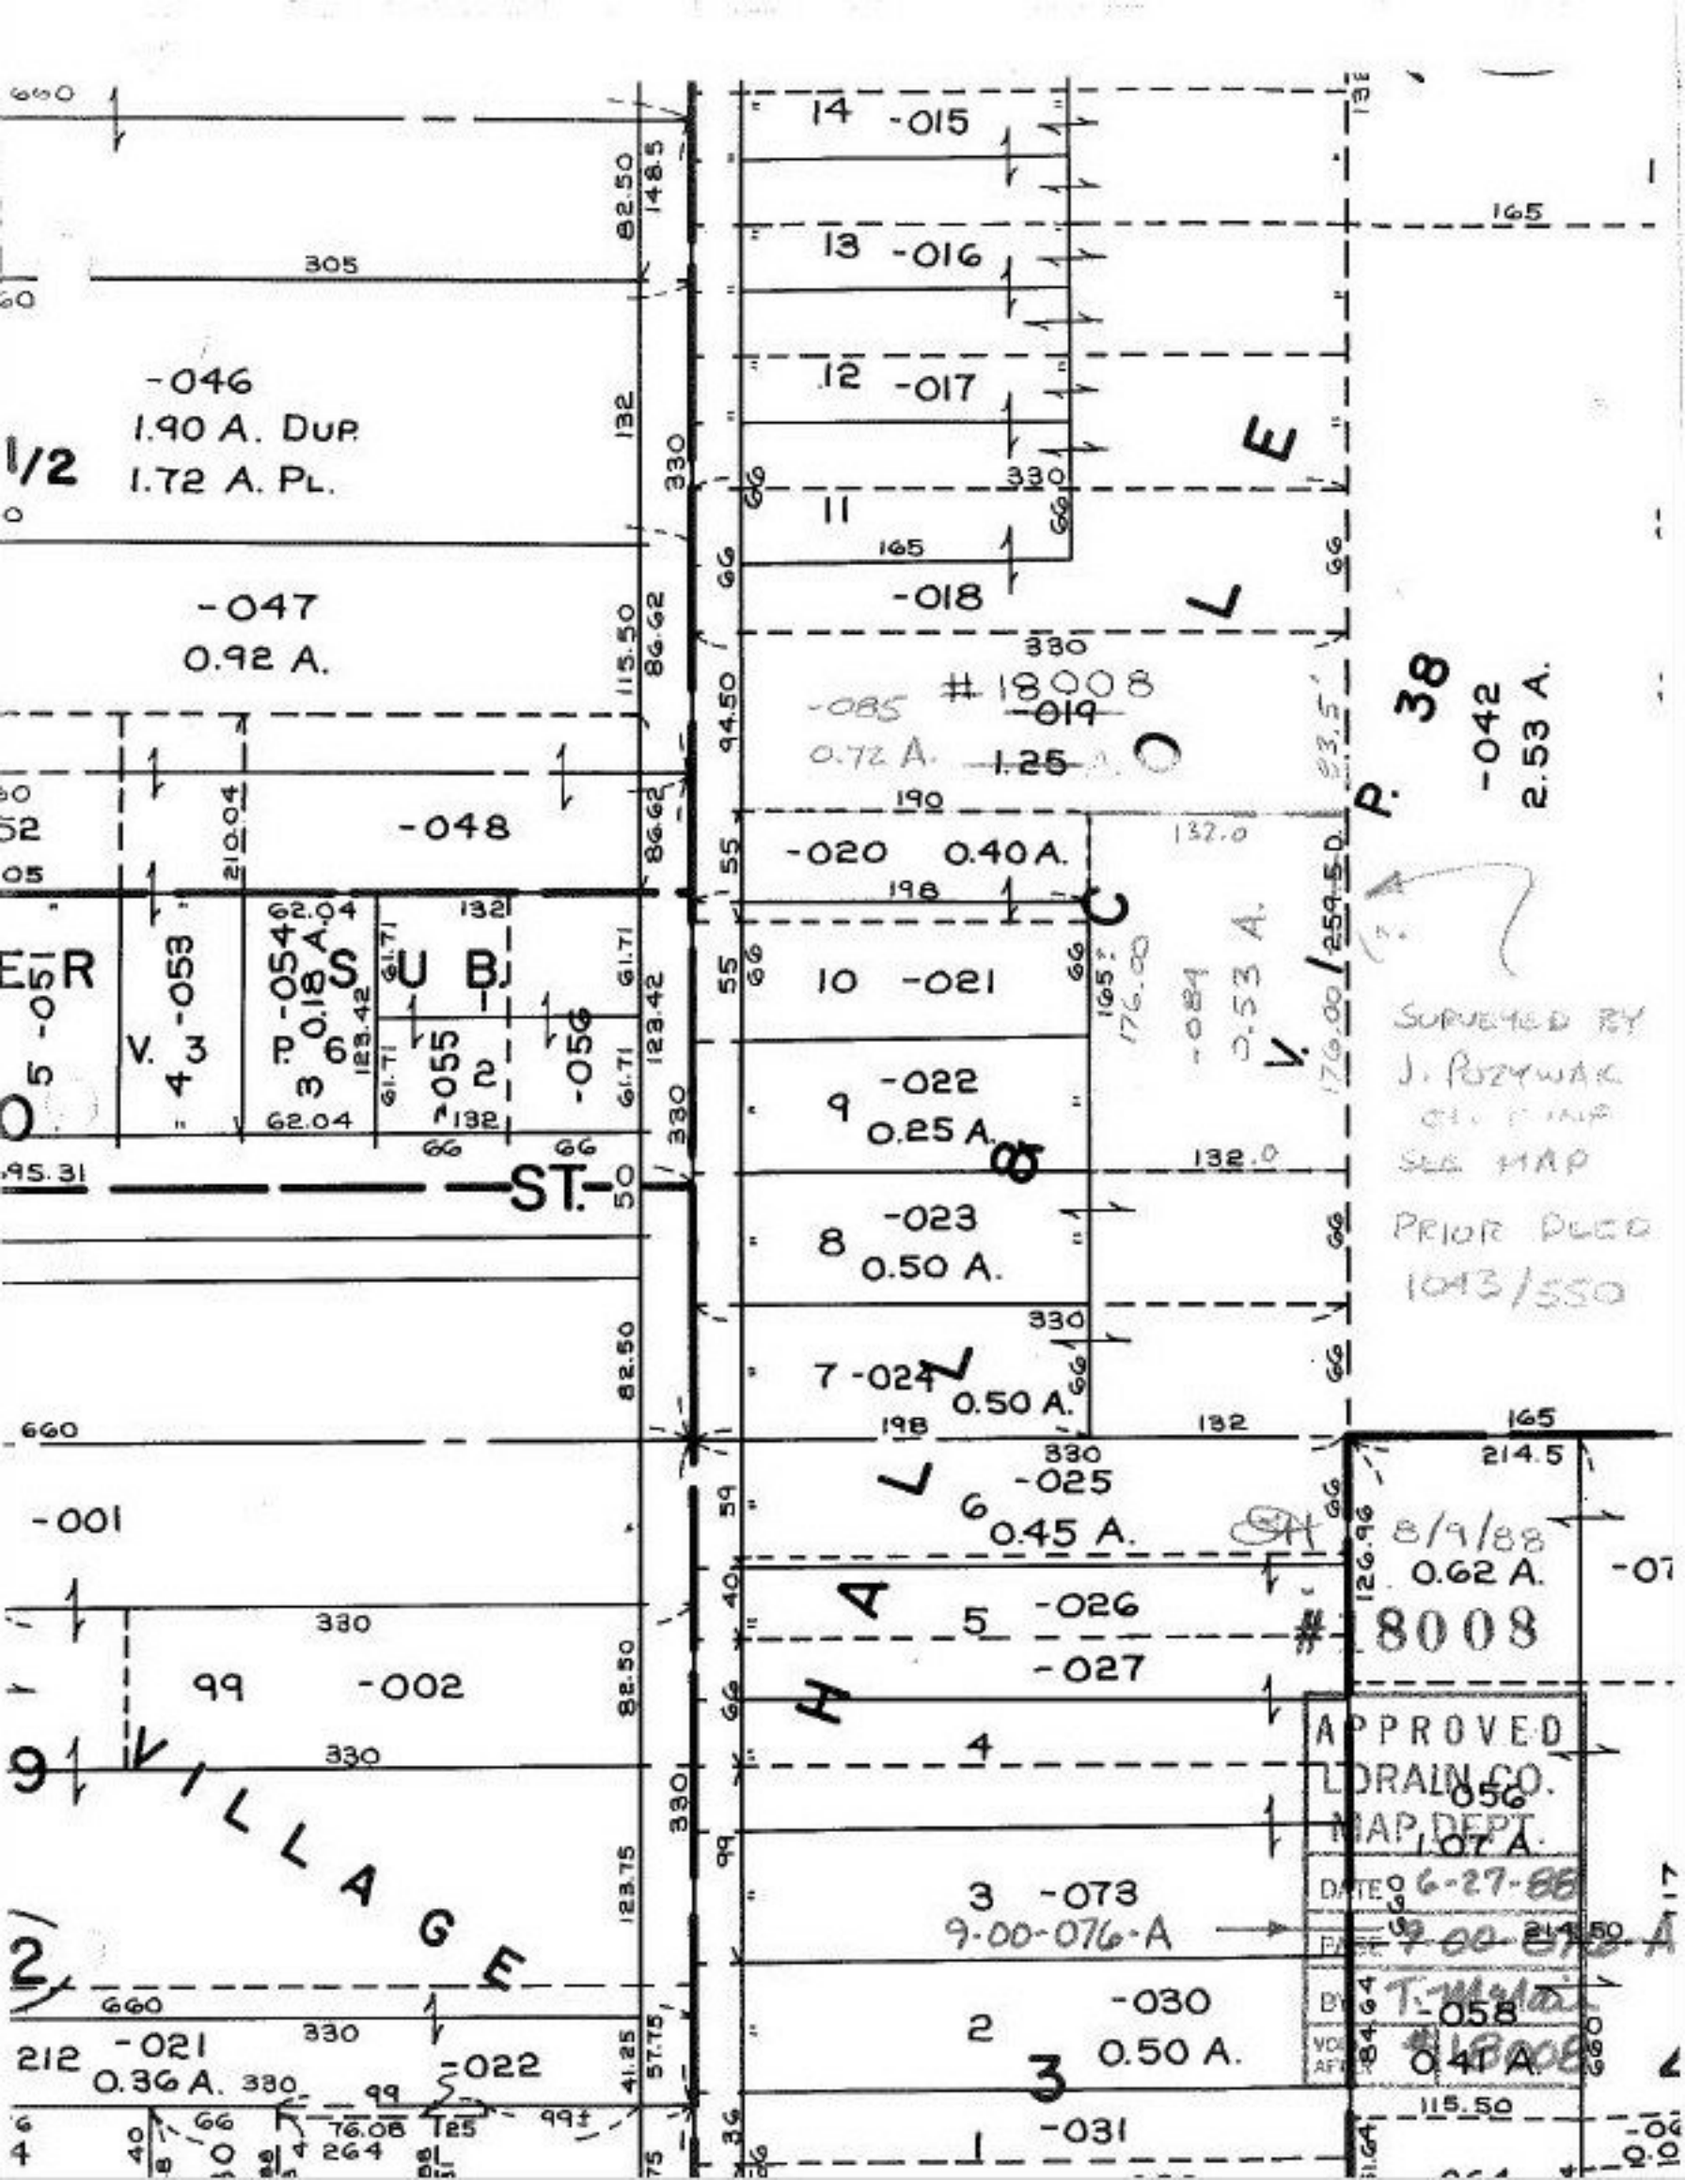
-046
1.90 A. DUP.
1.72 A. PL.
-047
0.92 A.
-048
-051
-053
-054
0.18 A.
-055
-056
ST.
-001
99
-002
-021
0.36 A.
-022
212
14 -015
13 -016
12 -017
11
-018
-019
1.25 A.
#18008
-085
0.72 A.
-020 0.40 A.
10 -021
-084
0.53 A.
9 -022
0.25 A.
8 -023
0.50 A.
7 -024
0.50 A.
-025
6 0.45 A.
5 -026
-027
4
3 -073
9-00-076-A
2 -030
0.50 A.
-031
-042
2.53 A.
P. 38
SURVEYED BY
J. POZYWAK
SEE MAP
PRIOR DEED
1043/550
8/9/88
0.62 A.
#18008
APPROVED
L. DRAIN CO.
MAP DEPT.
DATE 6-27-88
0.41 A.
HALL
VILLAGE