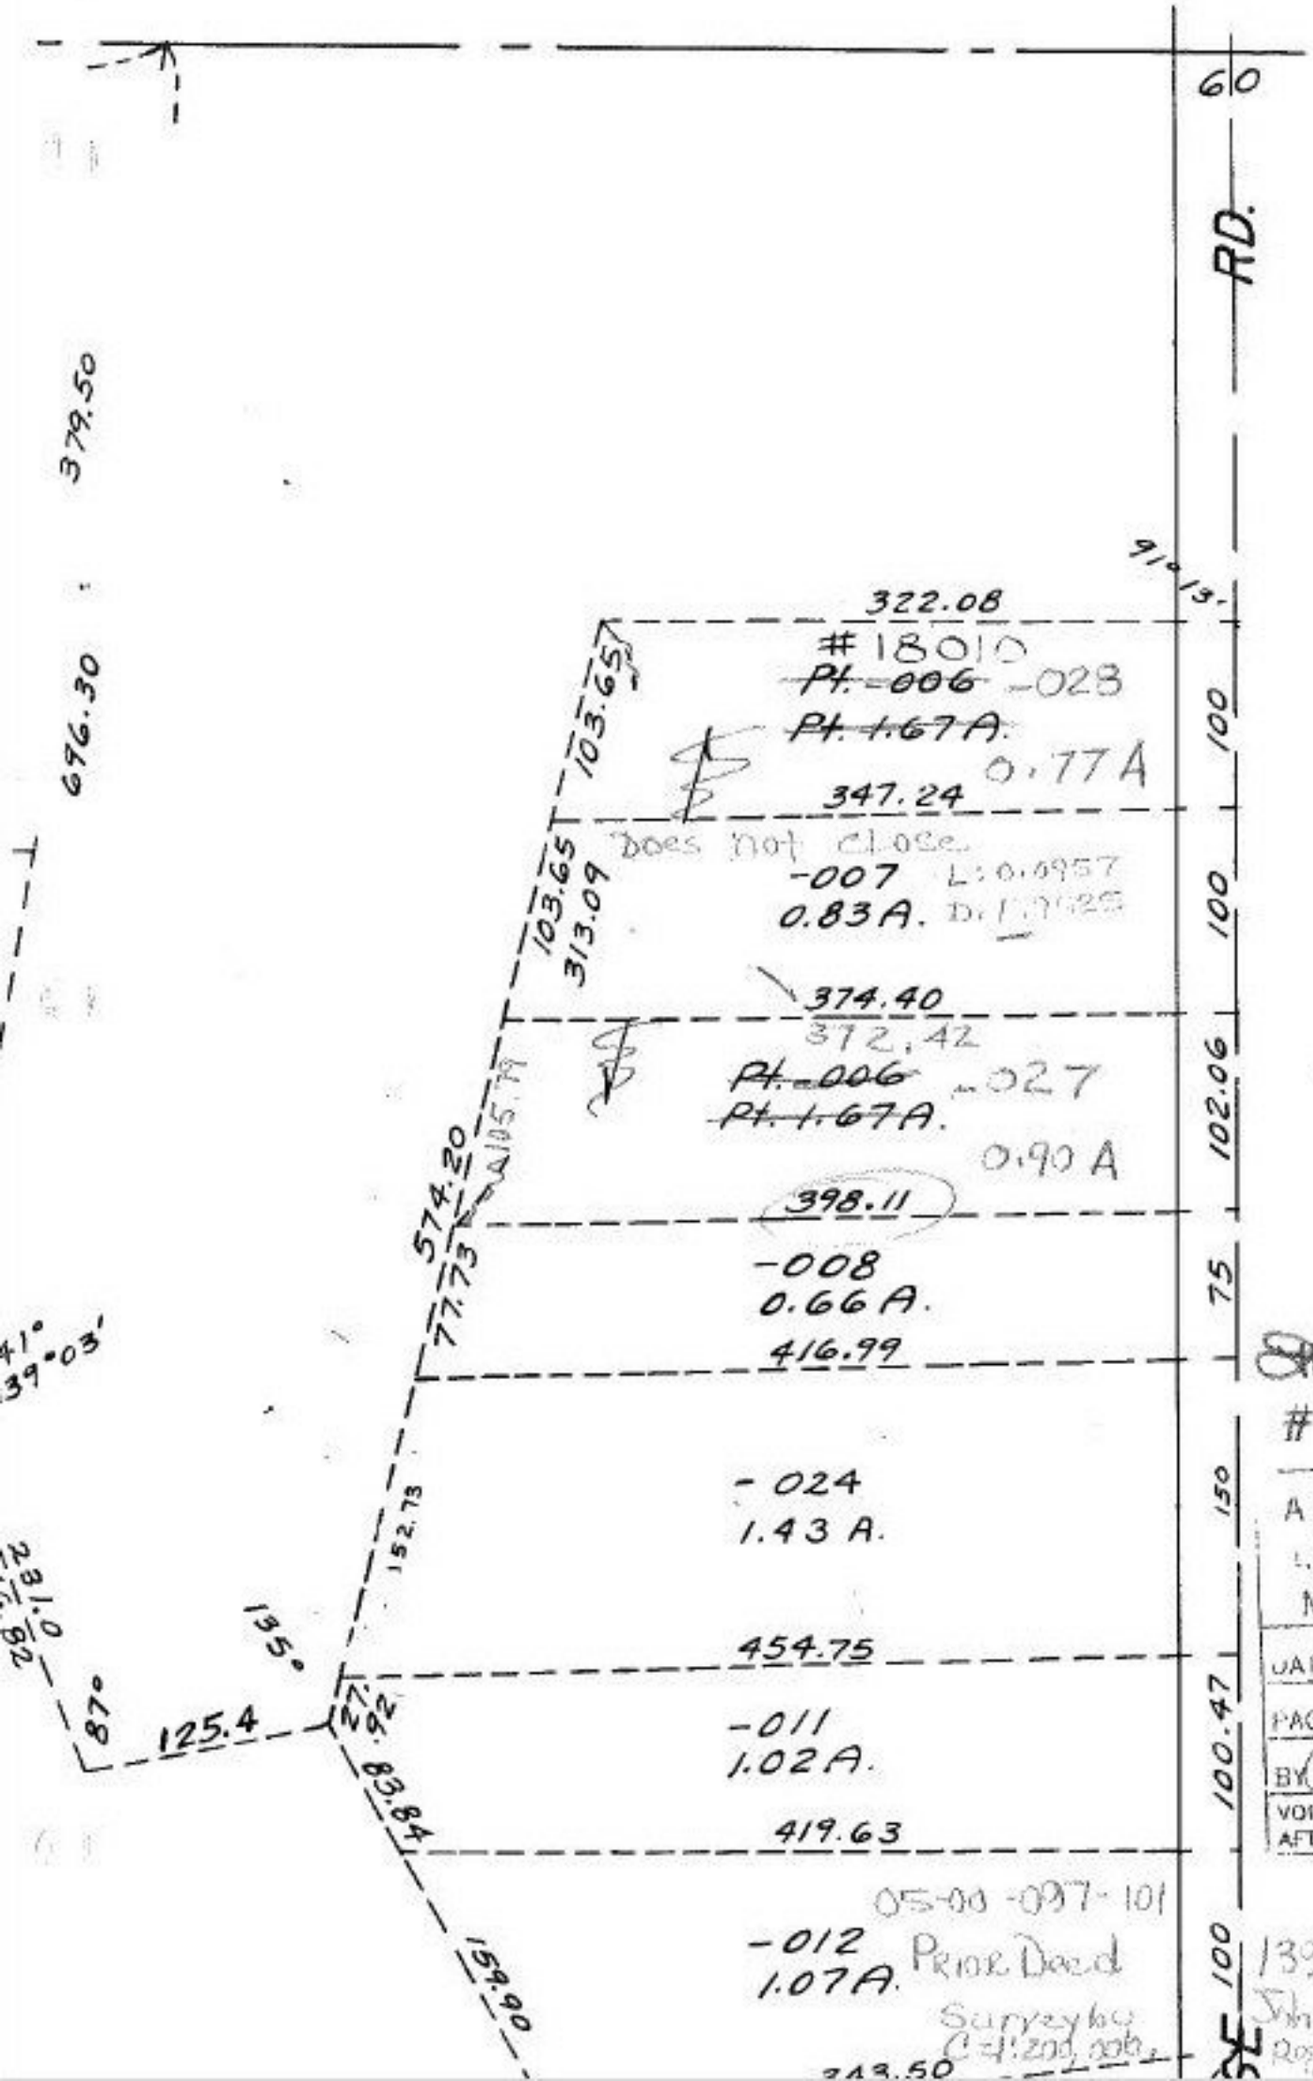
60
RD.
379.50
696.30
91°13'
322.08
#18010
~~Pt. -006~~ -028
~~Pt. 1.67A.~~
0.77A
100
347.24
Does not close
-007
0.83A.
100
374.40
372.42
~~Pt. -006~~ -027
~~Pt. 1.67A.~~
0.90 A
102.06
398.11
-008
0.66A.
75
416.99
-024
1.43 A.
150
454.75
-011
1.02A.
100.47
419.63
05-00-097-101
-012
1.07A.
Prior Deed
100
1390-66
John Porywak
Reg. Surveyor
343.50
103.65
103.65
313.09
574.20
77.73
152.73
135°
87°
125.4
27.92
83.84
159.90
41°
39°03'
231.0
1/31/89
#18010
APPROVED
LORAIN CO.
MAP DEPT.
DATE 6-28-88
PAGE 5-00-097-A
BY Carol Francis
VOID AFTER 18010