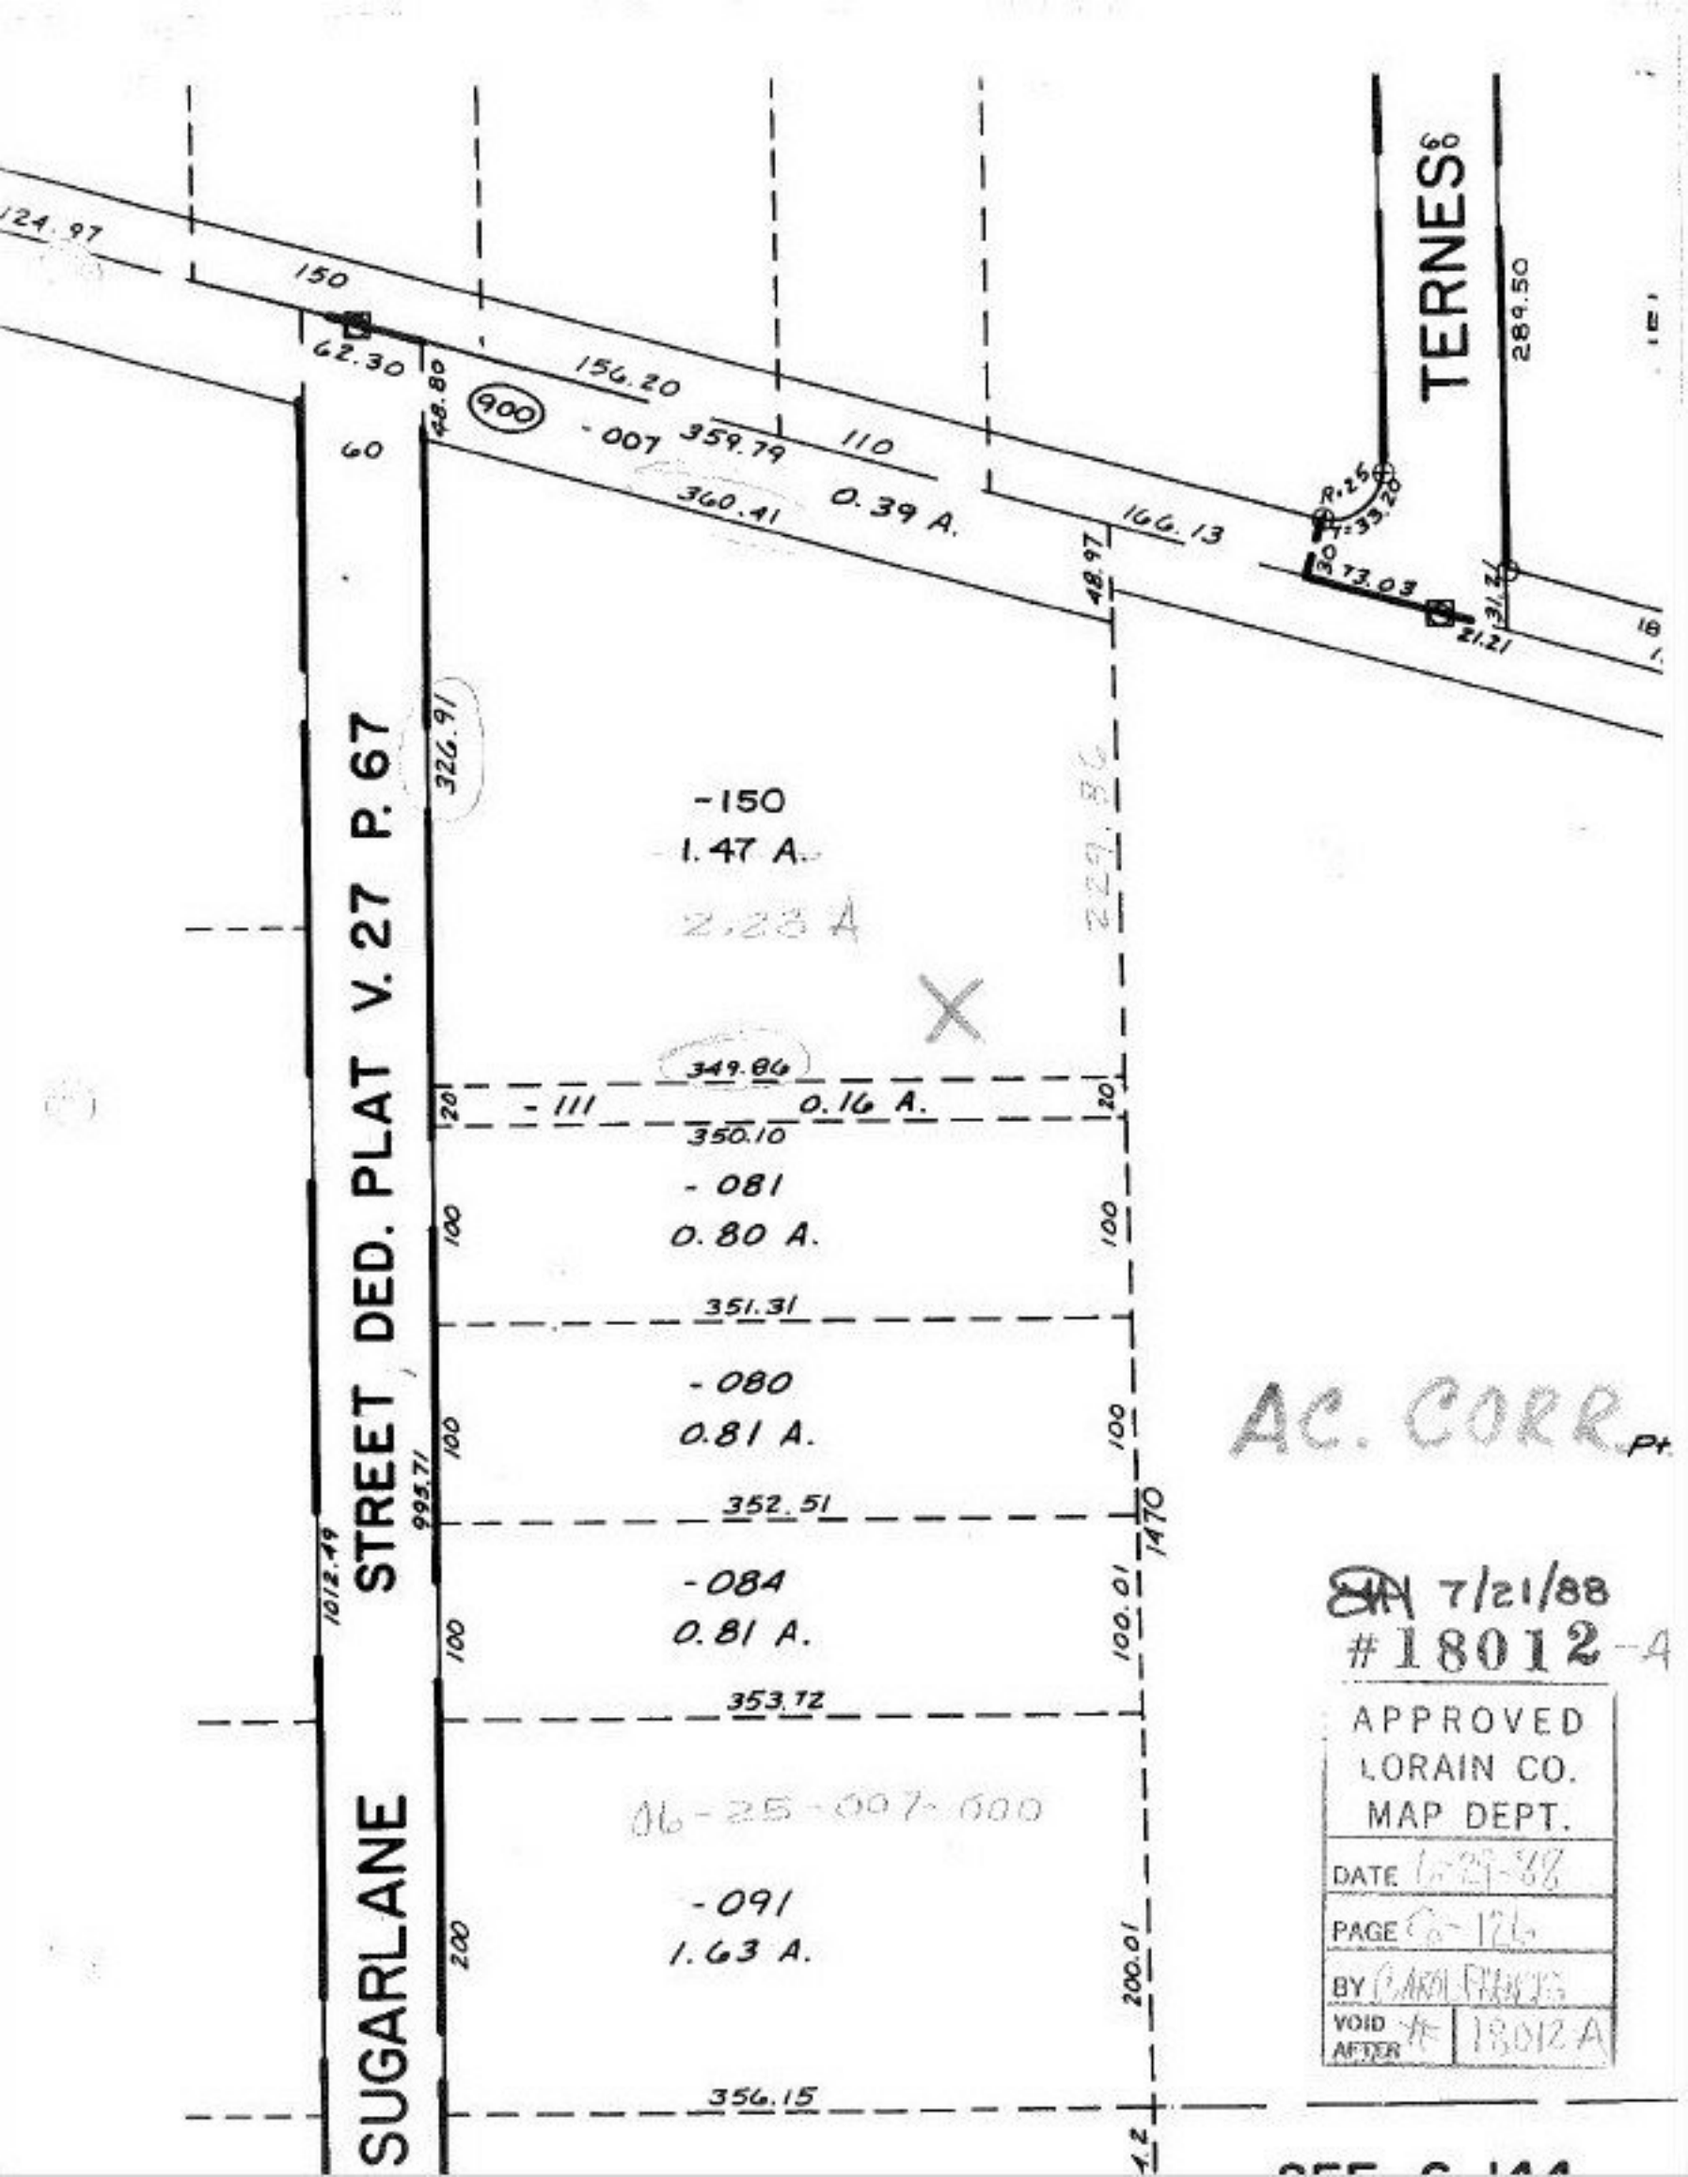

TERNES
SUGARLANE STREET DED. PLAT V. 27 P. 67
124.97
150
62.30
156.20
900
-007
359.79
110
360.41
0.39 A.
166.13
48.97
73.03
21.21
289.50
60
48.80
326.91
-150
1.47 A.
2.28 A
229.86
349.86
-111
0.16 A.
350.10
-081
0.80 A.
351.31
-080
0.81 A.
352.51
-084
0.81 A.
353.72
06-25-007-000
-091
1.63 A.
356.15
995.71
1012.49
1470
100.01
200.01
AC. CORR. Pt.
7/21/88
#18012-A
APPROVED
LORAIN CO.
MAP DEPT.
DATE 6-29-88
PAGE 6-126
BY CAROL FRANCIS
VOID AFTER 18012 A