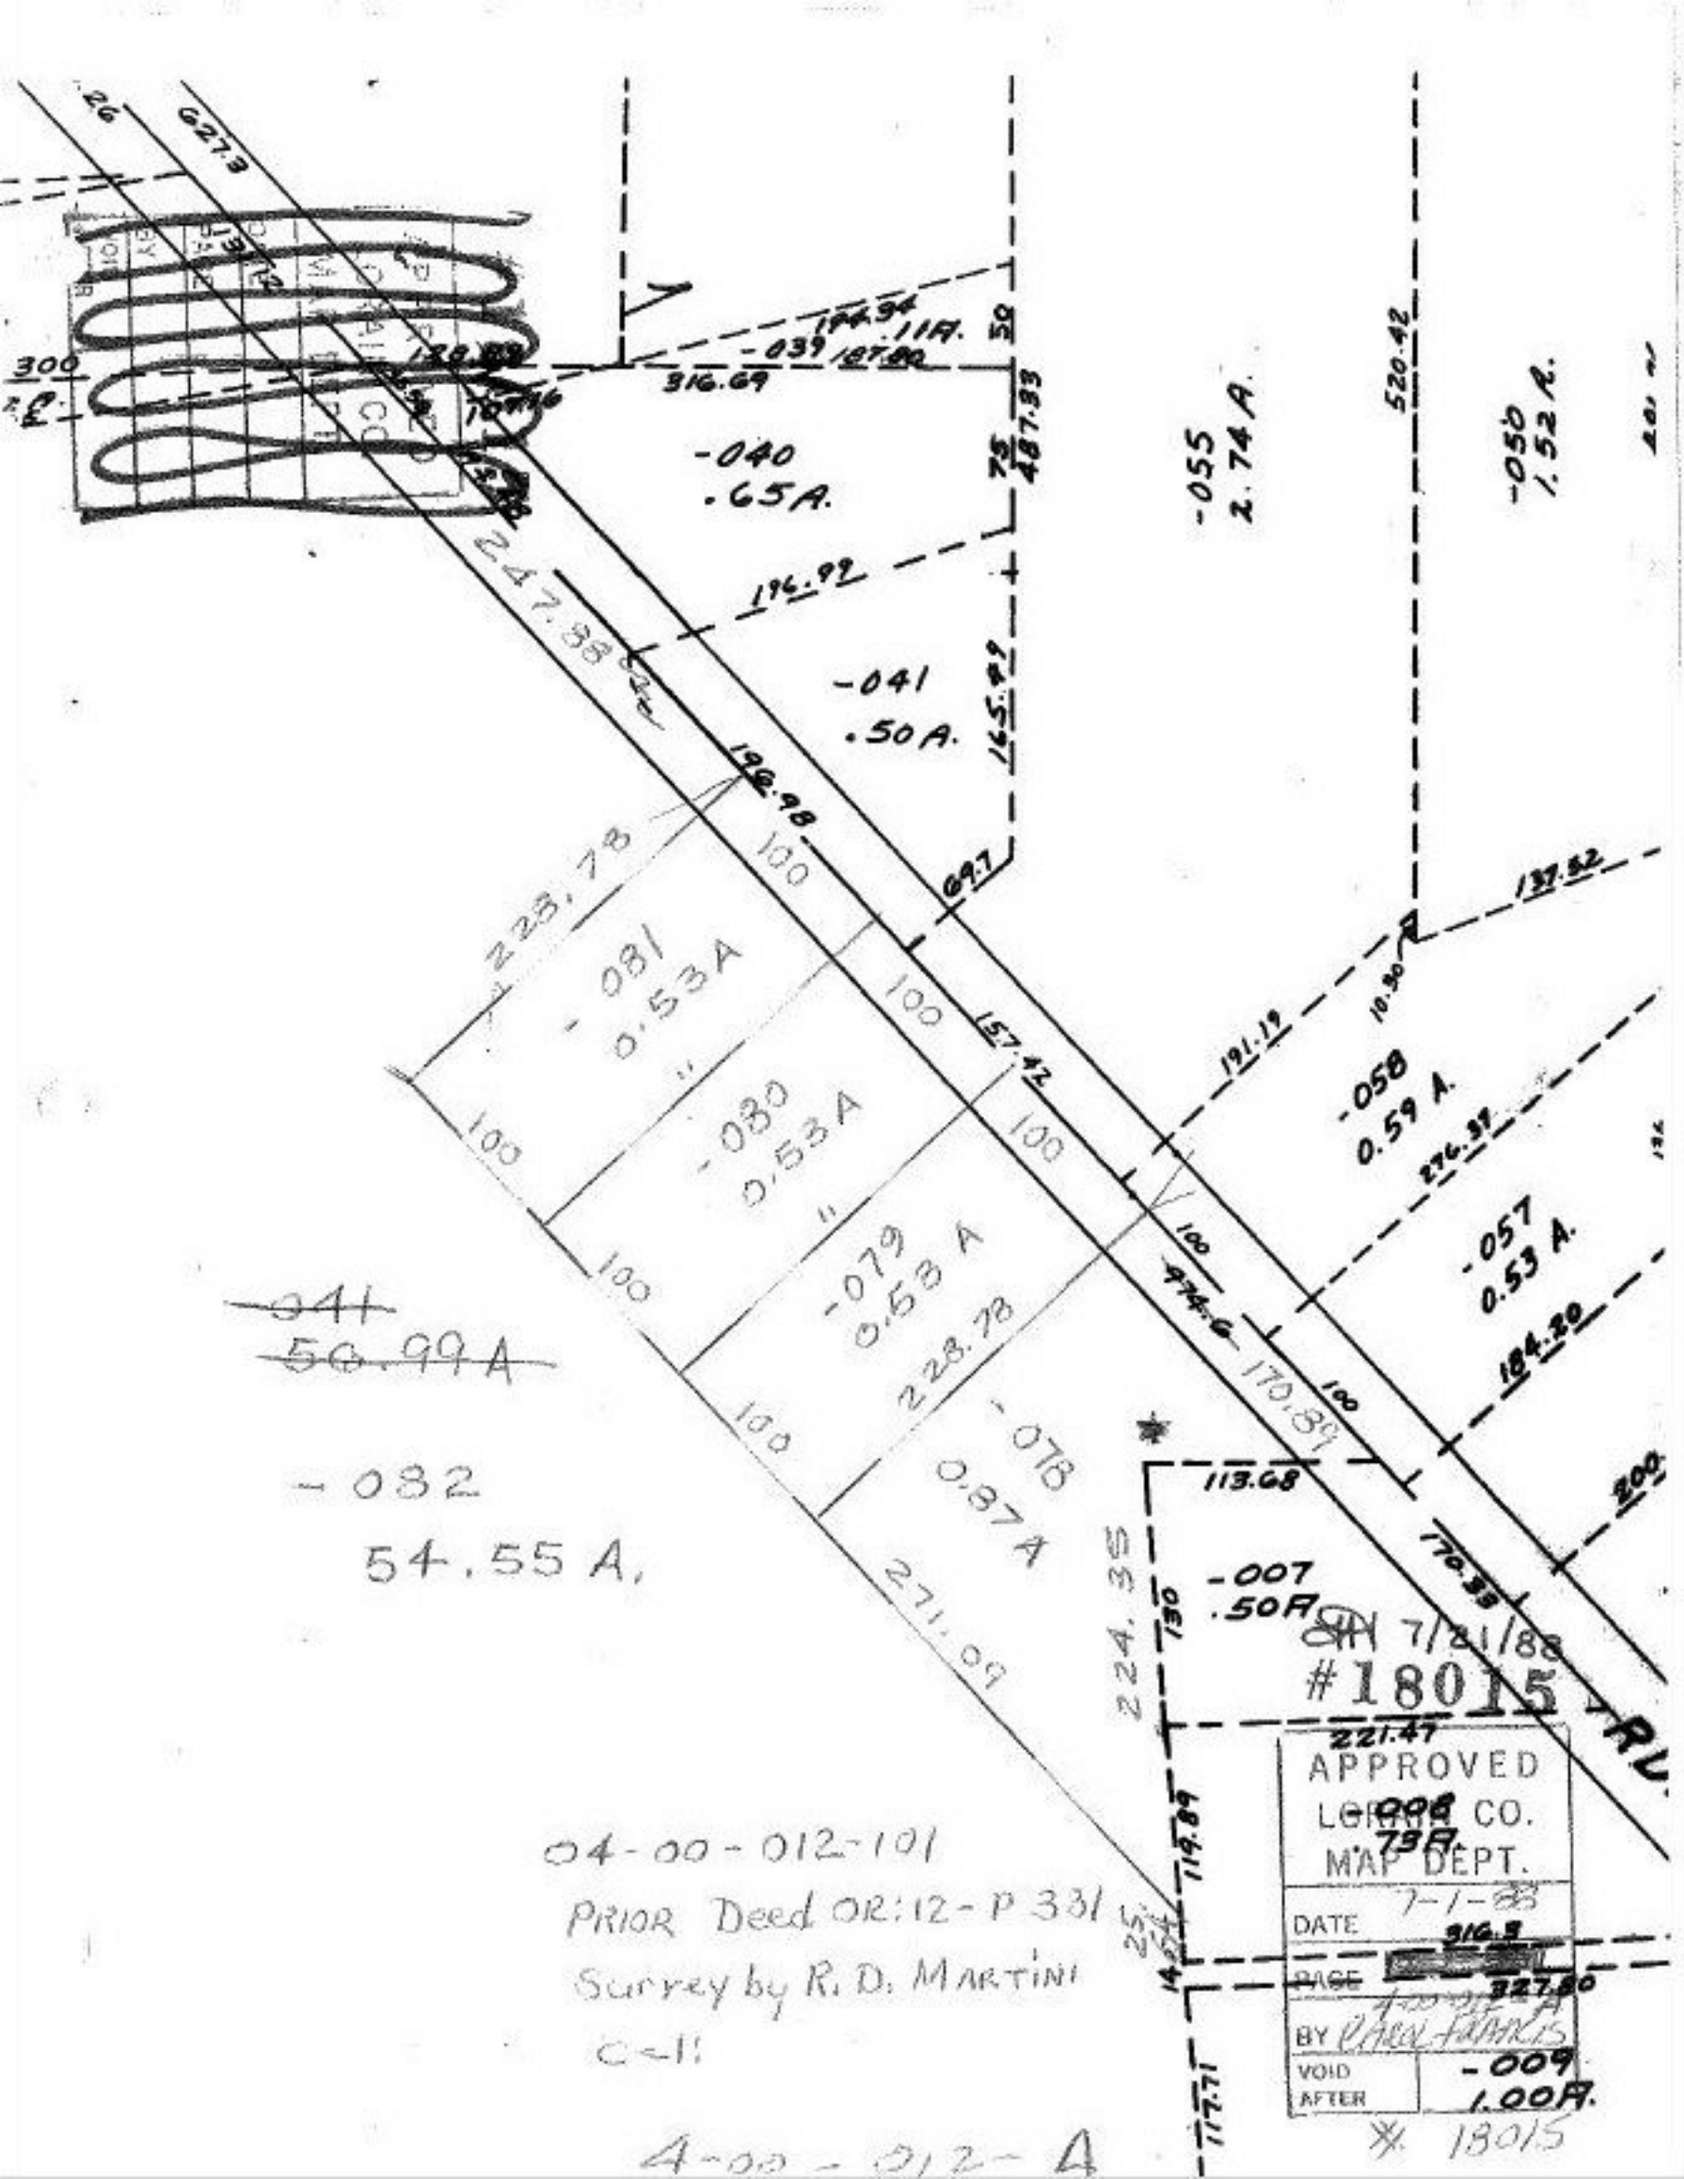

~~041~~
~~50.99A~~

-032
54.55 A.

#18015

04-00-012-101
PRIOR Deed OR:12-P 331
Survey by R. D. MARTINI
C-1!

4-00-012-A