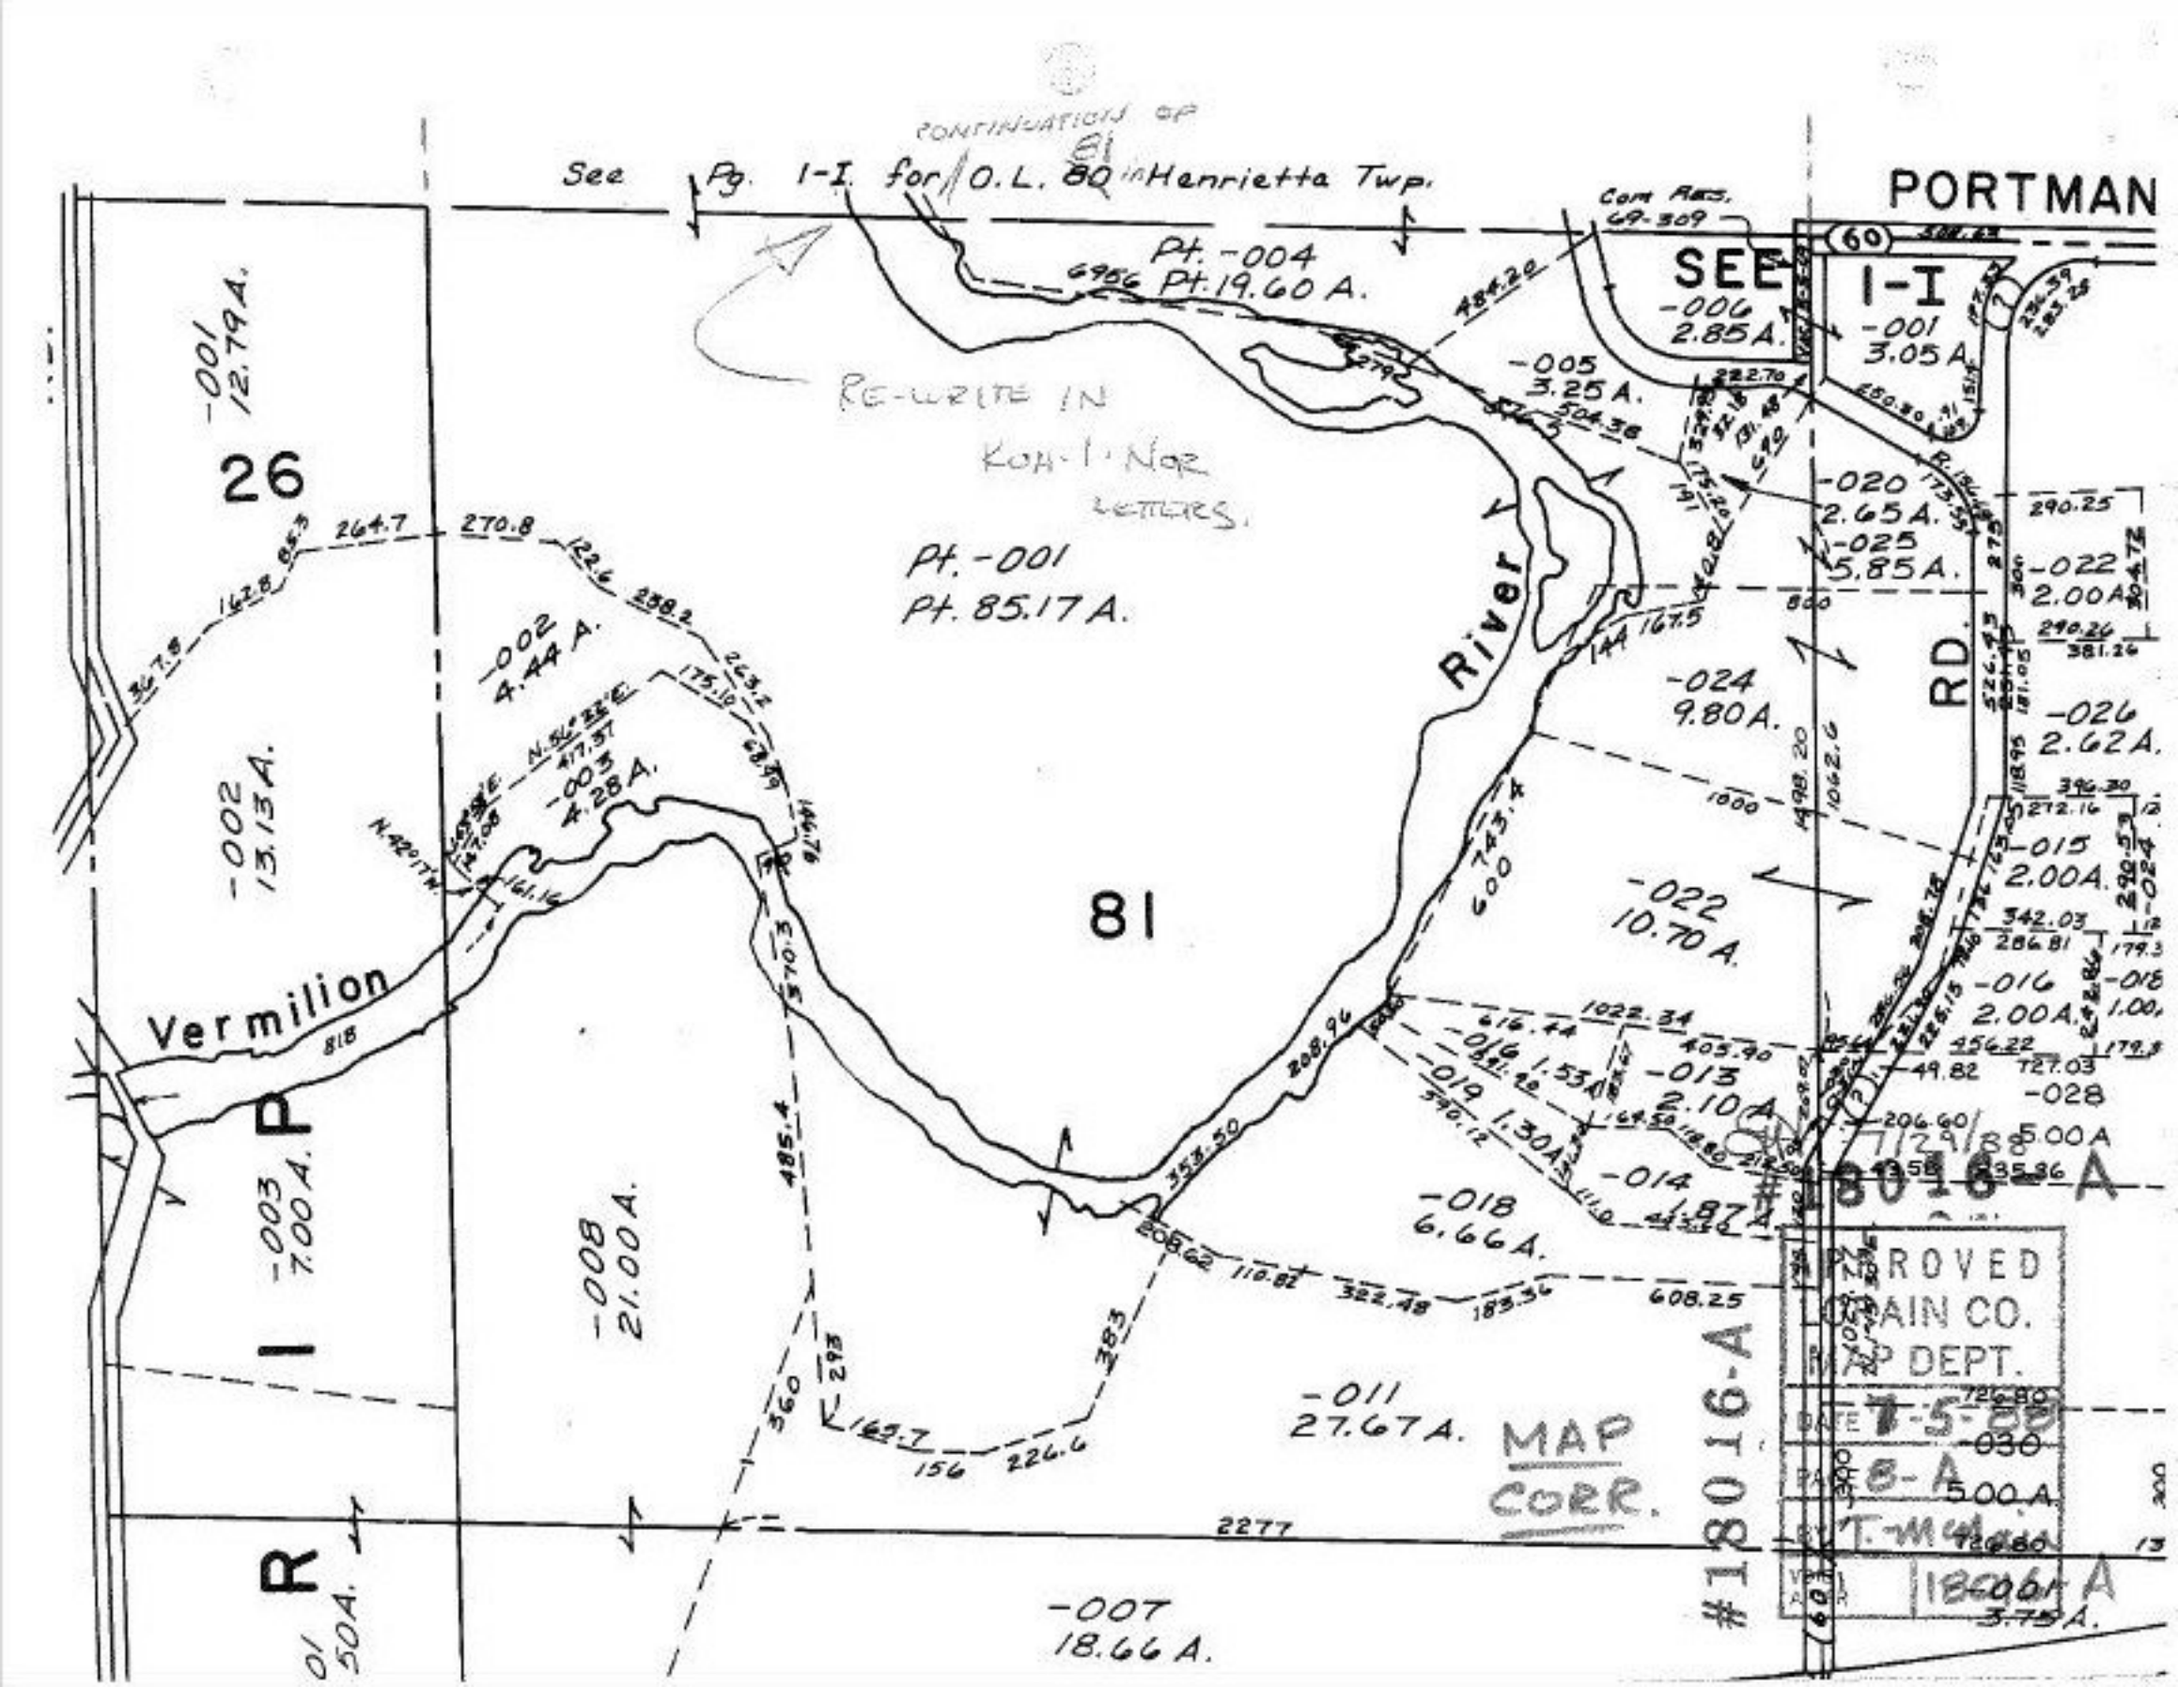

See Pg. 1-I for O.L. 80 in Henrietta Twp.
CONTINUATION OF 81
PORTMAN
SEE 1-I
Com Res. 69-309
Pt. -004
Pt. 19.60 A.
RE-WRITE IN KOH-I-NOR LETTERS.
Pt. -001
Pt. 85.17 A.
26
81
Vermilion
River
RD.
-001 12.79 A.
-002 13.13 A.
-003 7.00 A.
-002 4.44 A.
-003 4.28 A.
-008 21.00 A.
-005 3.25 A.
-006 2.85 A.
-001 3.05 A.
-020 2.65 A.
-025 5.85 A.
-022 2.00 A.
-024 9.80 A.
-026 2.62 A.
-015 2.00 A.
-022 10.70 A.
-016 2.00 A.
-013 2.10 A.
-028 5.00 A.
-018 6.66 A.
-014 1.87 A.
-011 27.67 A.
-007 18.66 A.
-030 5.00 A.
-001 3.75 A.
MAP CORR.
#18016-A
#18016-A
IMPROVED LORAIN CO. MAP DEPT.
DATE 7-5-88
PAGE 8-A
BY T. McMain
VOL. 1 PAGE 18016-A