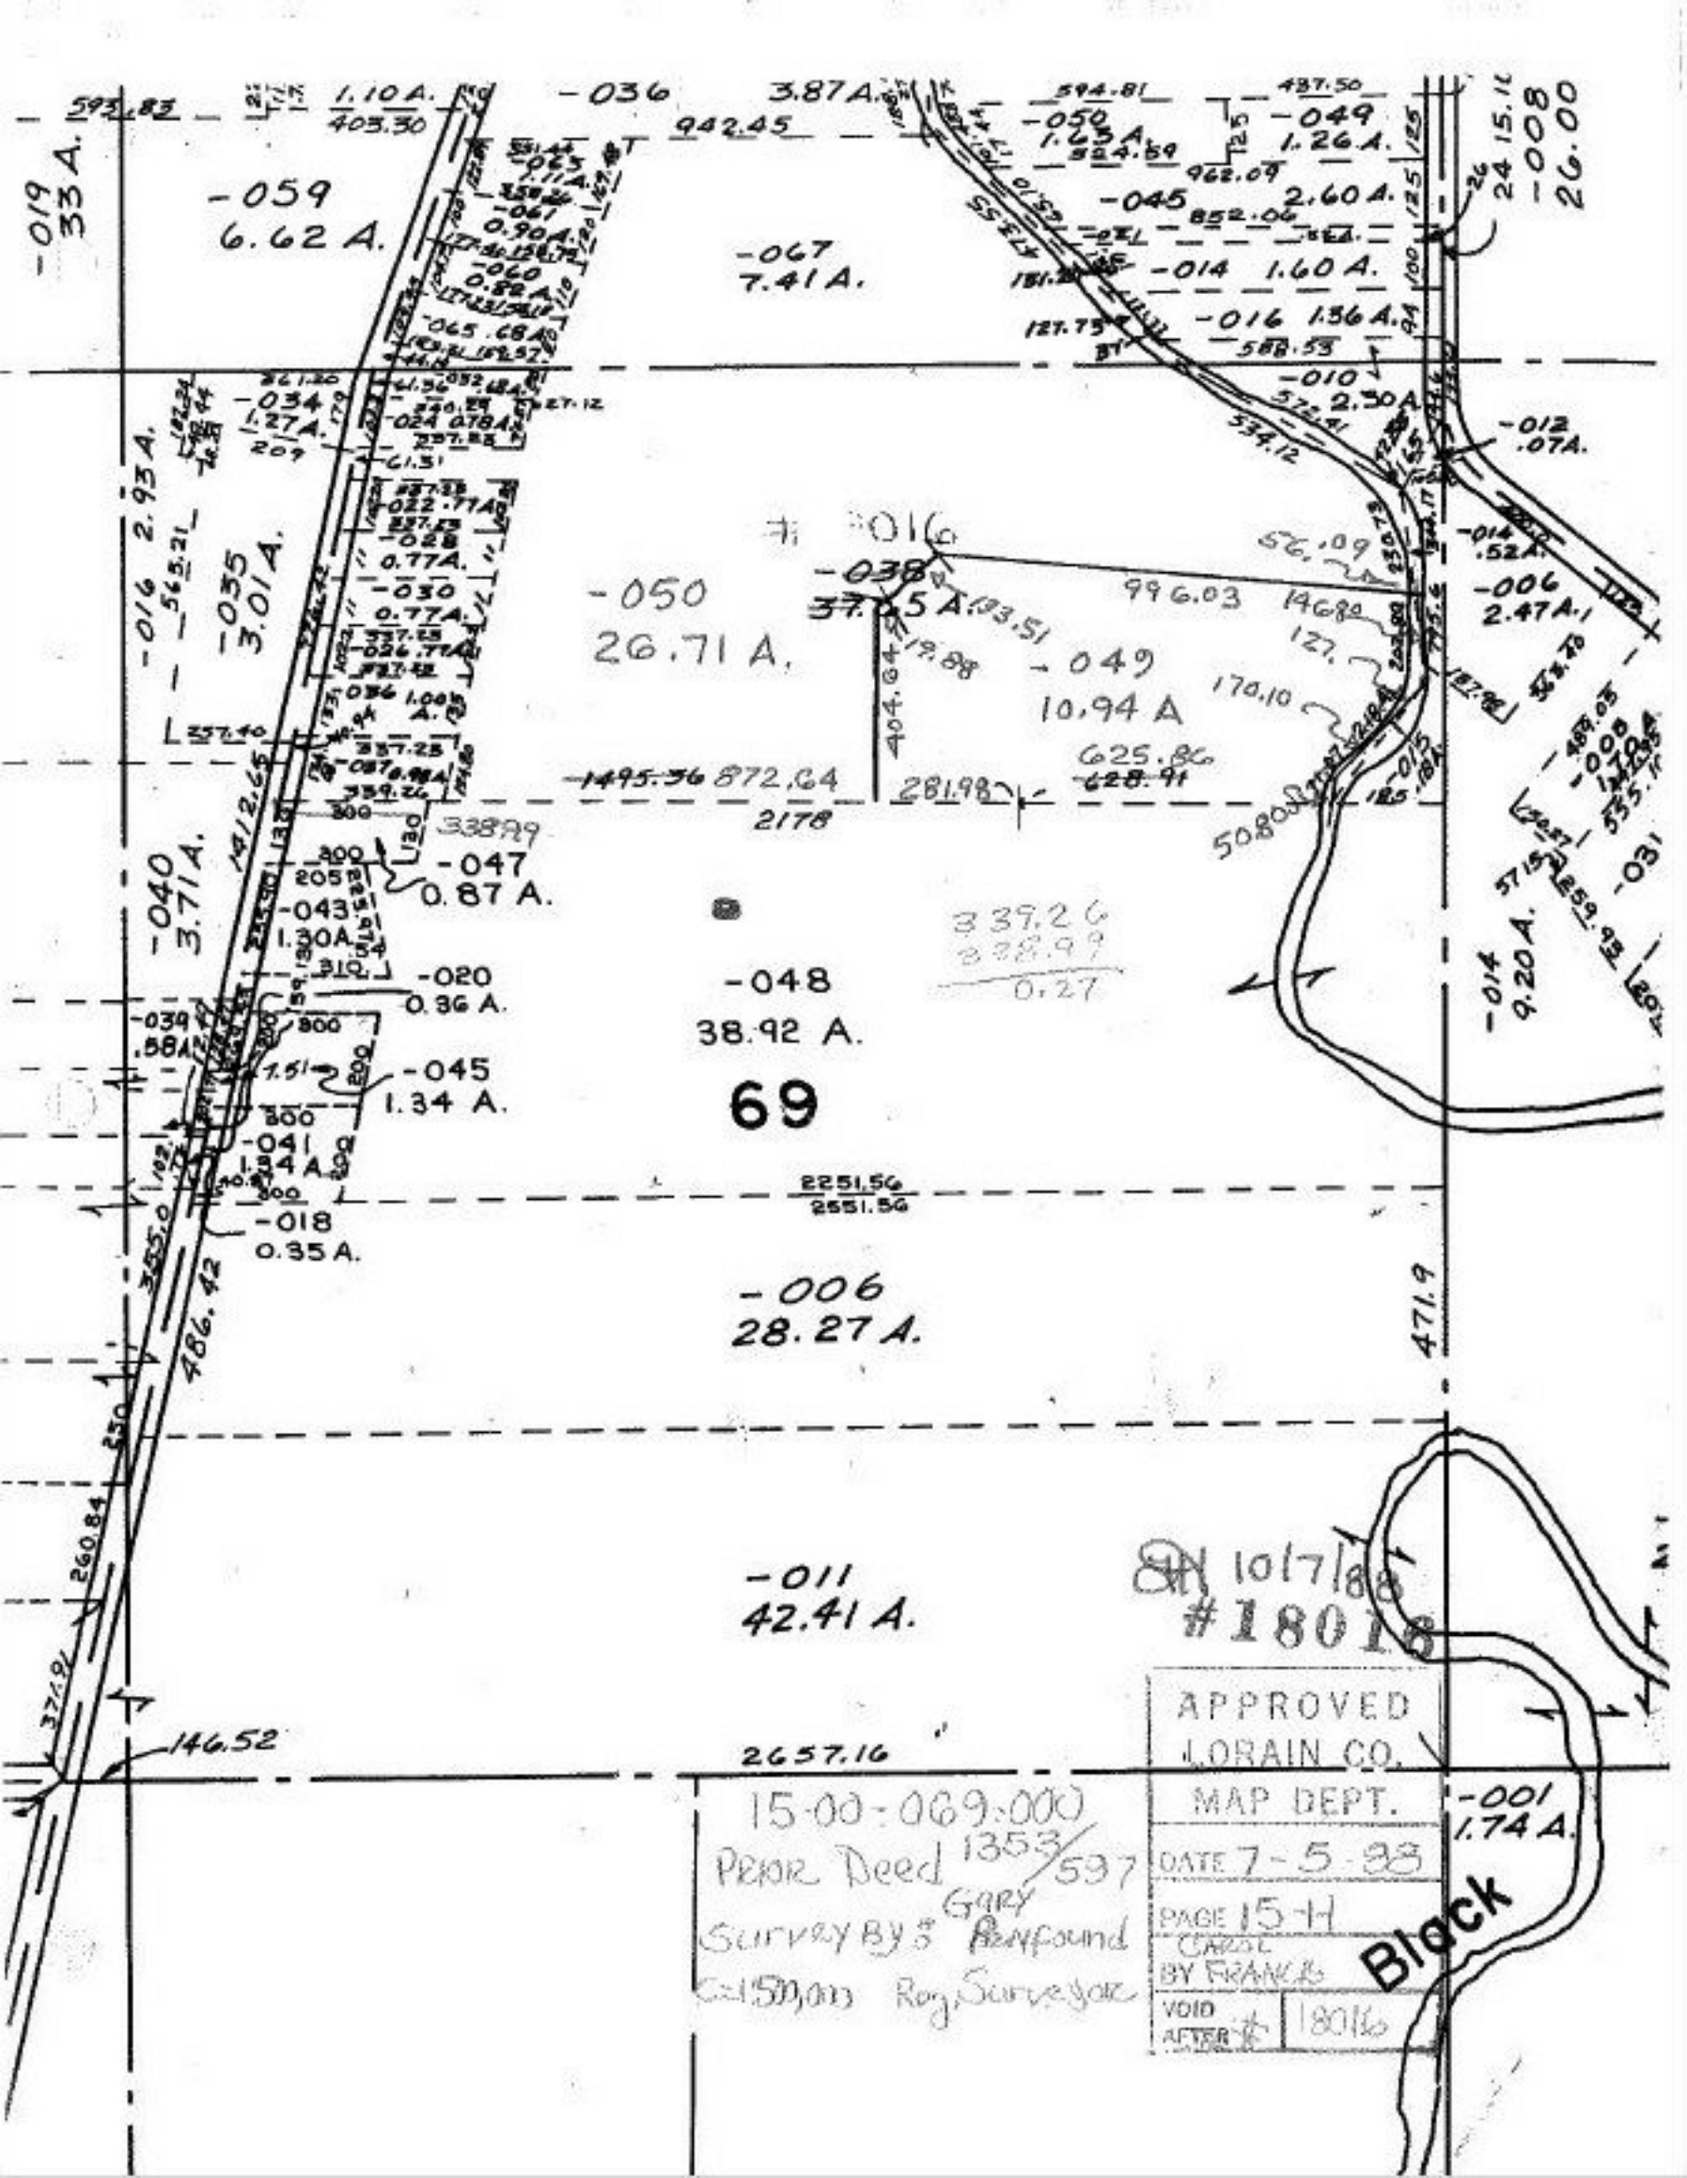

-019 33 A.
-059 6.62 A.
-036 3.87 A.
-067 7.41 A.
-050 26.71 A.
-049 10.94 A
-038 37.05 A.
-035 3.01 A.
-040 3.71 A.
-047 0.87 A.
-043 1.30 A.
-020 0.36 A.
-045 1.34 A.
-041 1.34 A.
-018 0.35 A.
-048 38.92 A.
69
-006 28.27 A.
-011 42.41 A.
-014 9.20 A.
-006 2.47 A.
-012 .07 A.
-010 2.30 A.
-016 1.36 A.
-014 1.60 A.
-045 2.60 A.
-049 1.26 A.
-050 1.63 A.
-008 26.00
-001 1.74 A.
Block
2251.56
2551.56
2657.16
146.52
471.9
486.42
2178
1495.36
872.64
281.98
625.86
628.91
996.03
146.80
170.10
56.09
339.26
338.99
0.27
10/7/88
#18016
APPROVED
LORAIN CO.
MAP DEPT.
DATE 7-5-88
PAGE 15-H
CAROL
BY FRANCIS
VOID AFTER # 18016
15-00-069-000
PRIOR Deed 1353/597
Survey By: Gary Penfound
C=1:500,000 Reg. Surveyor