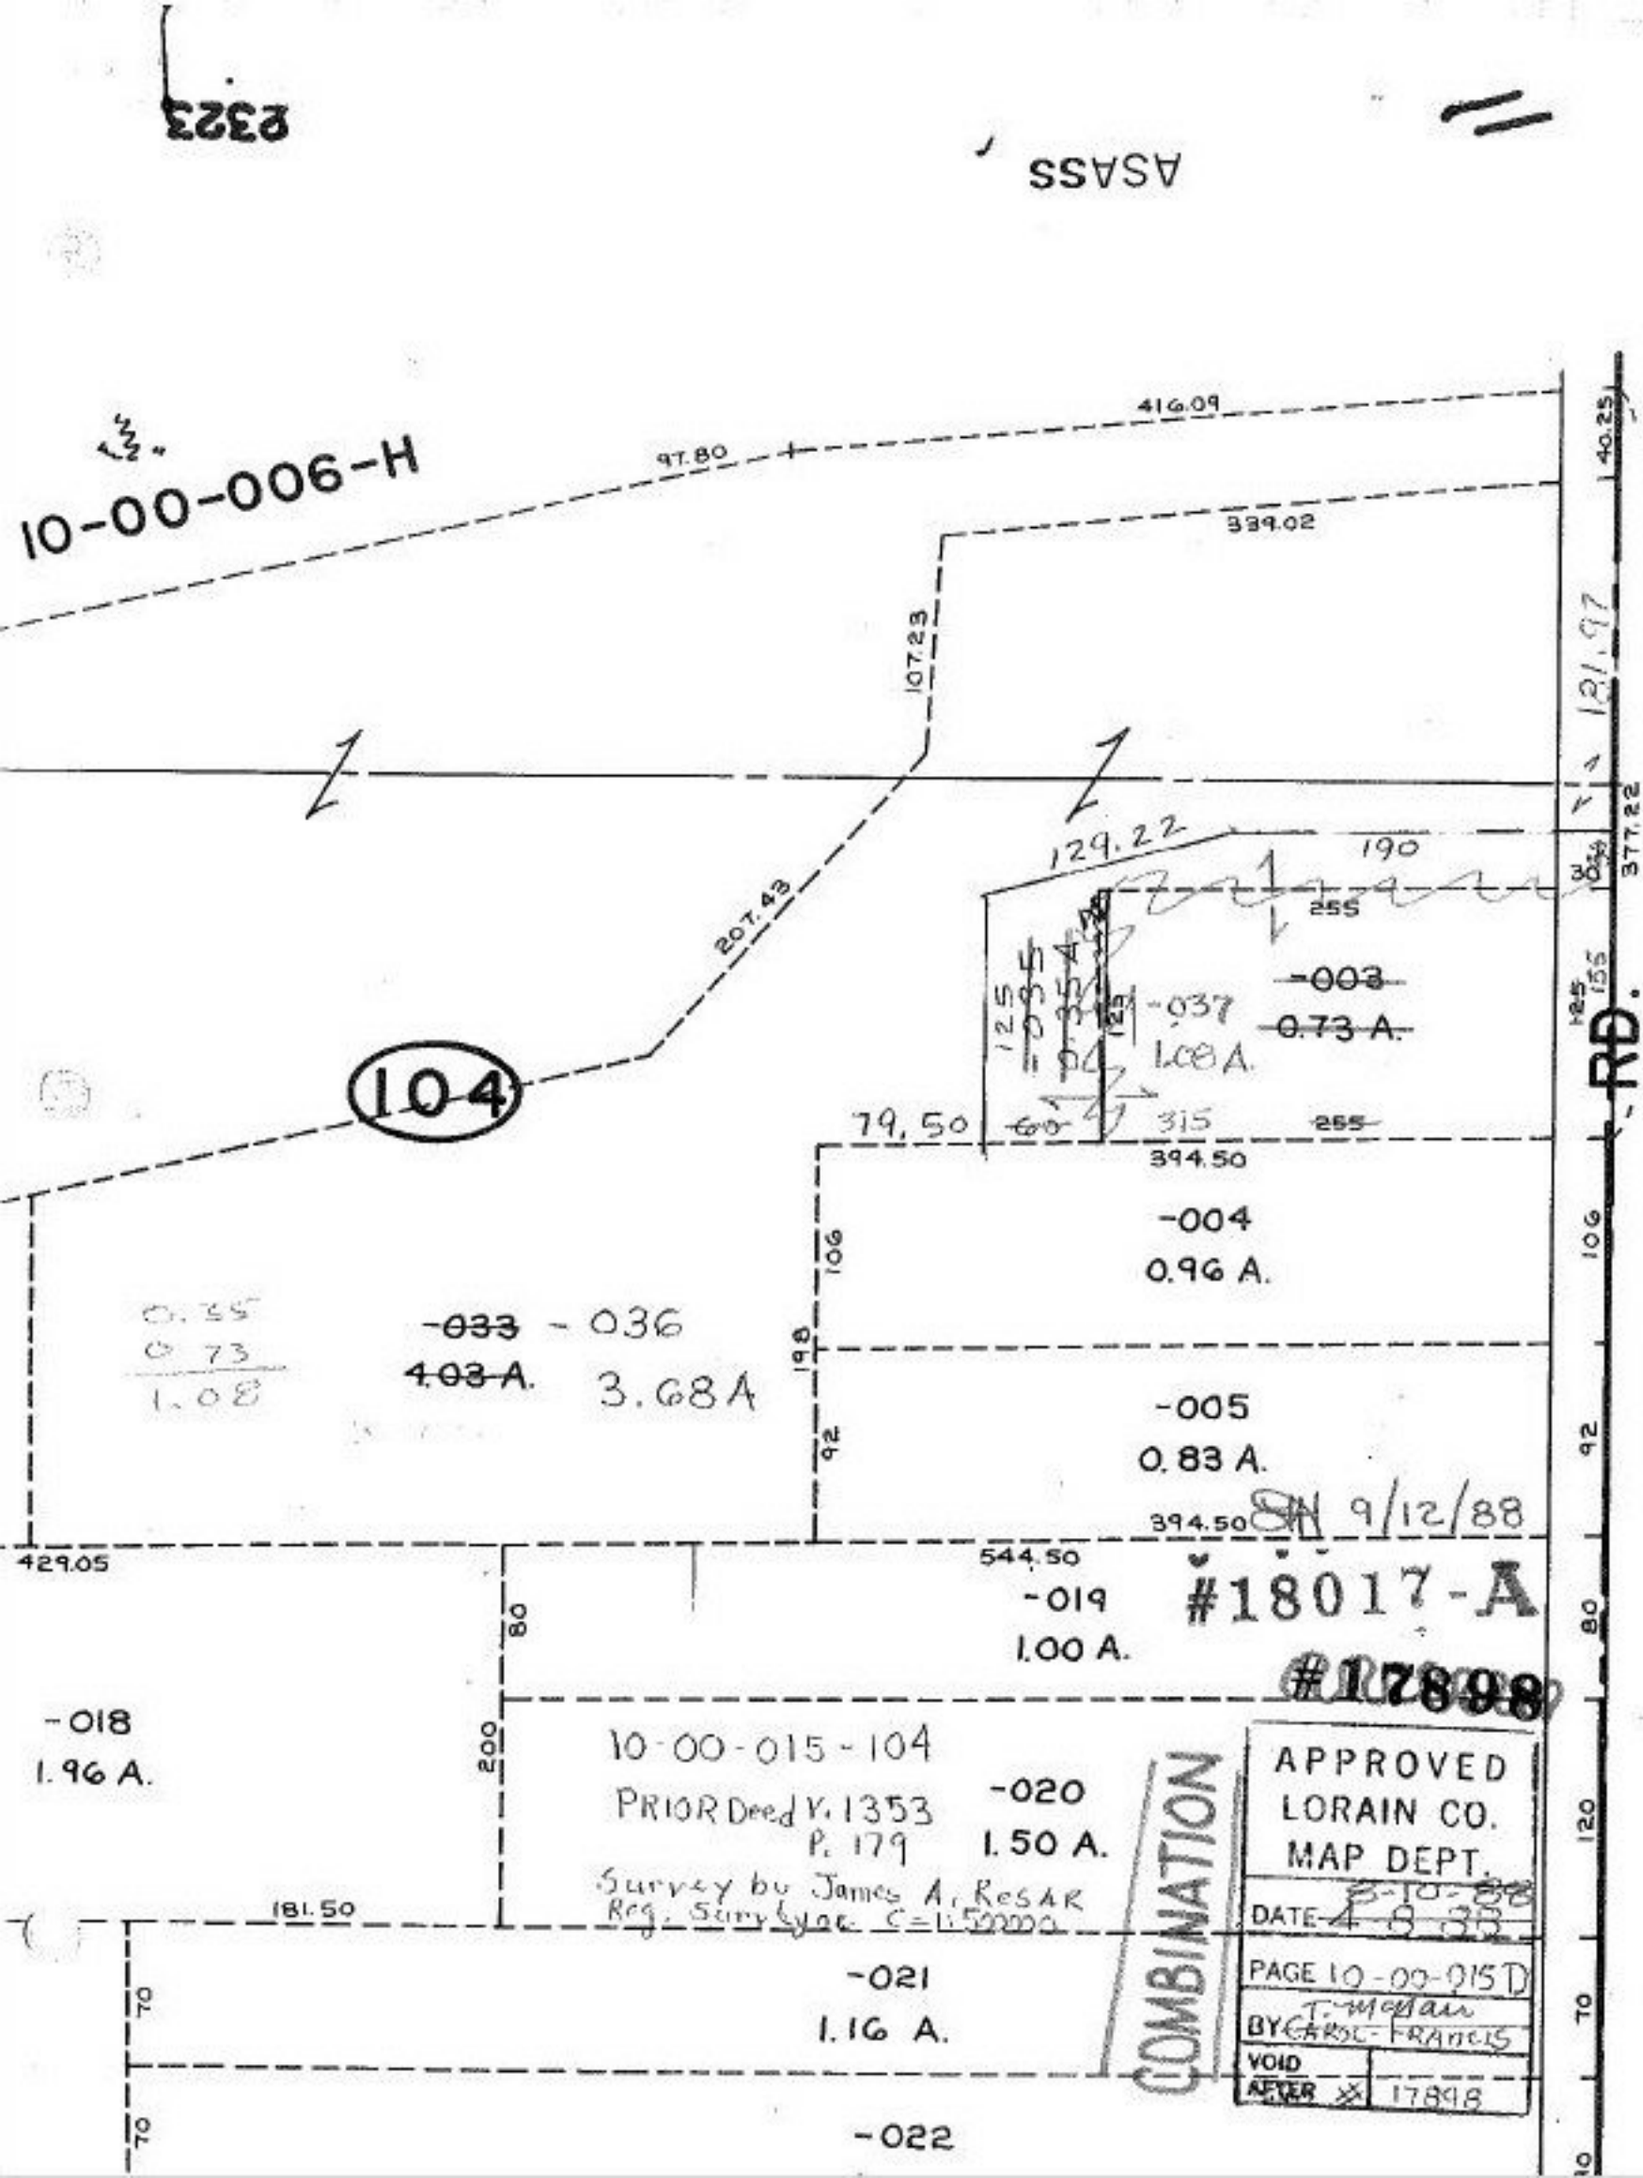
10-00-006-H
416.09
97.80
339.02
107.23
207.43
129.22
190
255
-003
0.73 A.
-037
1.08 A.
125
155
377.22
121.97
RD.
104
79.50
315
394.50
-004
0.96 A.
106
198
92
0.55
0.73
1.08
-033
4.03 A.
-036
3.68 A
-005
0.83 A.
394.50
9/12/88
429.05
544.50
-019
1.00 A.
#18017-A
#17898
80
-018
1.96 A.
200
10-00-015-104
PRIOR Deed V. 1353
P. 179
Survey by James A. Resar
Reg. Surveyor C=1.52000
-020
1.50 A.
181.50
-021
1.16 A.
70
-022
120
COMBINATION
APPROVED
LORAIN CO.
MAP DEPT.
DATE 4-8-88
8-10-88
PAGE 10-00-015D
BY GARSC-FRANCIS
T. McClain
VOID
AFTER
17898