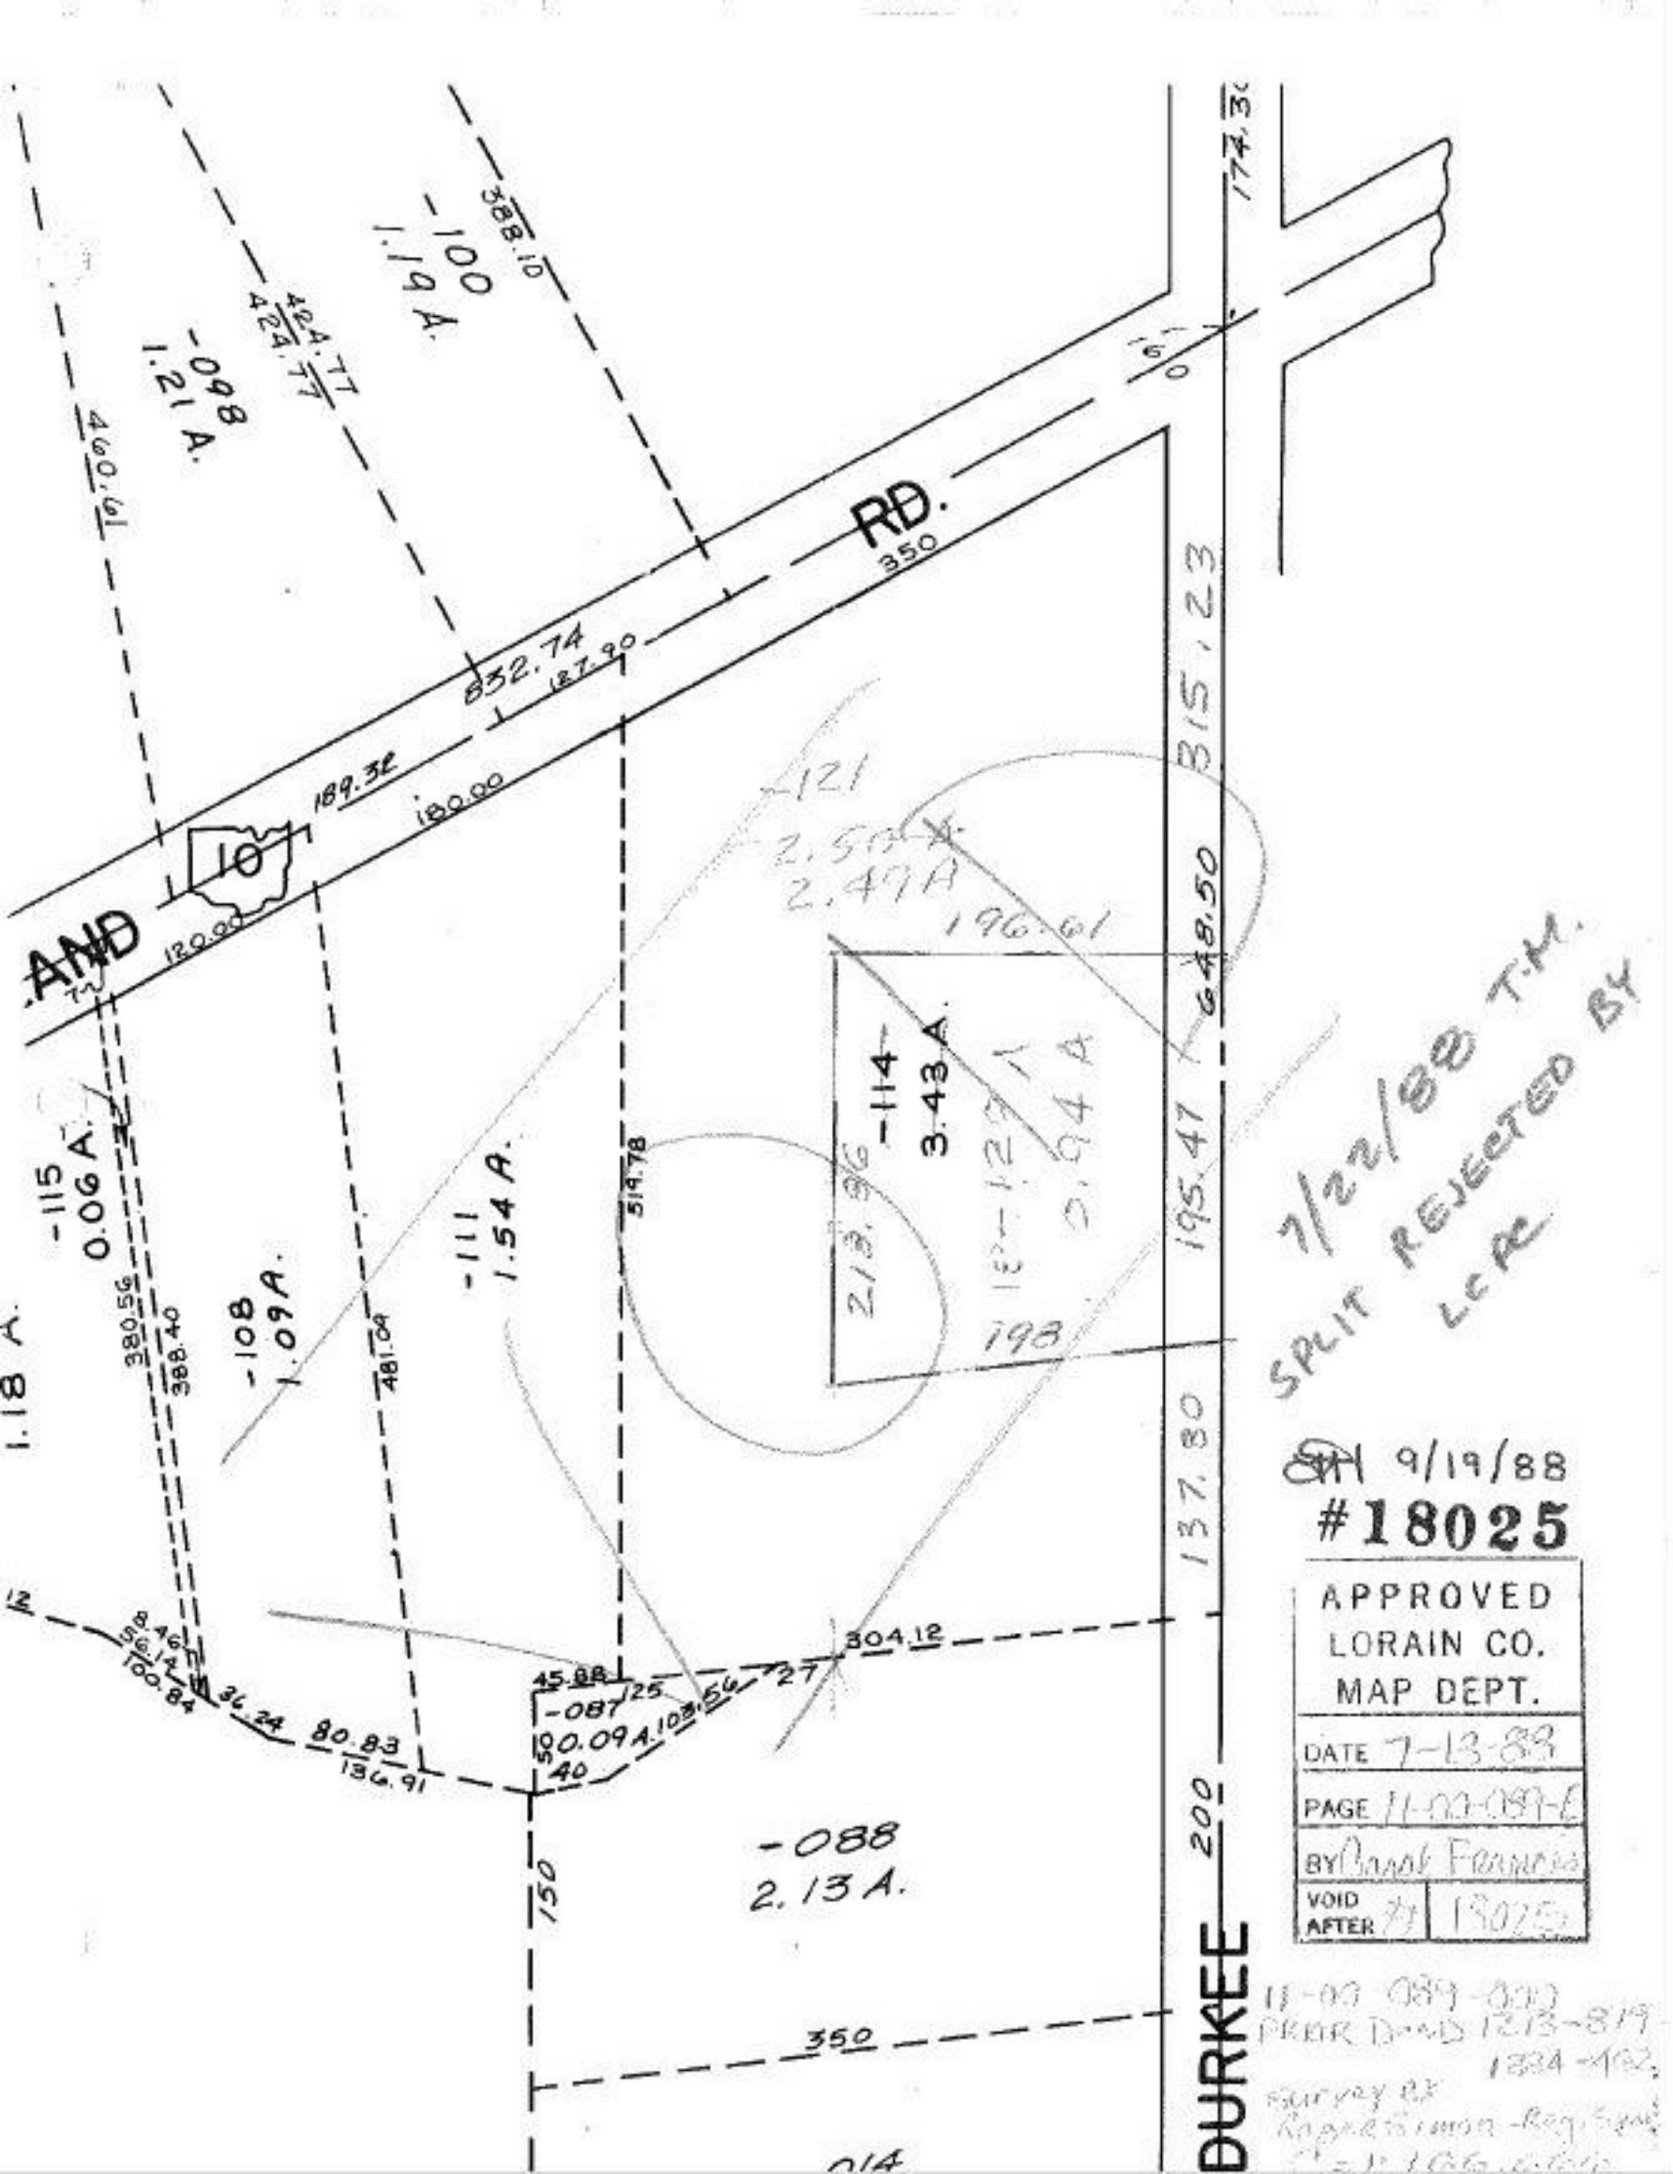
RD.
350
AND
10
120.00
189.32
180.00
852.74
187.90
388.10
424.77
424.77
460.61
-100
1.19 A.
-098
1.21 A.
-121
2.50 A.
2.47 A
196.61
648.50
815.23
-114
3.43 A.
213.96
198
195.47
-115
0.06 A.
-111
1.54 A.
514.78
-108
1.09 A.
380.56
388.40
481.04
1.18 A.
137.80
304.12
45.88
-087
0.09 A.
108.56
27
36.24
80.83
136.91
40
150
-088
2.13 A.
200
350
DURKEE
7/22/88 T.M.
SPLIT REJECTED BY
LCAC
9/19/88
#18025
APPROVED
LORAIN CO.
MAP DEPT.
DATE 7-13-88
PAGE 11-00-089-E
BY Carol Fournier
VOID
AFTER 7/ 18025
11-00-089-000
PRIOR D.N.D 1213-819
1334-192
survey of
Representation-Registered