SEE 12-00-043-A

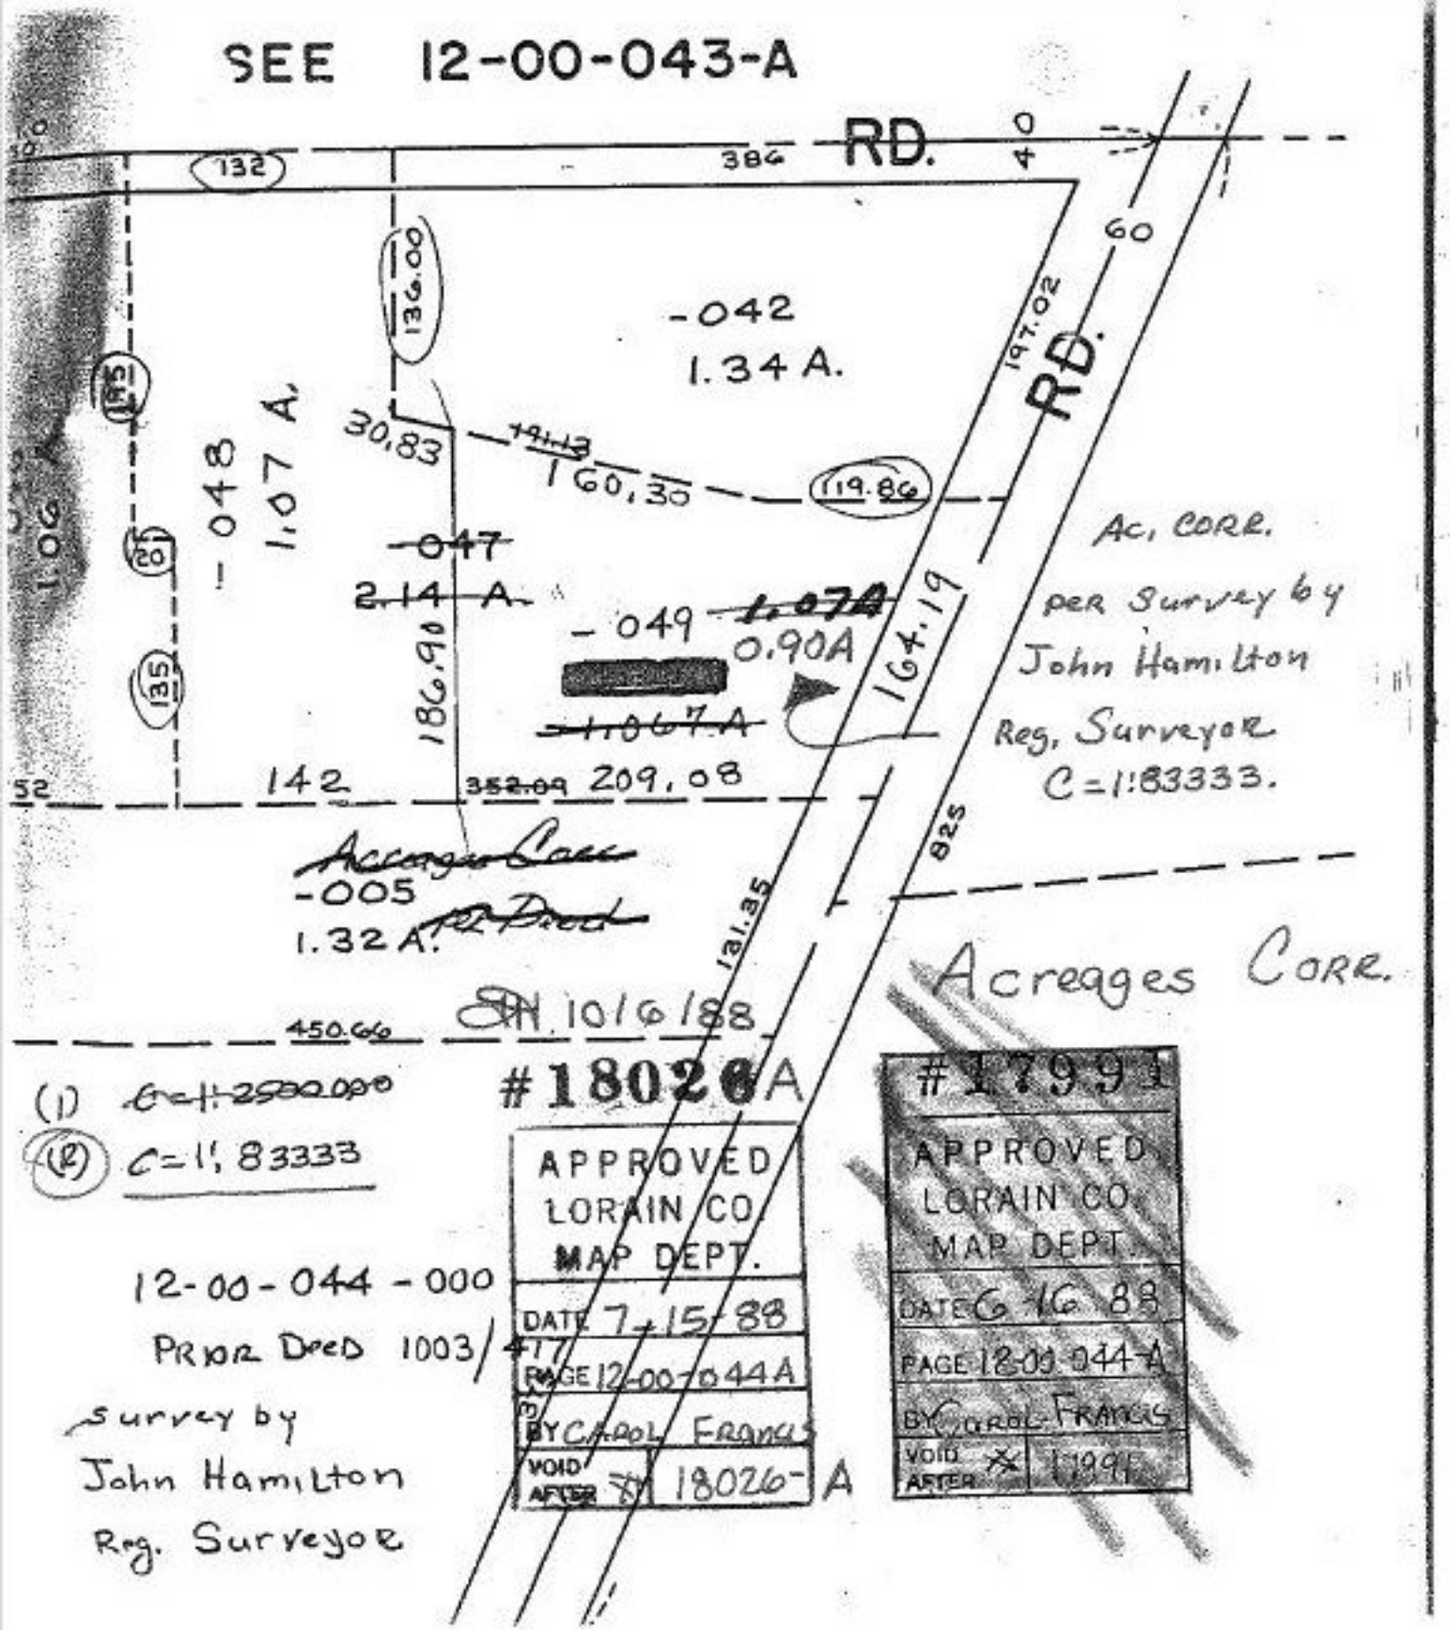

(1) ~~C=1:2500.000~~

(2) C=1:83333

12-00-044-000

PRIOR DEED 1003/477

Survey by
John Hamilton
Reg. Surveyor