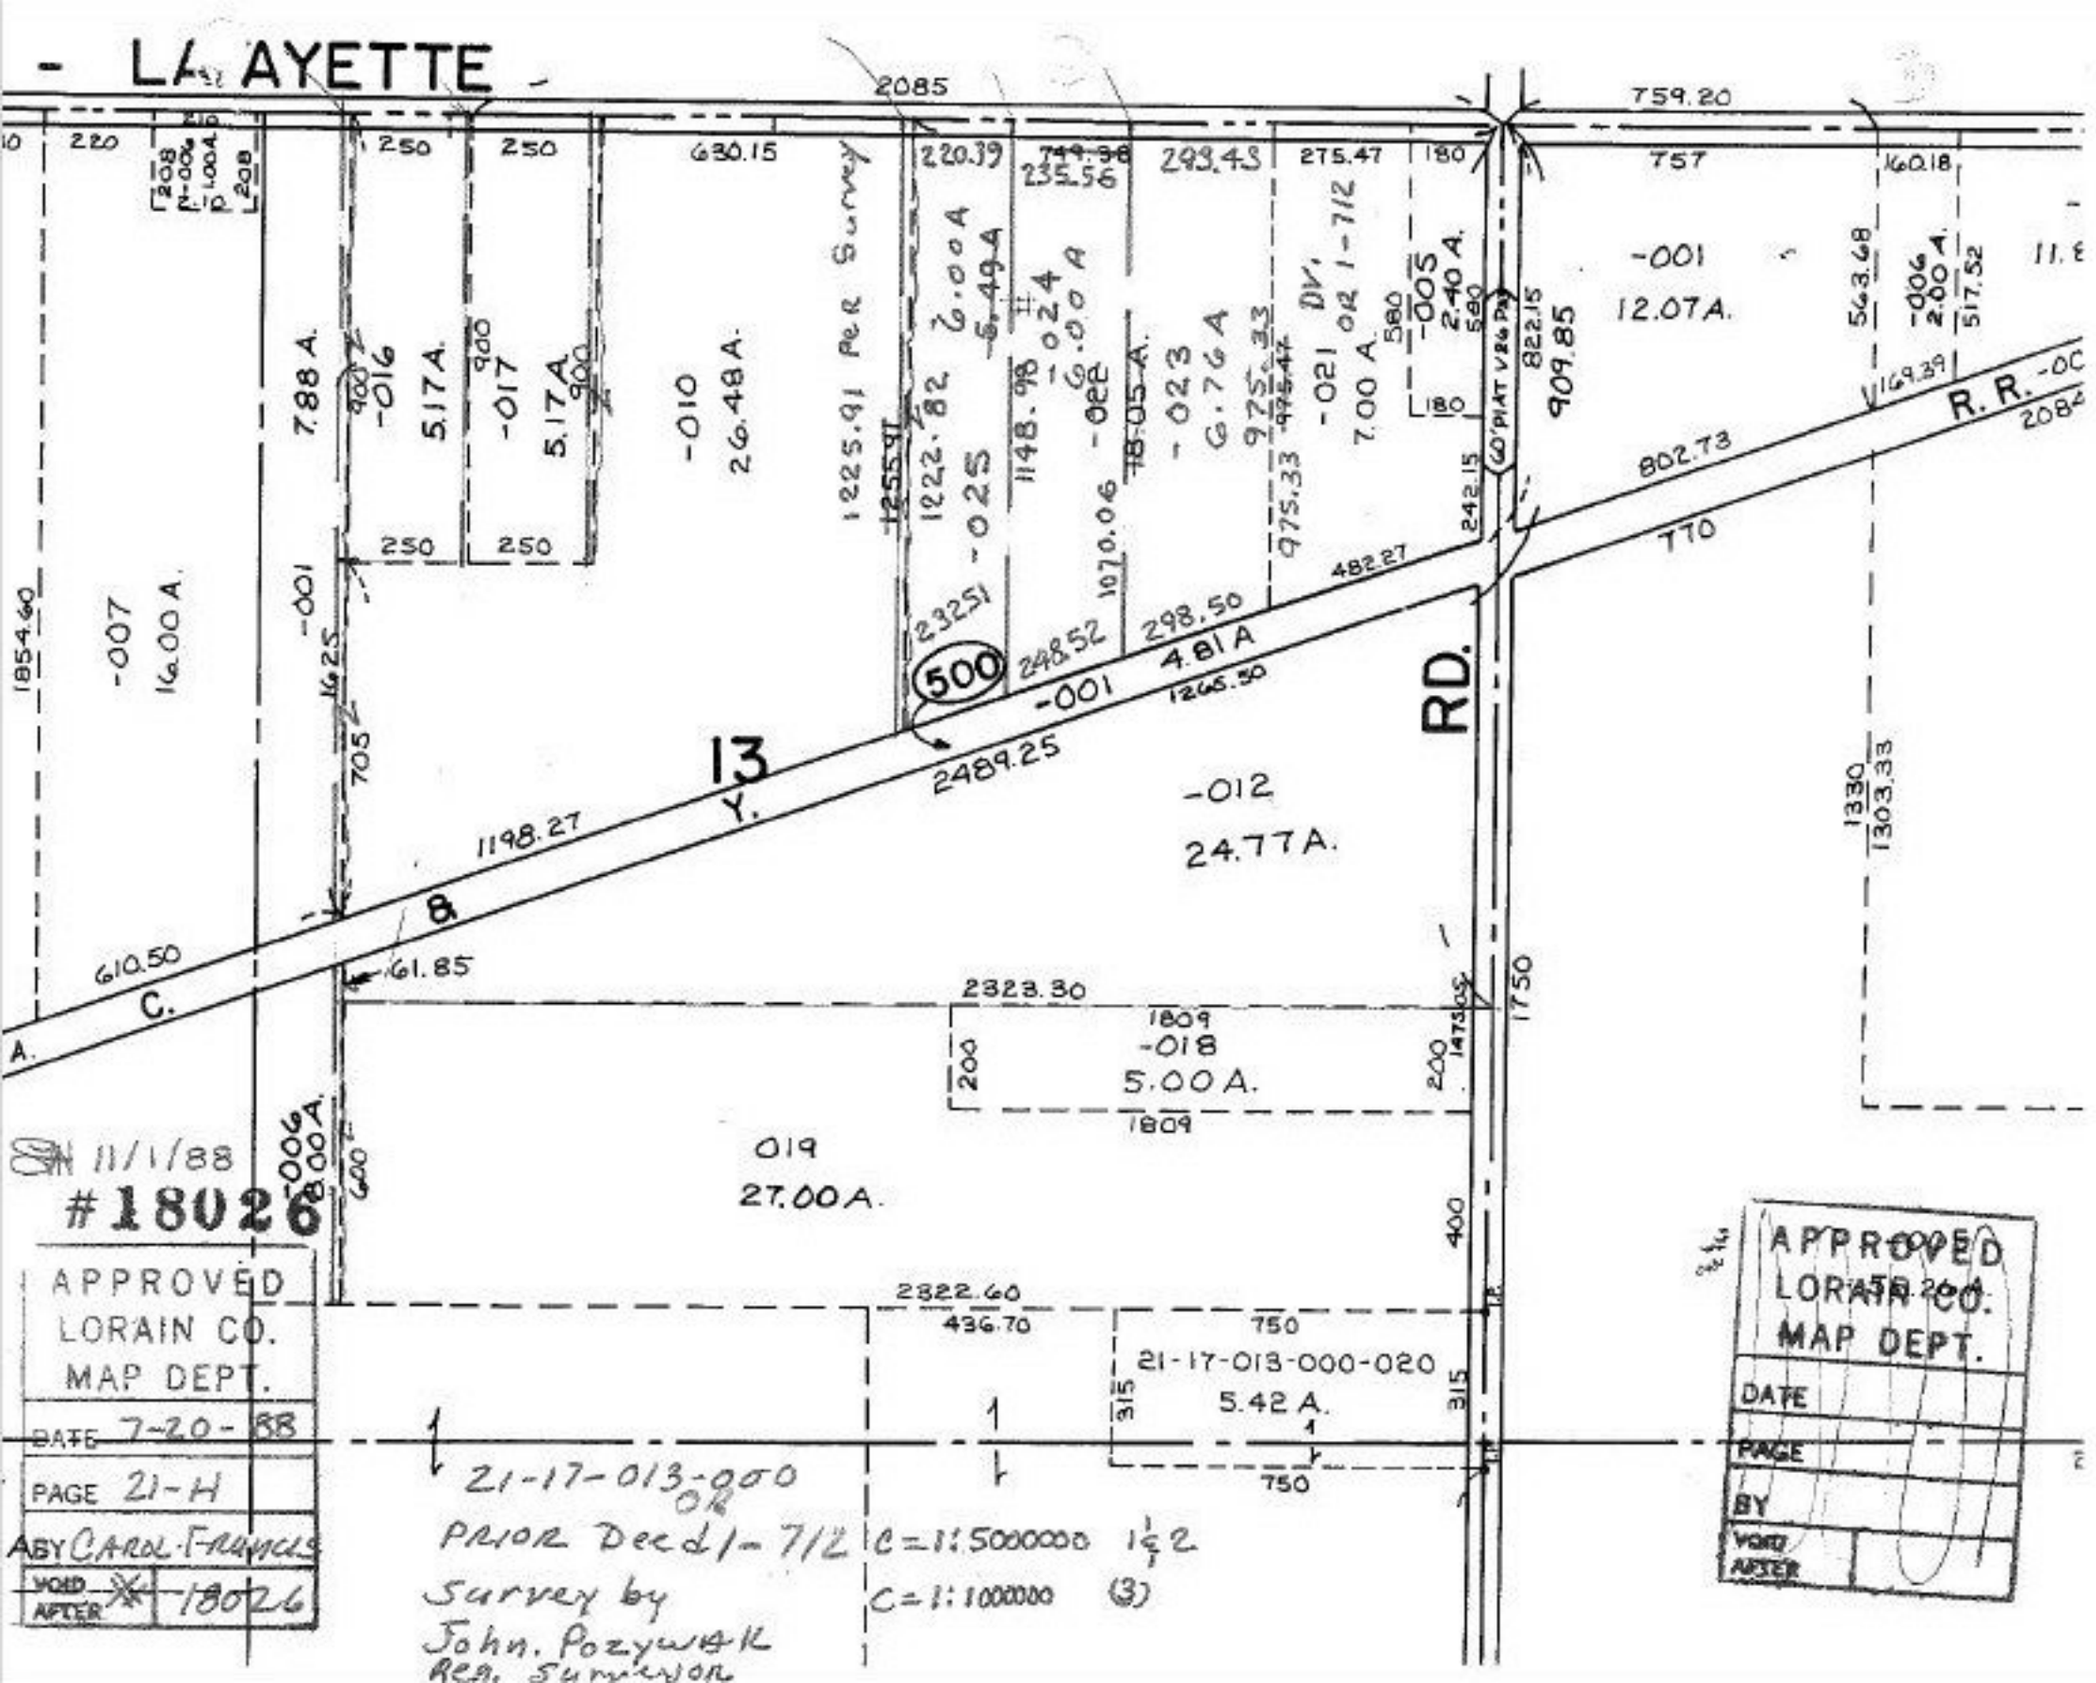

LAFAYETTE
2085
759.20
757
630.15
220.39
235.56
293.43
275.47
160.18
-001
12.07A.
-005
2.40 A.
909.85
822.15
563.68
-006
2.00 A.
517.52
169.39
R. R.
802.73
770
482.27
298.50
4.81 A
1265.50
-001
2489.25
-012
24.77A.
13
Y.
8
C.
A.
1198.27
610.50
61.85
2323.30
1809
-018
5.00 A.
1809
019
27.00A.
2322.60
436.70
750
21-17-013-000-020
5.42 A.
750
-007
16.00 A.
-001
7.88 A.
-016
5.17 A.
-017
5.17 A.
-010
26.48 A.
1225.91 Per Survey
1222.82
-025
6.00 A
-024
6.00 A
-022
-023
6.76 A
975.33
-021
7.00 A.
DV. OR 1-7/2
60' PLAT V 26 P
1854.60
705
1330
1303.33
1750
400
315
11/1/88
#18026
APPROVED
LORAIN CO.
MAP DEPT.
DATE 7-20-88
PAGE 21-H
BY CAROL FRANCIS
VOID AFTER 18026
21-17-013-000
OR
PRIOR Deed 1-7/2
Survey by
John. Pozywak
Reg. Surveyor
C=1:5000000 1 & 2
C=1:1000000 (3)
APPROVED
LORAIN CO.
MAP DEPT.
DATE
PAGE
BY
VOID AFTER