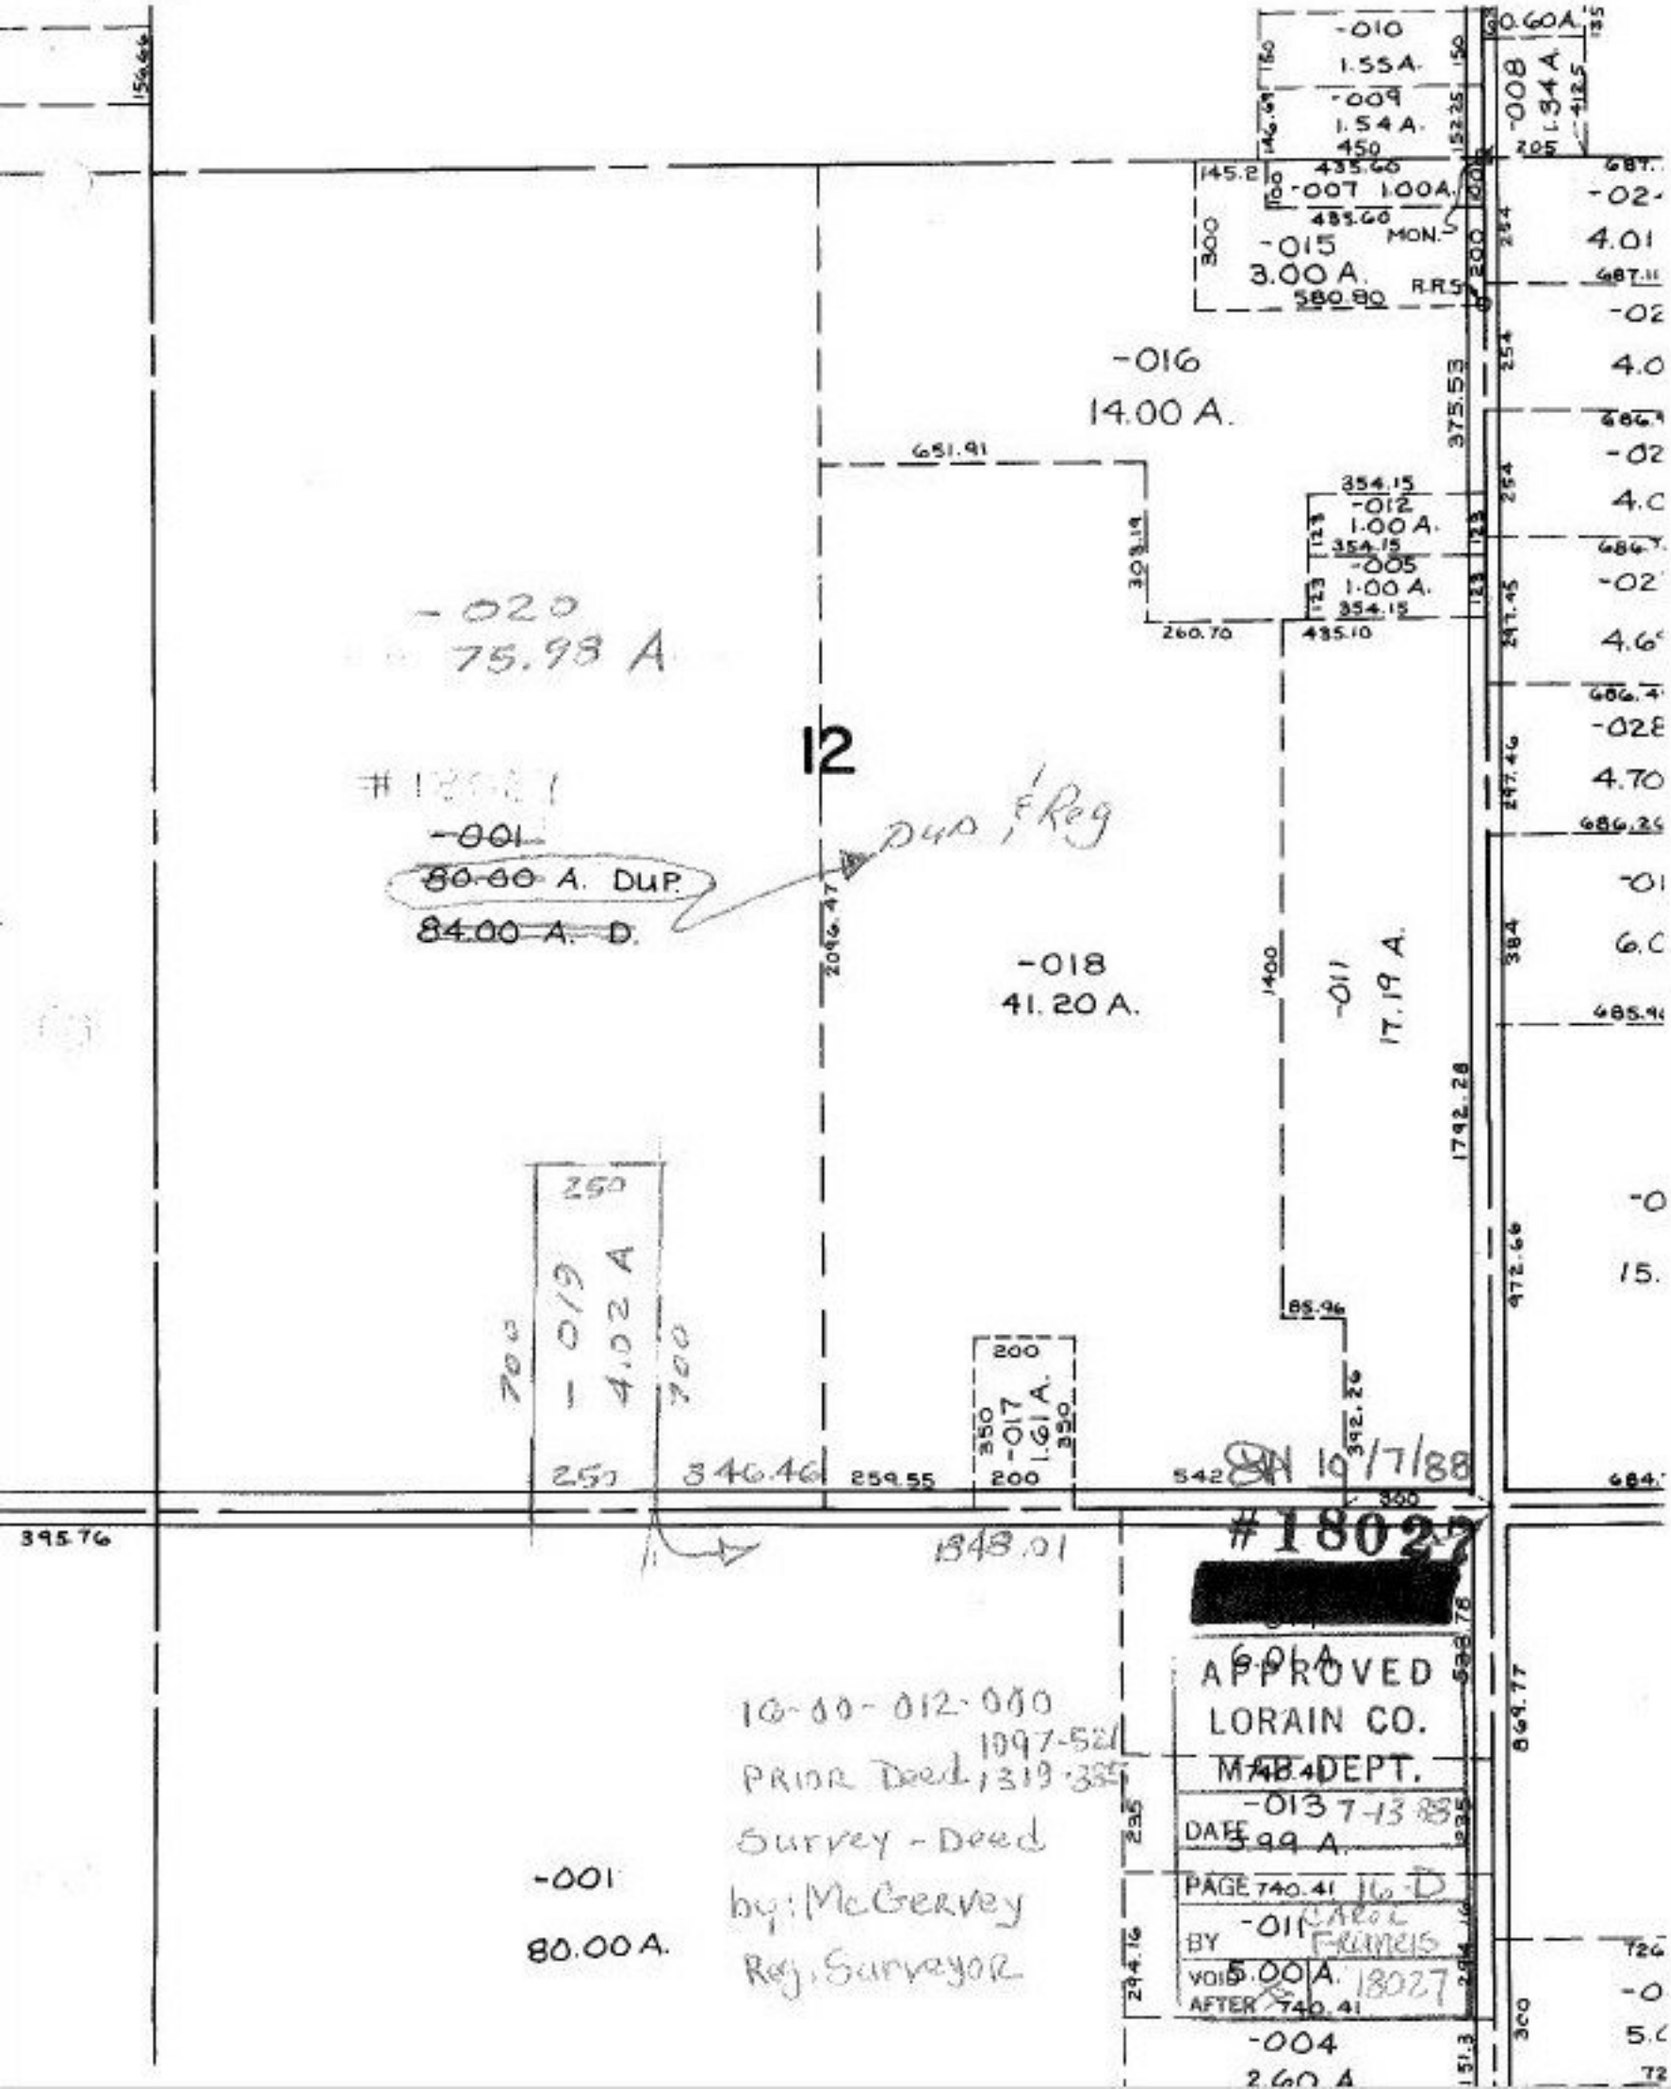
-010
1.55 A.
-009
1.54 A.
-008
1.34 A.
0.60 A.
-007 1.00 A.
-015
3.00 A.
MON.
R.R.S.
-016
14.00 A.
-012
1.00 A.
-005
1.00 A.
-020
75.98 A
12
#18027
-001
80.00 A. DUP.
84.00 A. D.
Dup, Reg
-018
41.20 A.
-011
17.19 A.
-019
4.02 A
-017
1.61 A.
10/7/88
#18027
[redacted]
6.00 A.
APPROVED
LORAIN CO.
MAP DEPT.
DATE 7-13-88
PAGE 740.41 16-D
BY CAROL FRANCIS
VOID 18027
AFTER 740.41
-013
5.99 A.
-011
5.00 A.
-004
2.60 A.
10-00-012-000
PRIOR Deed 1997-521, 1319-335
Survey - Deed
by: McGervey
Reg. Surveyor
-001
80.00 A.