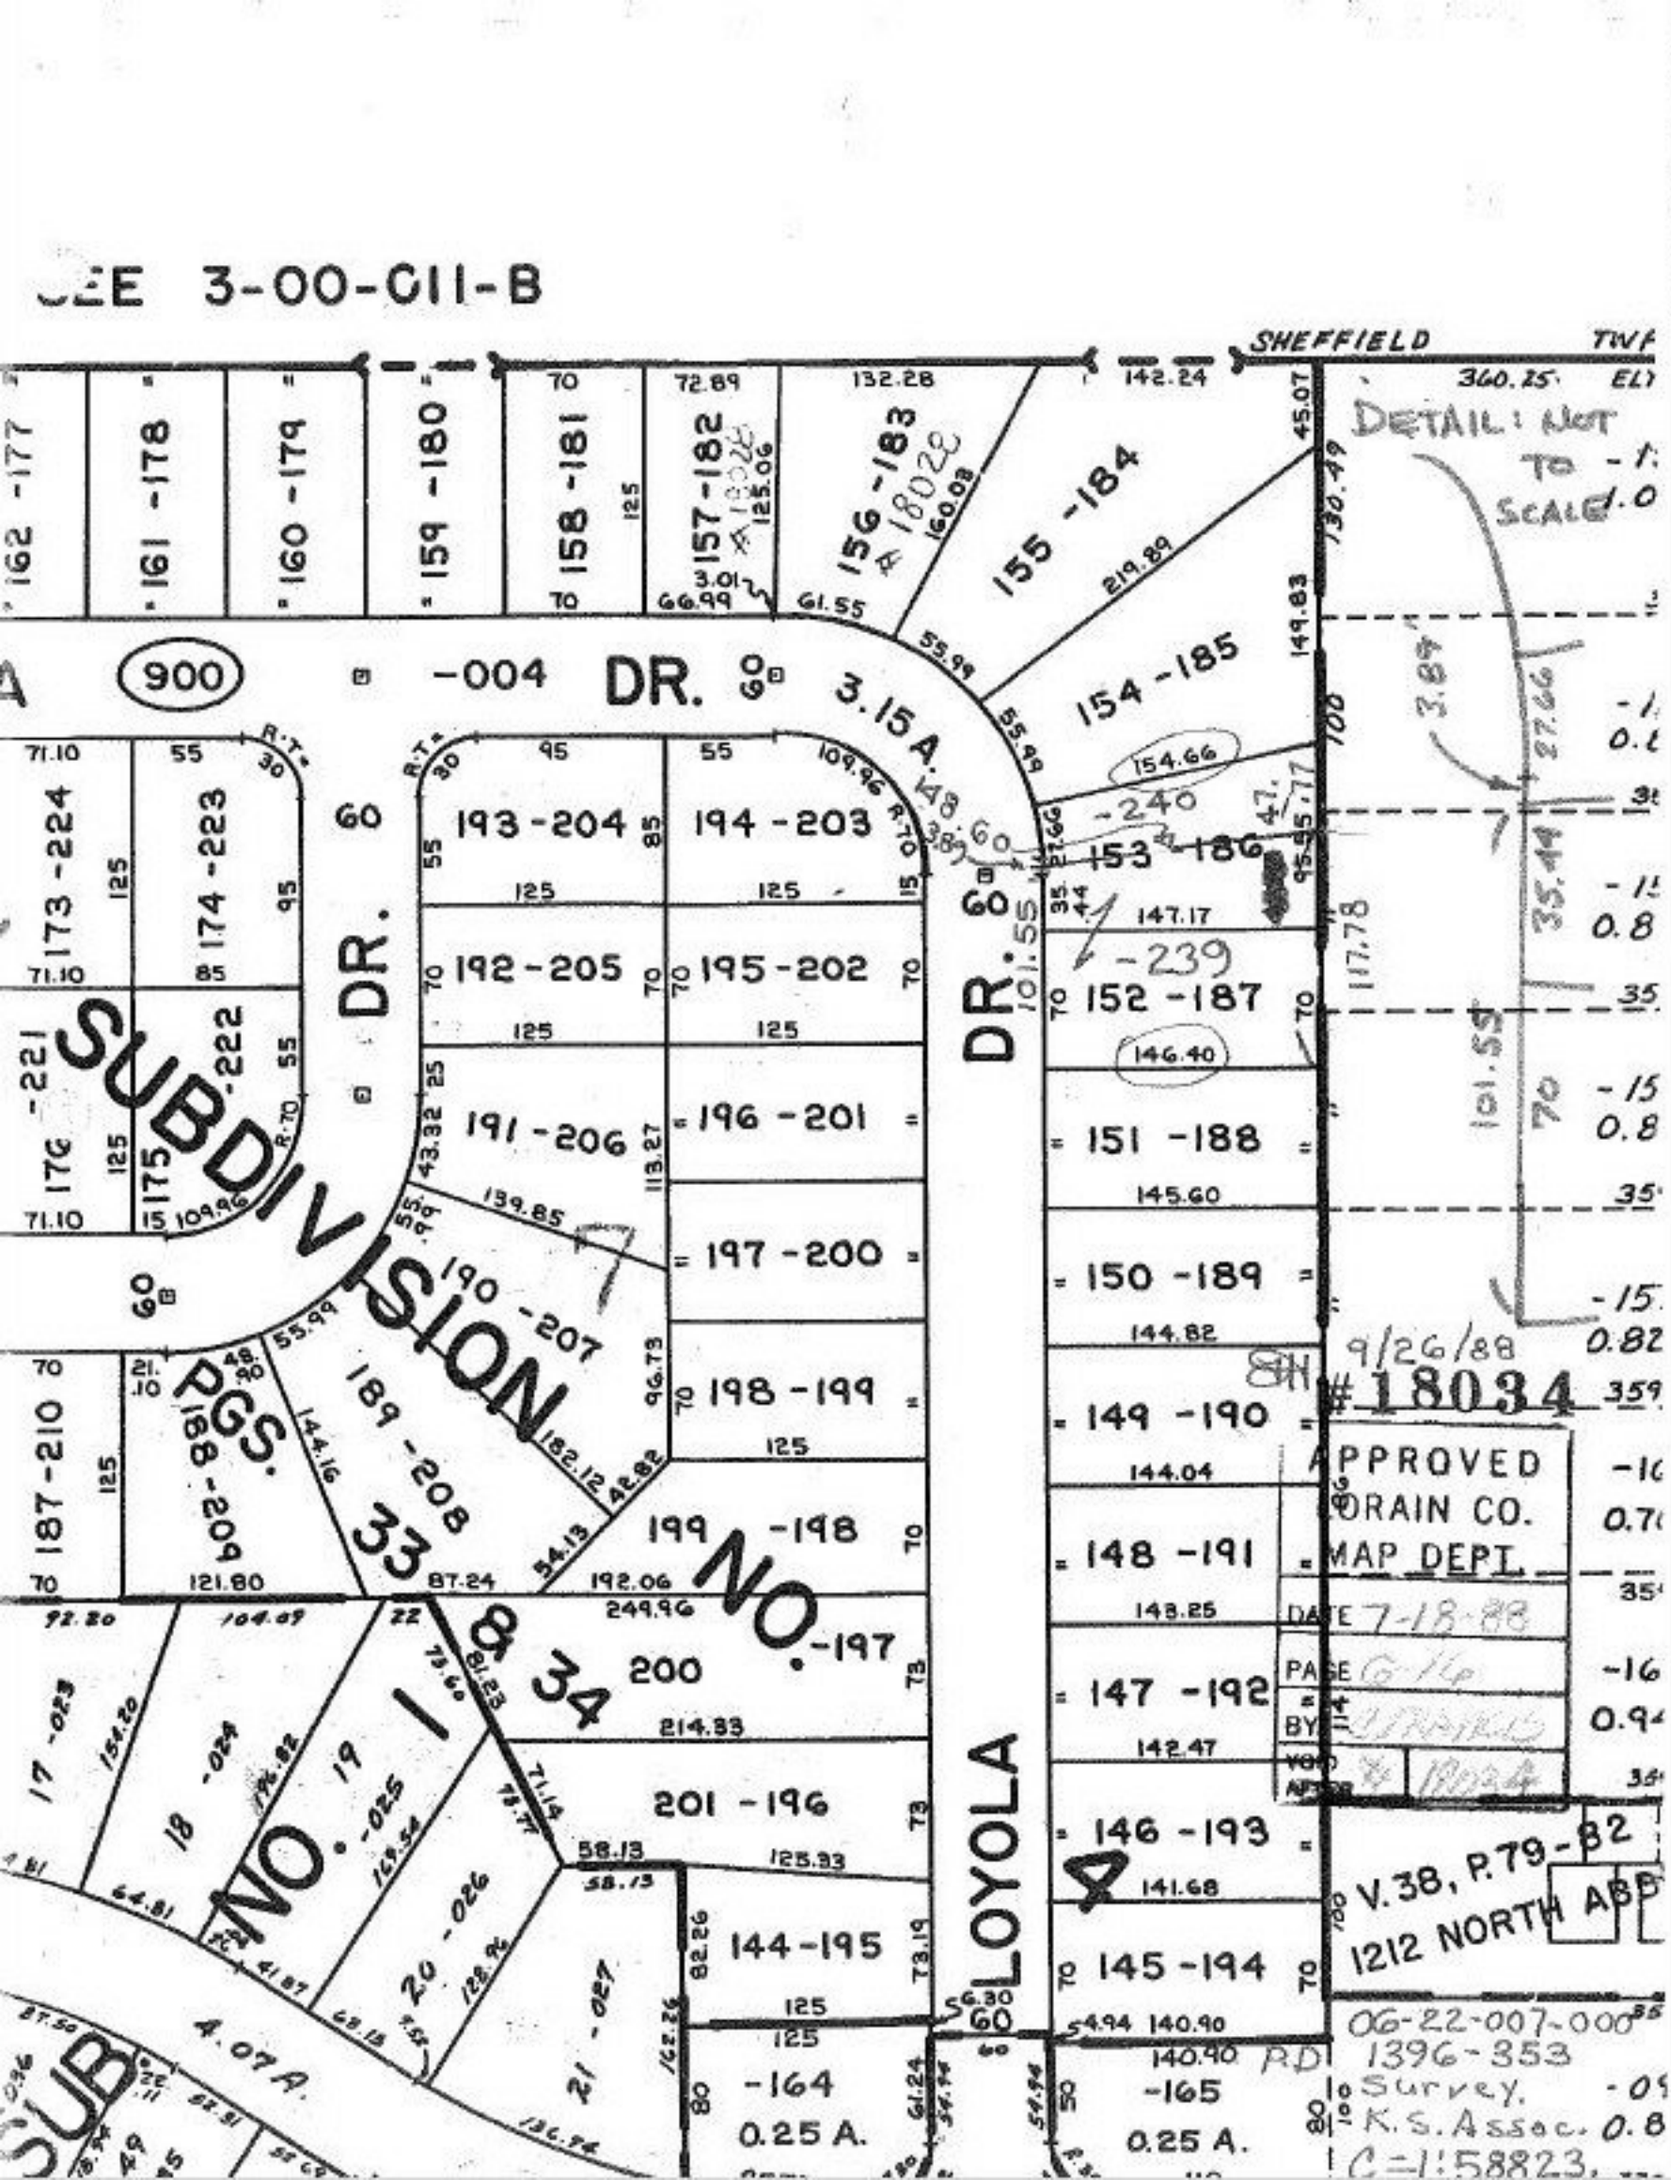
CE 3-00-011-B
SHEFFIELD
DETAIL: NOT TO SCALE
900
-004
DR.
3.15 A.
SUBDIVISION
NO. 1
LOYOLA
DR.
162 -177
161 -178
160 -179
159 -180
158 -181
157 -182
156 -183
155 -184
154 -185
153 -186
152 -187
151 -188
150 -189
149 -190
148 -191
147 -192
146 -193
145 -194
144 -195
-164
0.25 A.
-165
0.25 A.
173 -224
174 -223
175 -222
176 -221
193 -204
194 -203
192 -205
195 -202
191 -206
196 -201
197 -200
190 -207
189 -208
198 -199
199 -198
200
201 -196
17 -023
18 -024
19 -025
20 -026
21 -027
187 -210
188 -209
4.07 A.
-240
-239
9/26/88
#18034
APPROVED
DRAIN CO.
MAP DEPT.
DATE 7-18-88
V. 38, P. 79-82
1212 NORTH ABB
06-22-007-000
1396-353
Survey.
K.S. Assoc.
C-1-58823.