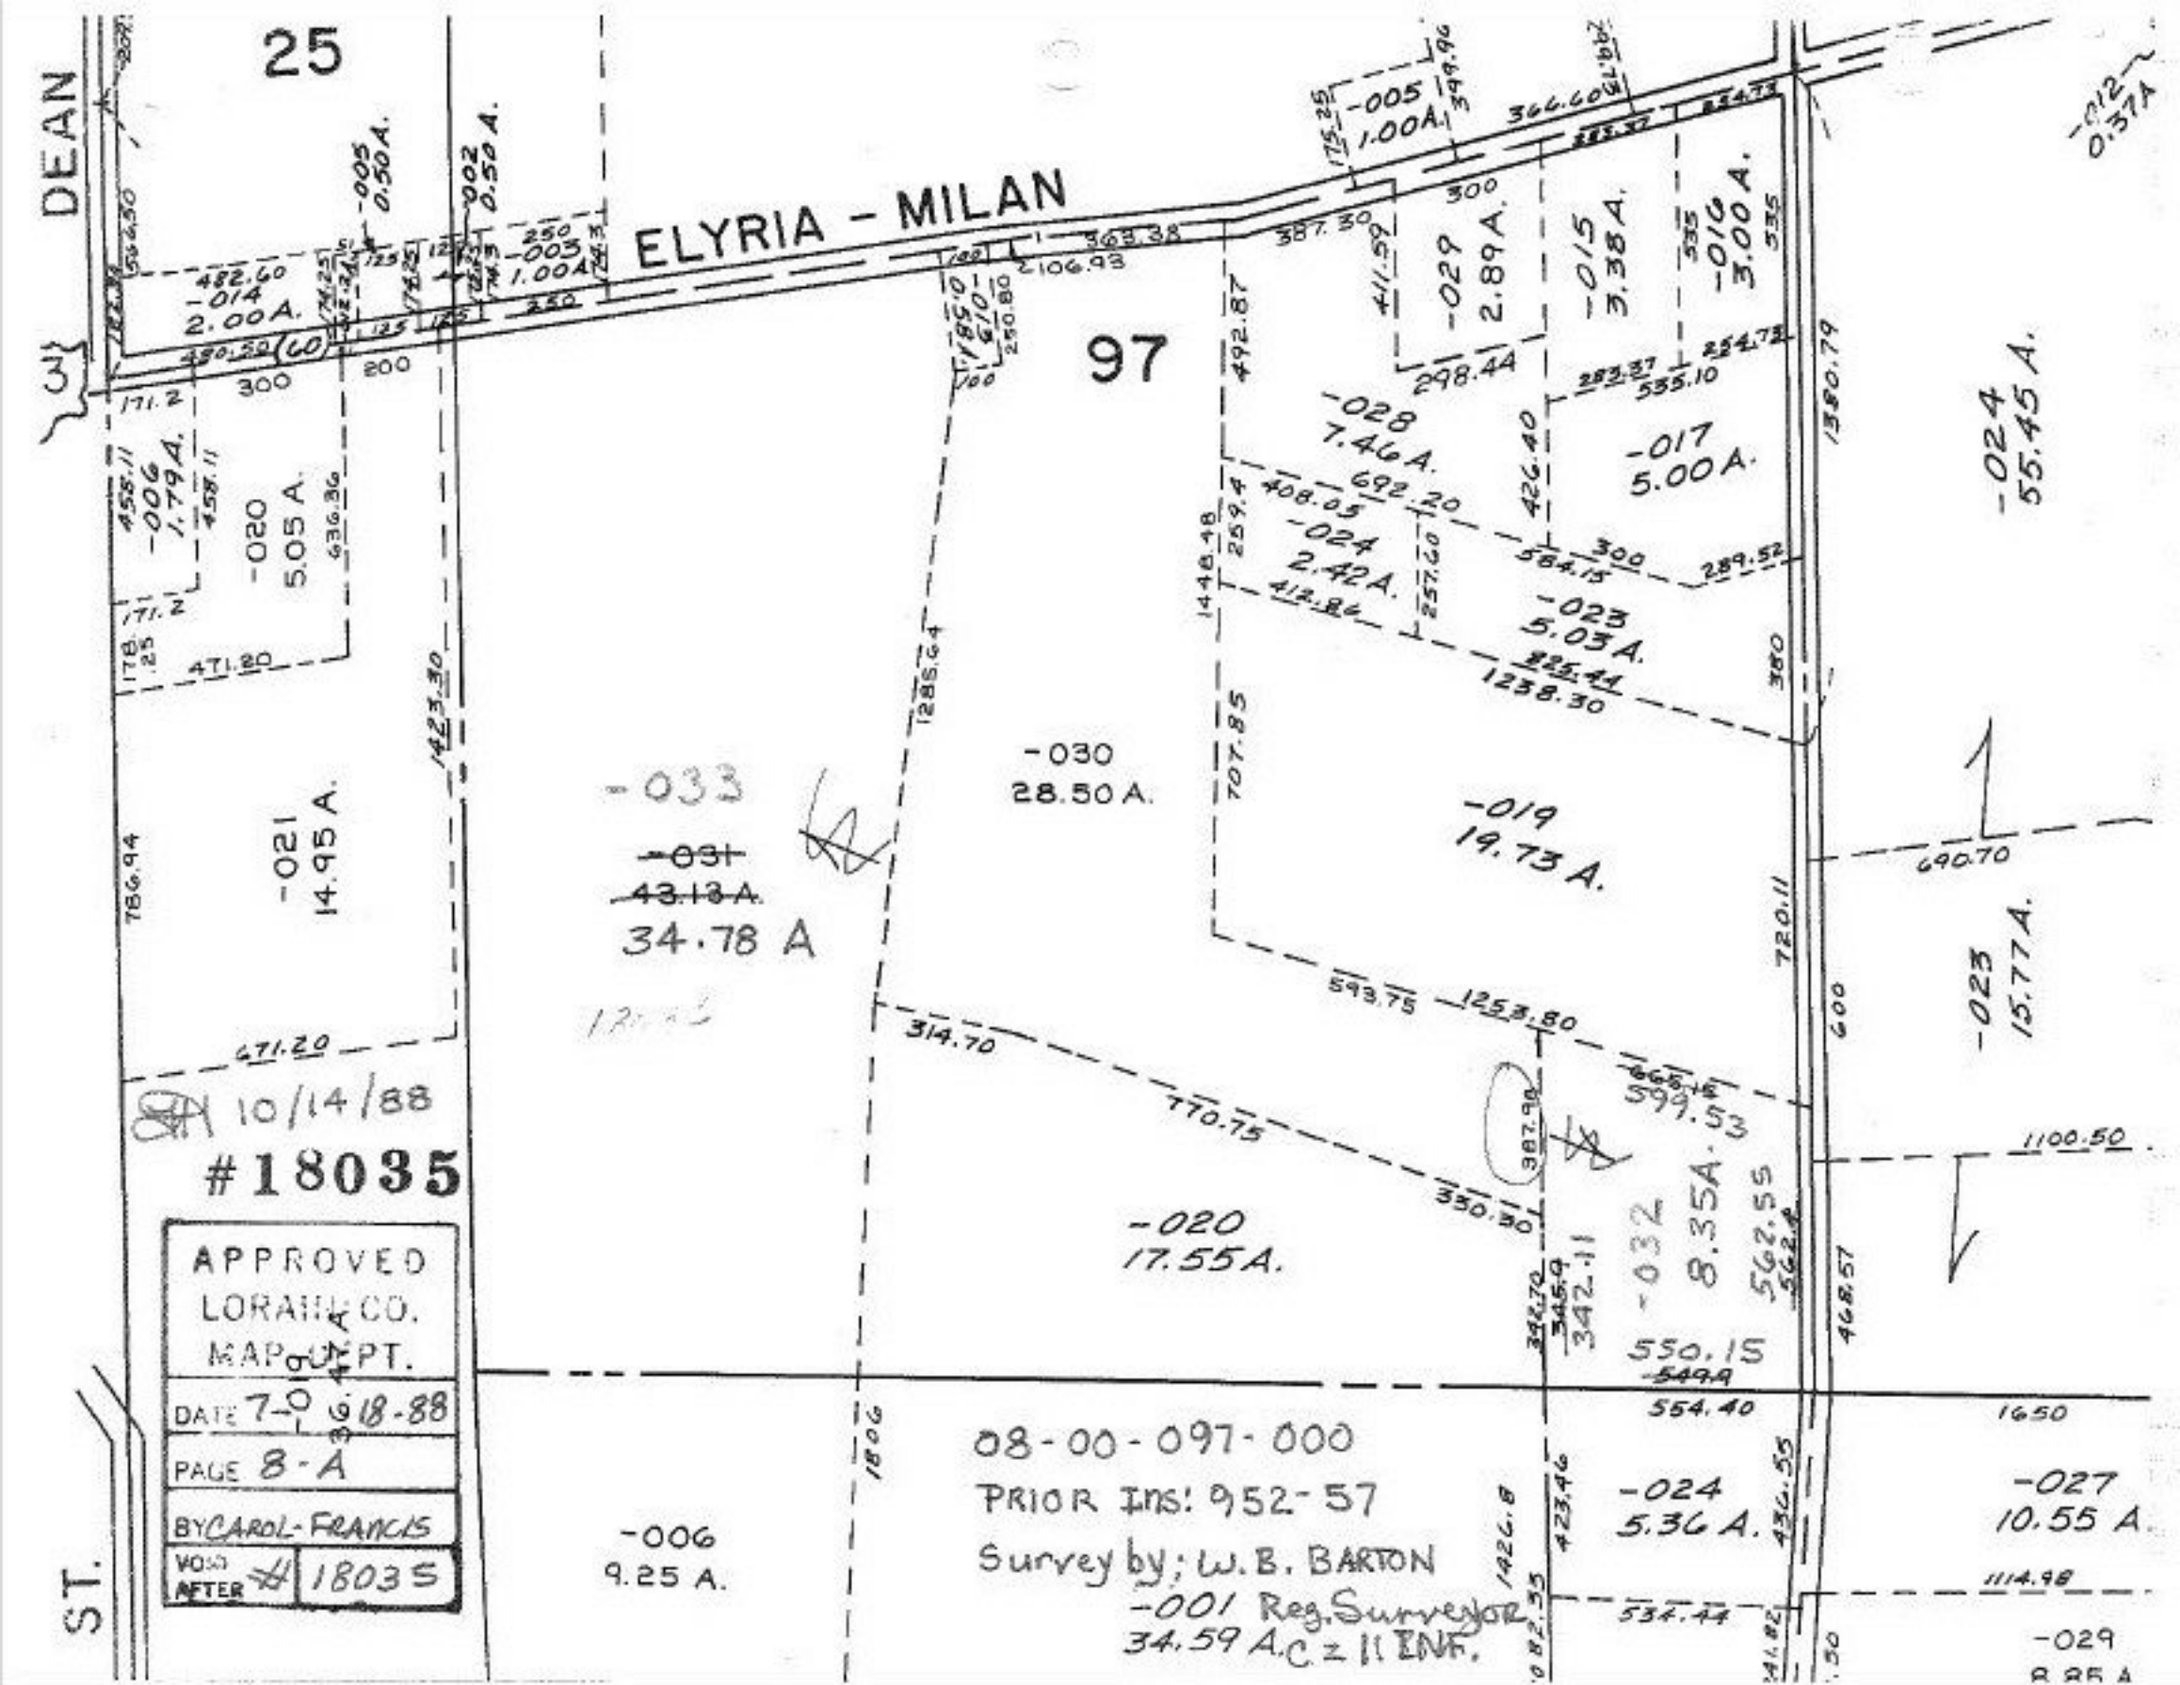
DEAN
ST.
ELYRIA - MILAN
25
97
-005
0.50 A.
-002
0.50 A.
-014
2.00 A.
-003
1.00 A.
-005
1.00 A.
-029
2.89 A.
-015
3.38 A.
-016
3.00 A.
-012
0.37 A.
-028
7.46 A.
-017
5.00 A.
-024
55.45 A.
-006
1.79 A.
-020
5.05 A.
-024
2.42 A.
-023
5.03 A.
-021
14.95 A.
-033
-031
43.13 A.
34.78 A
-030
28.50 A.
-019
19.73 A.
-023
15.77 A.
-020
17.55 A.
-032
8.35 A.
-006
9.25 A.
-024
5.36 A.
-027
10.55 A.
-029
10/14/88
#18035
APPROVED
LORAIN CO.
MAP DEPT.
DATE 7-0 6 18-88
PAGE 8-A
BY CAROL-FRANCIS
VOID AFTER #18035
08-00-097-000
PRIOR INS: 952-57
Survey by; W.B. BARTON
-001 Reg. Surveyor
34.59 A.C.z II ENF.