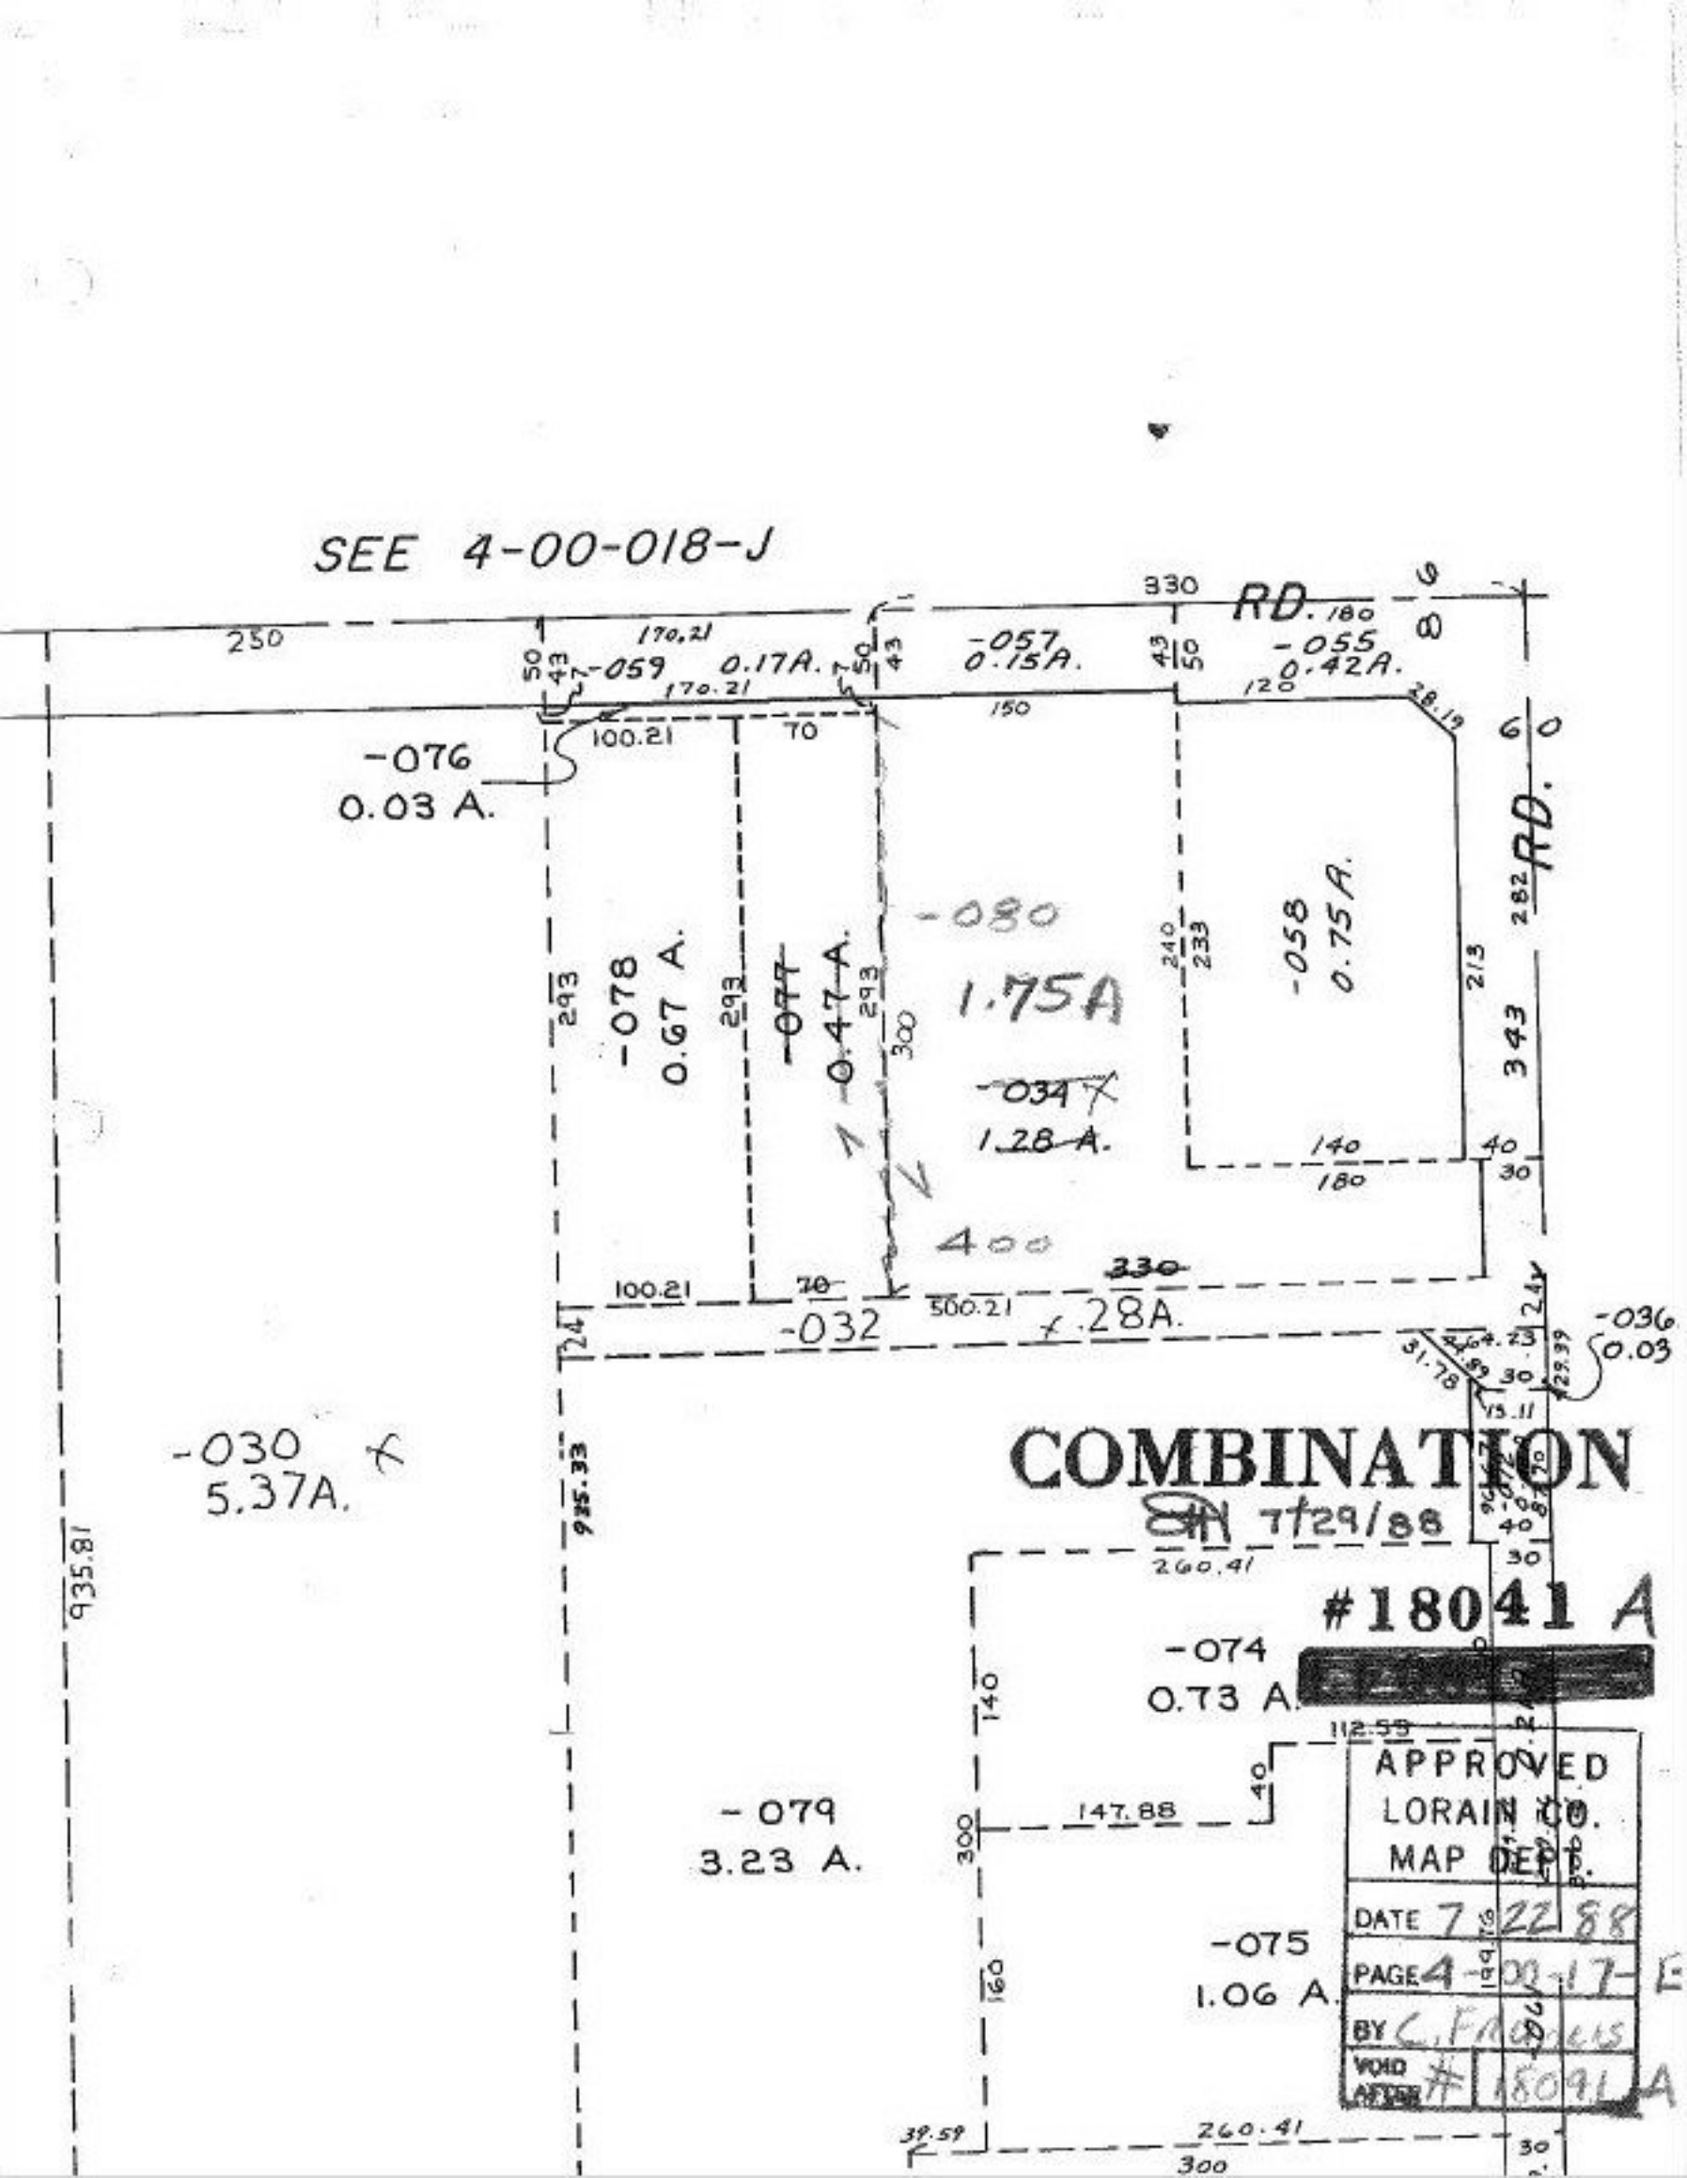
SEE 4-00-018-J
330
RD.
250
170.21
-059
0.17A.
-057
0.15A.
-055
0.42A.
-076
0.03 A.
100.21
70
150
120
-080
1.75A
-078
0.67 A.
-077
0.47 A.
-034
1.28 A.
-058
0.75A.
RD.
293
300
240
233
213
343
140
180
40
30
400
100.21
70
300.21
330
-032
1.28A.
-036
0.03
-030
5.37A.
935.81
935.33
COMBINATION
7/29/88
#18041 A
260.41
-074
0.73 A.
112.58
APPROVED
LORAIN CO.
MAP DEPT.
DATE 7/22/88
PAGE 4-00-17-E
BY C. FRANCIS
VOID AFTER # 18041 A
-079
3.23 A.
147.88
140
300
160
-075
1.06 A.
39.59
260.41
300