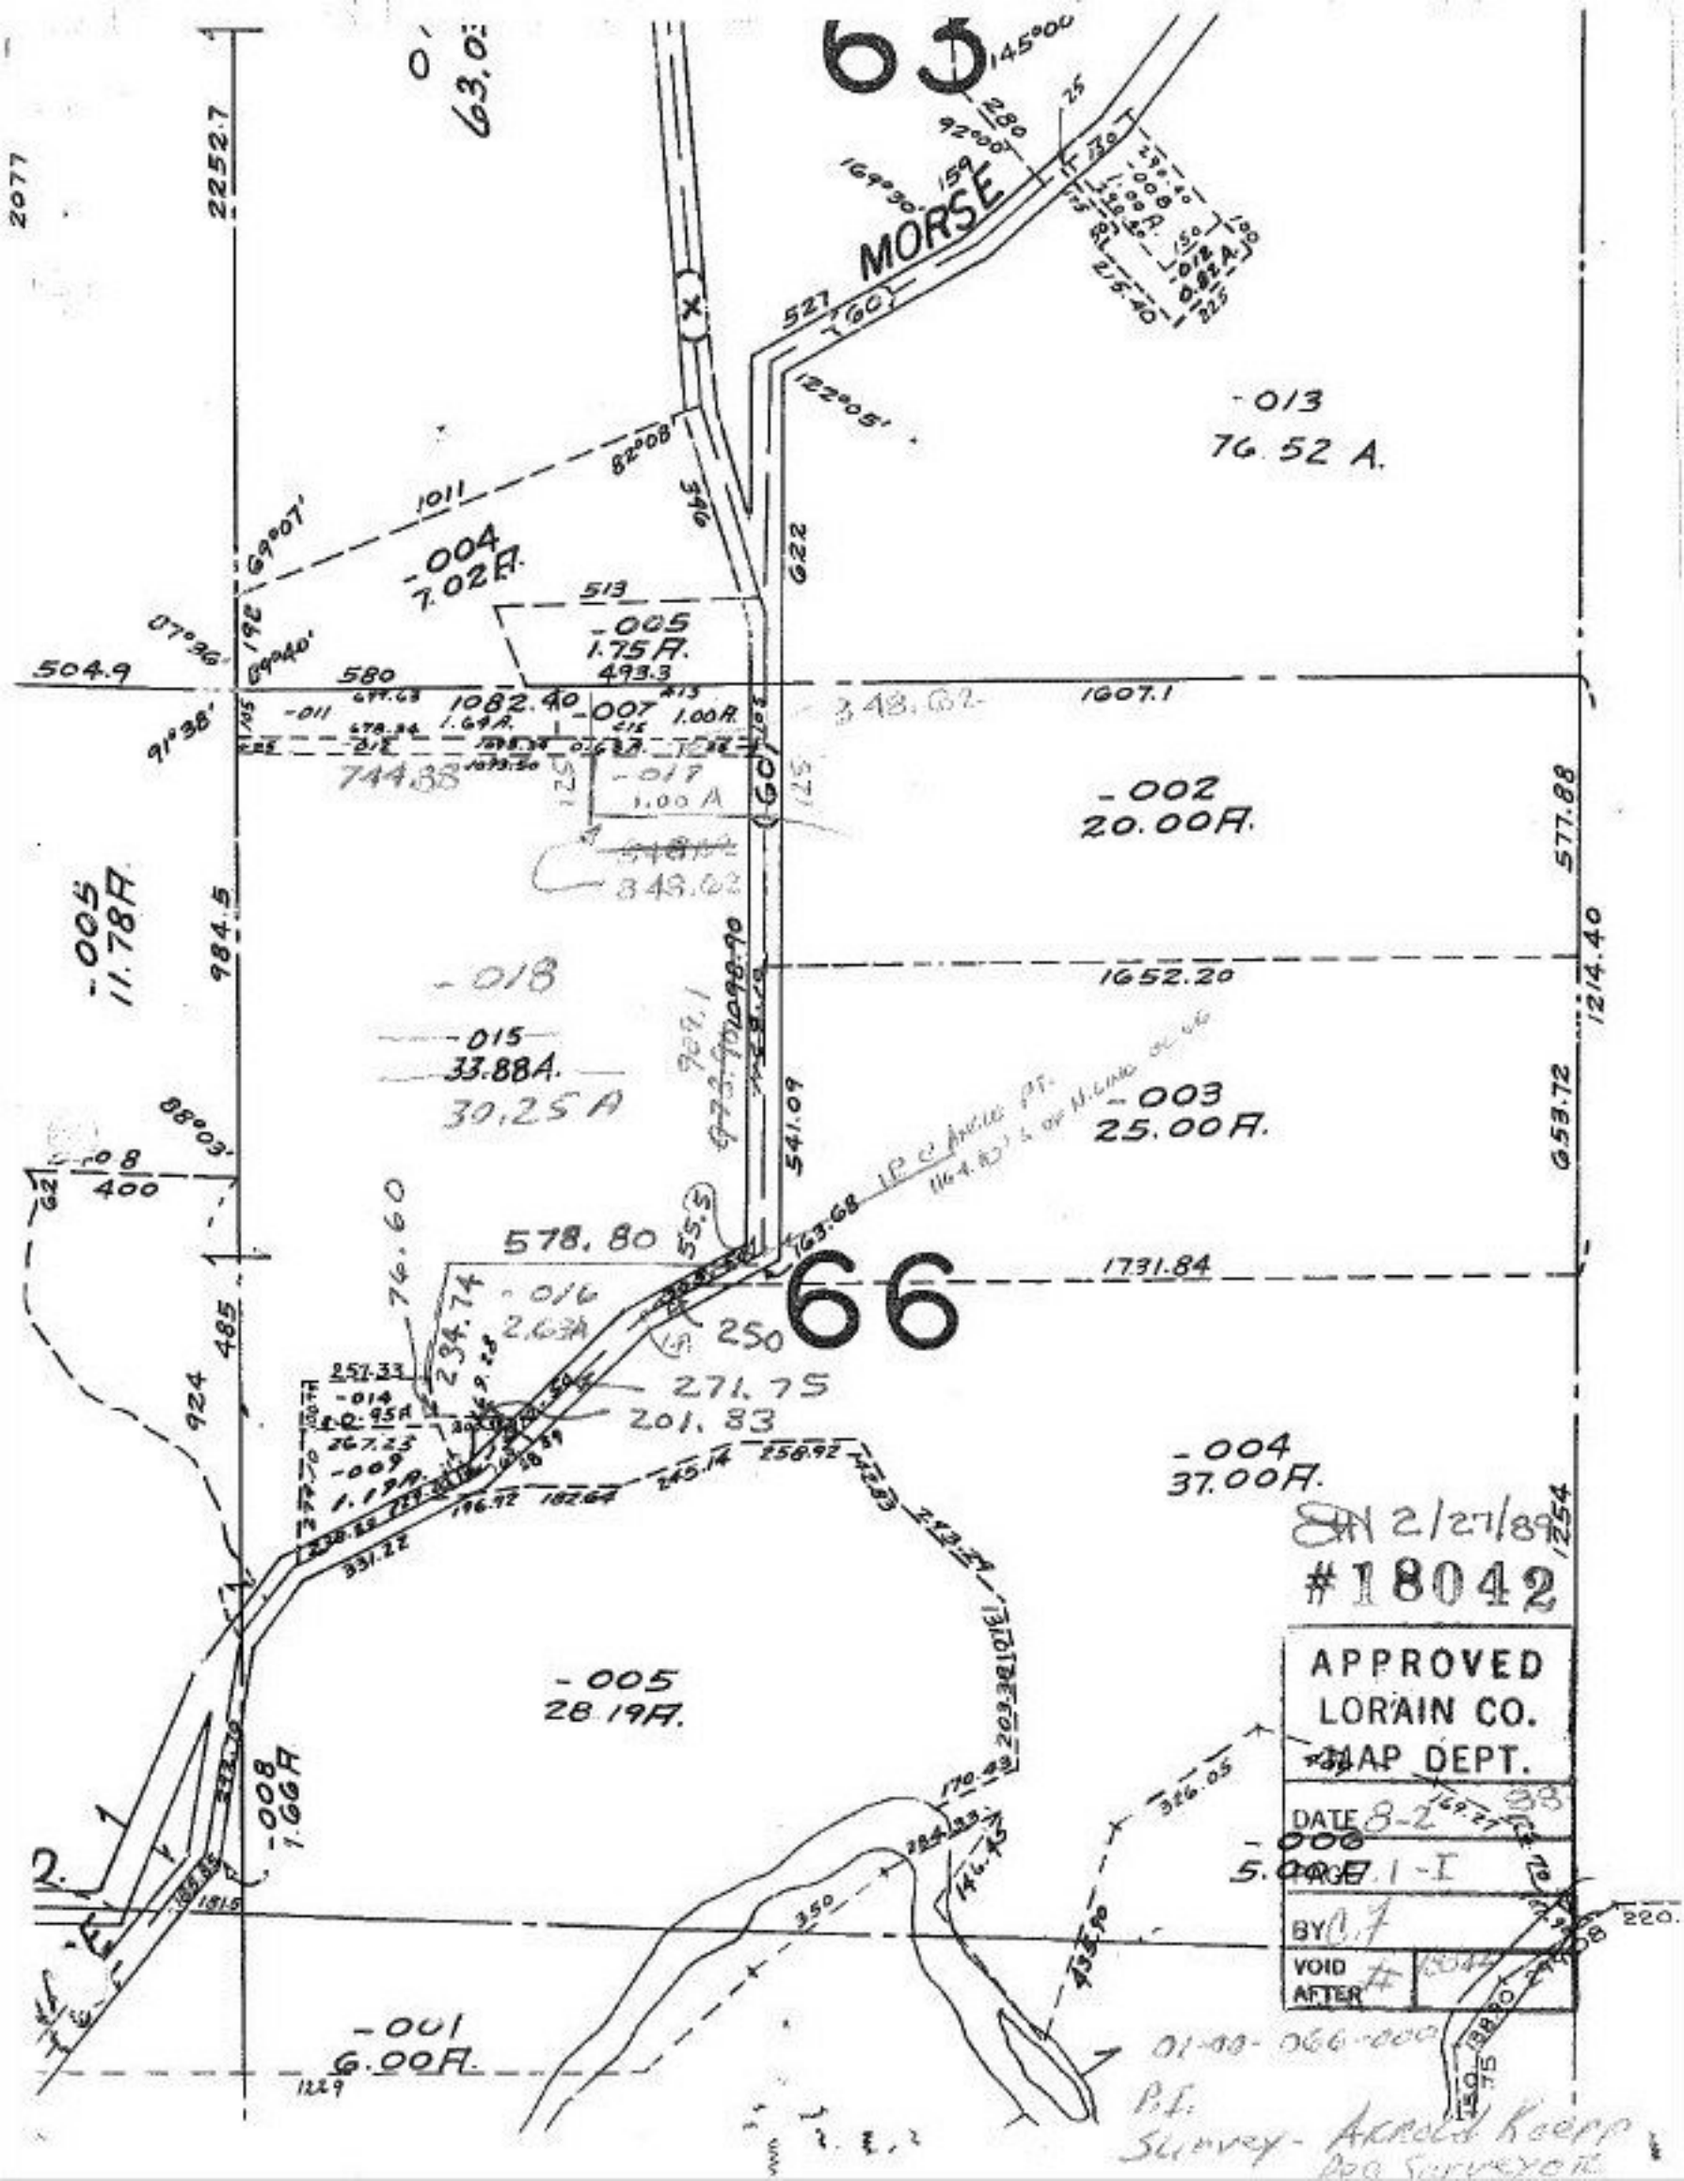
65
66
MORSE
-013
76.52 A.
-004
7.02 A.
-005
1.75 A.
493.3
-002
20.00 A.
-003
25.00 A.
-005
11.78 A.
-018
-015
33.88 A.
30.25 A
-016
2.63 A
-014
9.5 A
-009
1.19 A.
-004
37.00 A.
-005
28.19 A.
-008
1.66 A
-001
6.00 A.
-017
1.00 A
APPROVED
LORAIN CO.
MAP DEPT.
DATE 8-2
BY
VOID AFTER
#18042
01-00-066-000
P.I.
Survey - Arnold Koepp
Reg Surveyor