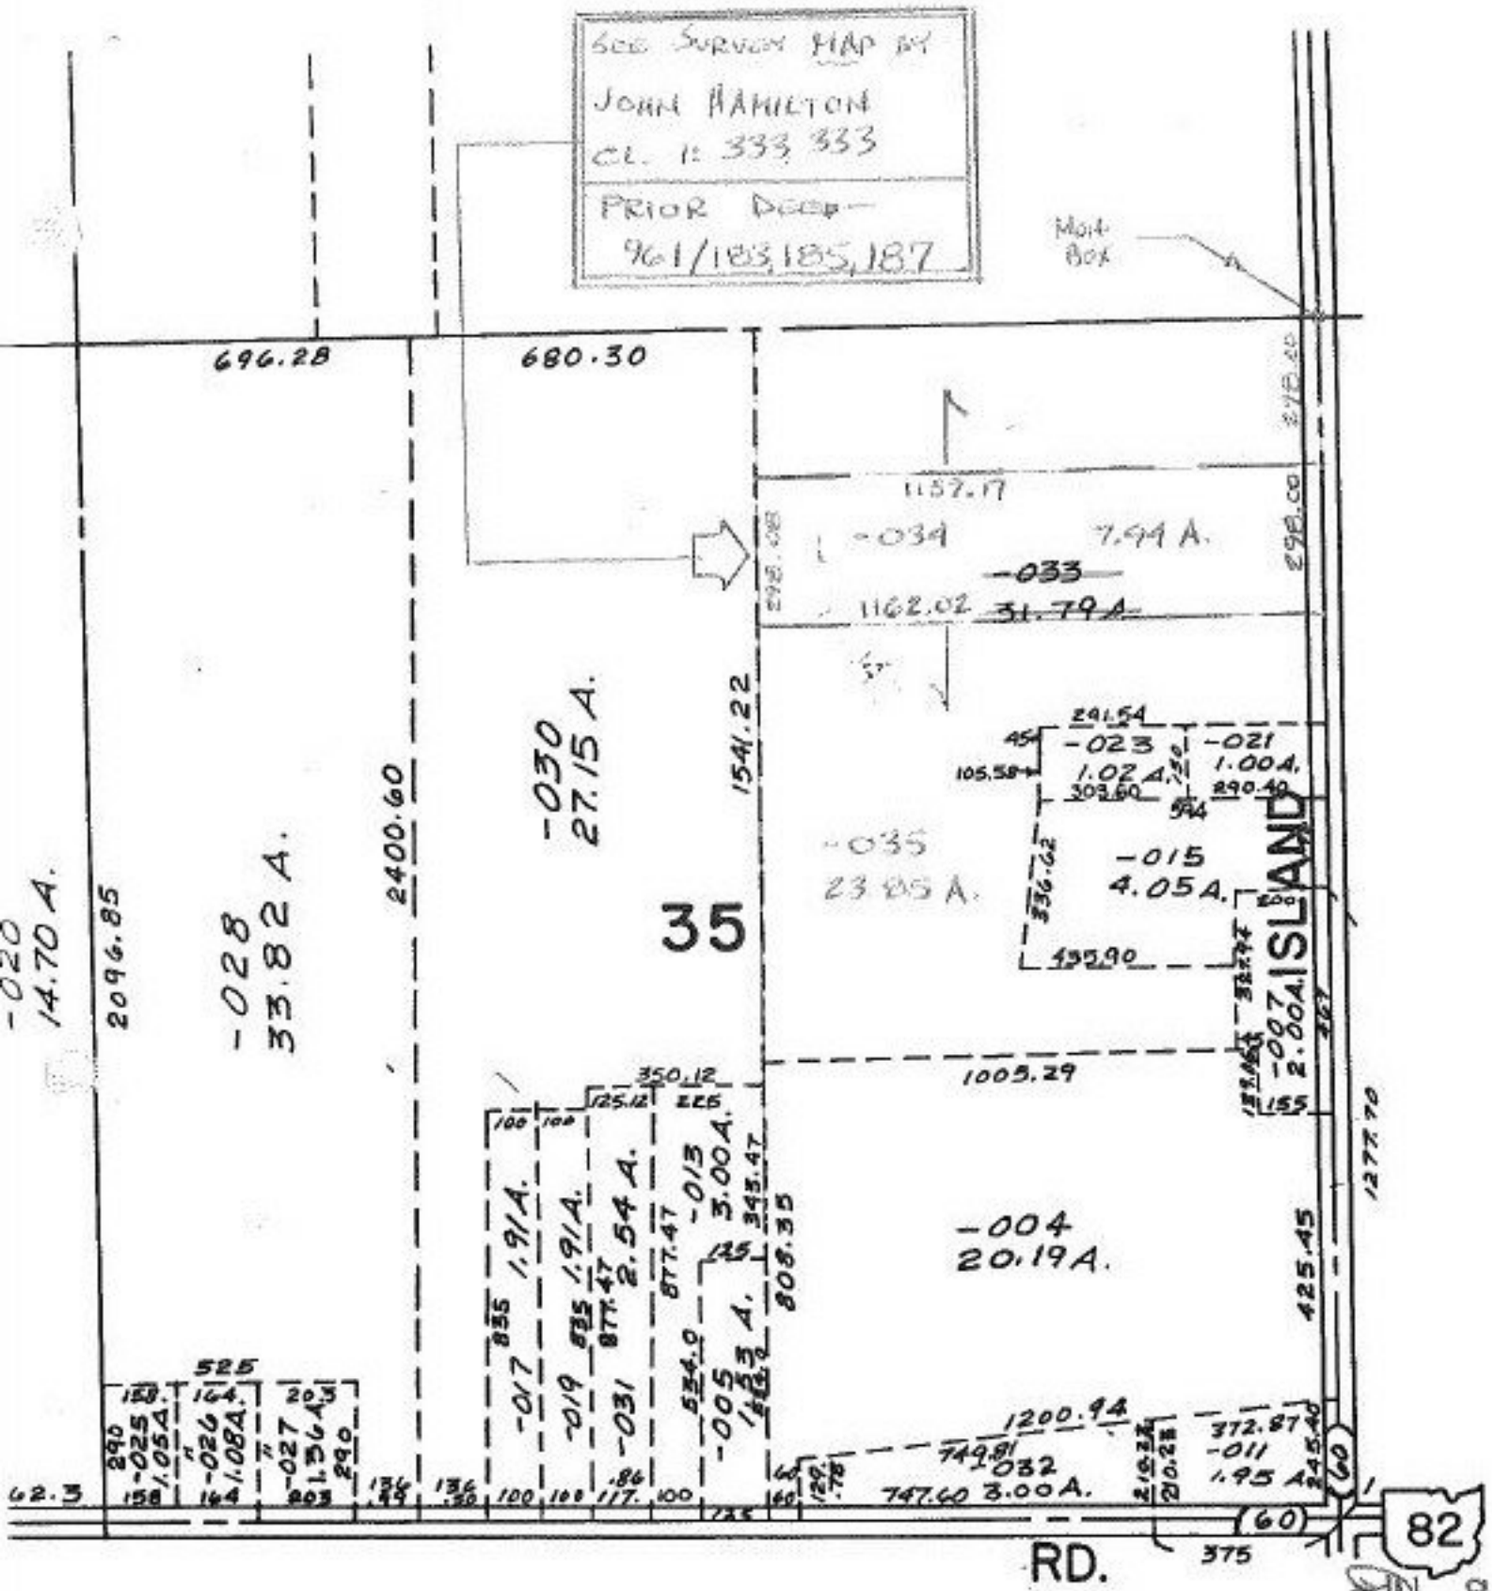

9/19/88

#18043

APPROVED
LORAIN CO.
MAP DEPT.

DATE 7-26-88

PAGE II-C.

BY T. McNair

VOID AFTER # 18043

1 THRU 35,46 THRU 50