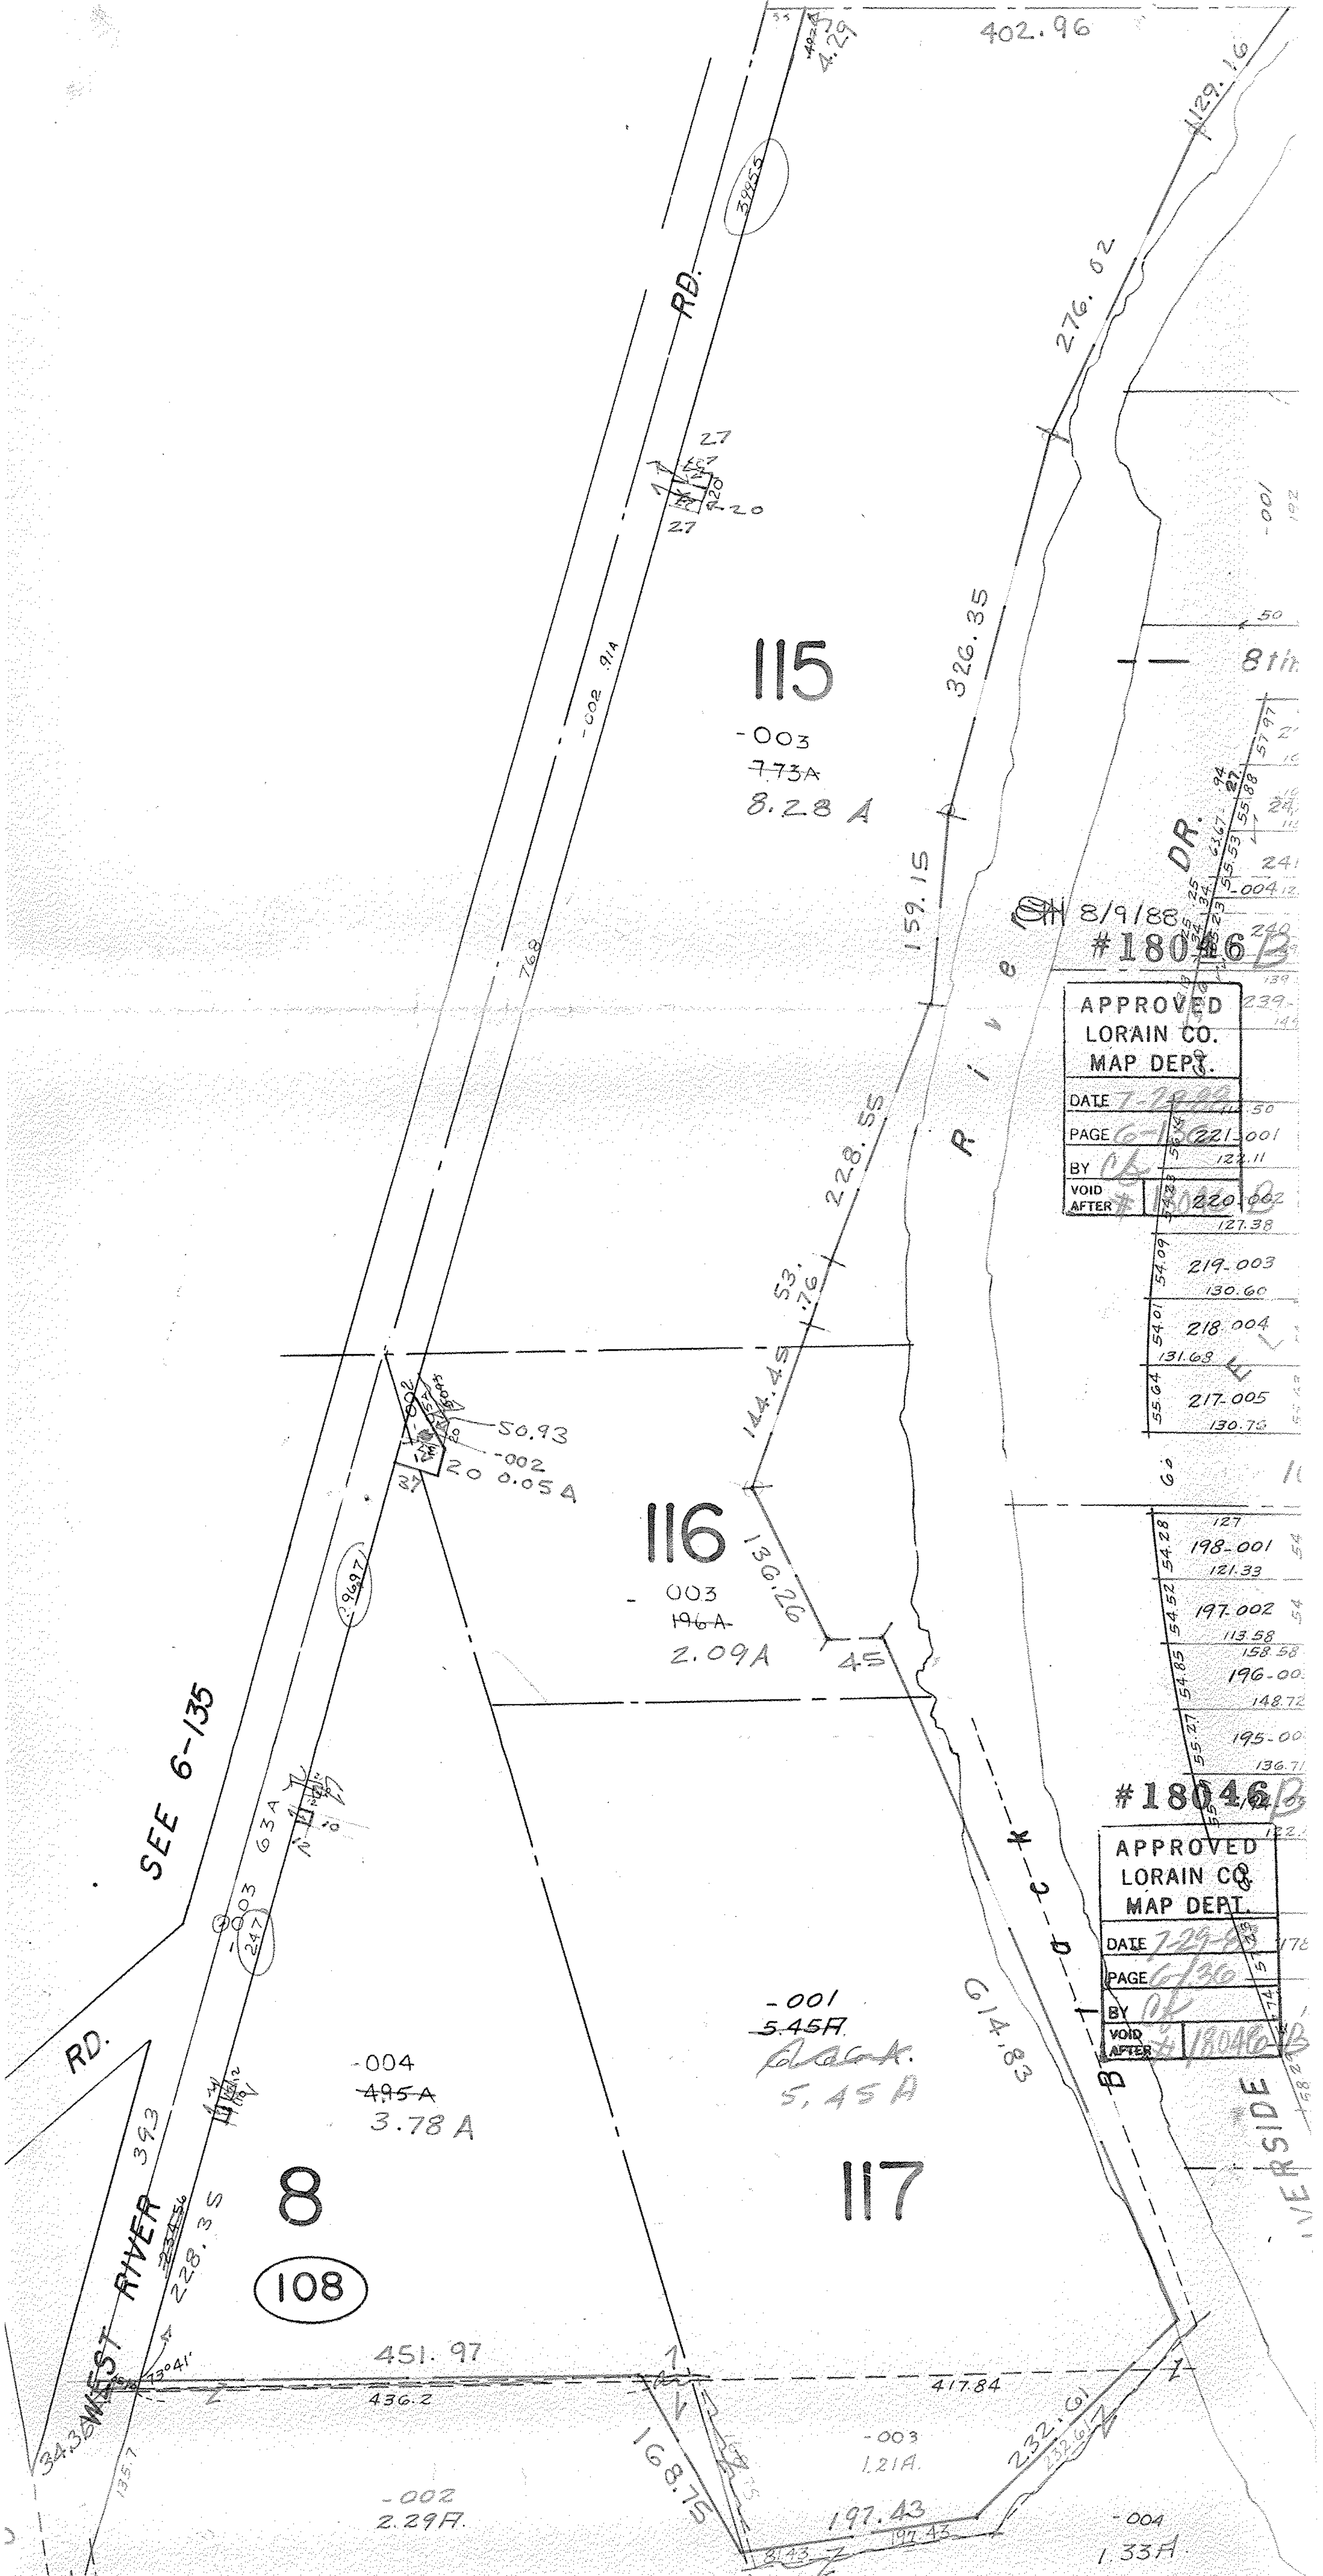

402.96
129.16
276.02
326.35
159.15
228.55
144.45
136.26
45
614.83
RD.
SEE 6-135
WEST RIVER
RD.
115
-003
~~7.73A~~
8.28 A
116
-003
~~196A~~
2.09A
117
-001
~~5.45A~~
5.45 A
8
108
-004
~~4.95A~~
3.78 A
-002
2.29A
-003
1.21A
-004
1.33A
451.97
436.2
417.84
168.75
197.43
232.61
228.35
393
50.93
-002
20 0.05A
8/9/88
#18046 B
APPROVED
LORAIN CO.
MAP DEPT.
DATE 7-29-88
PAGE 6-136
BY
VOID AFTER
#18046 B
APPROVED
LORAIN CO.
MAP DEPT.
DATE 7-29-88
PAGE 6/36
BY
VOID AFTER
#18046 B
River
Black
DR.
8th