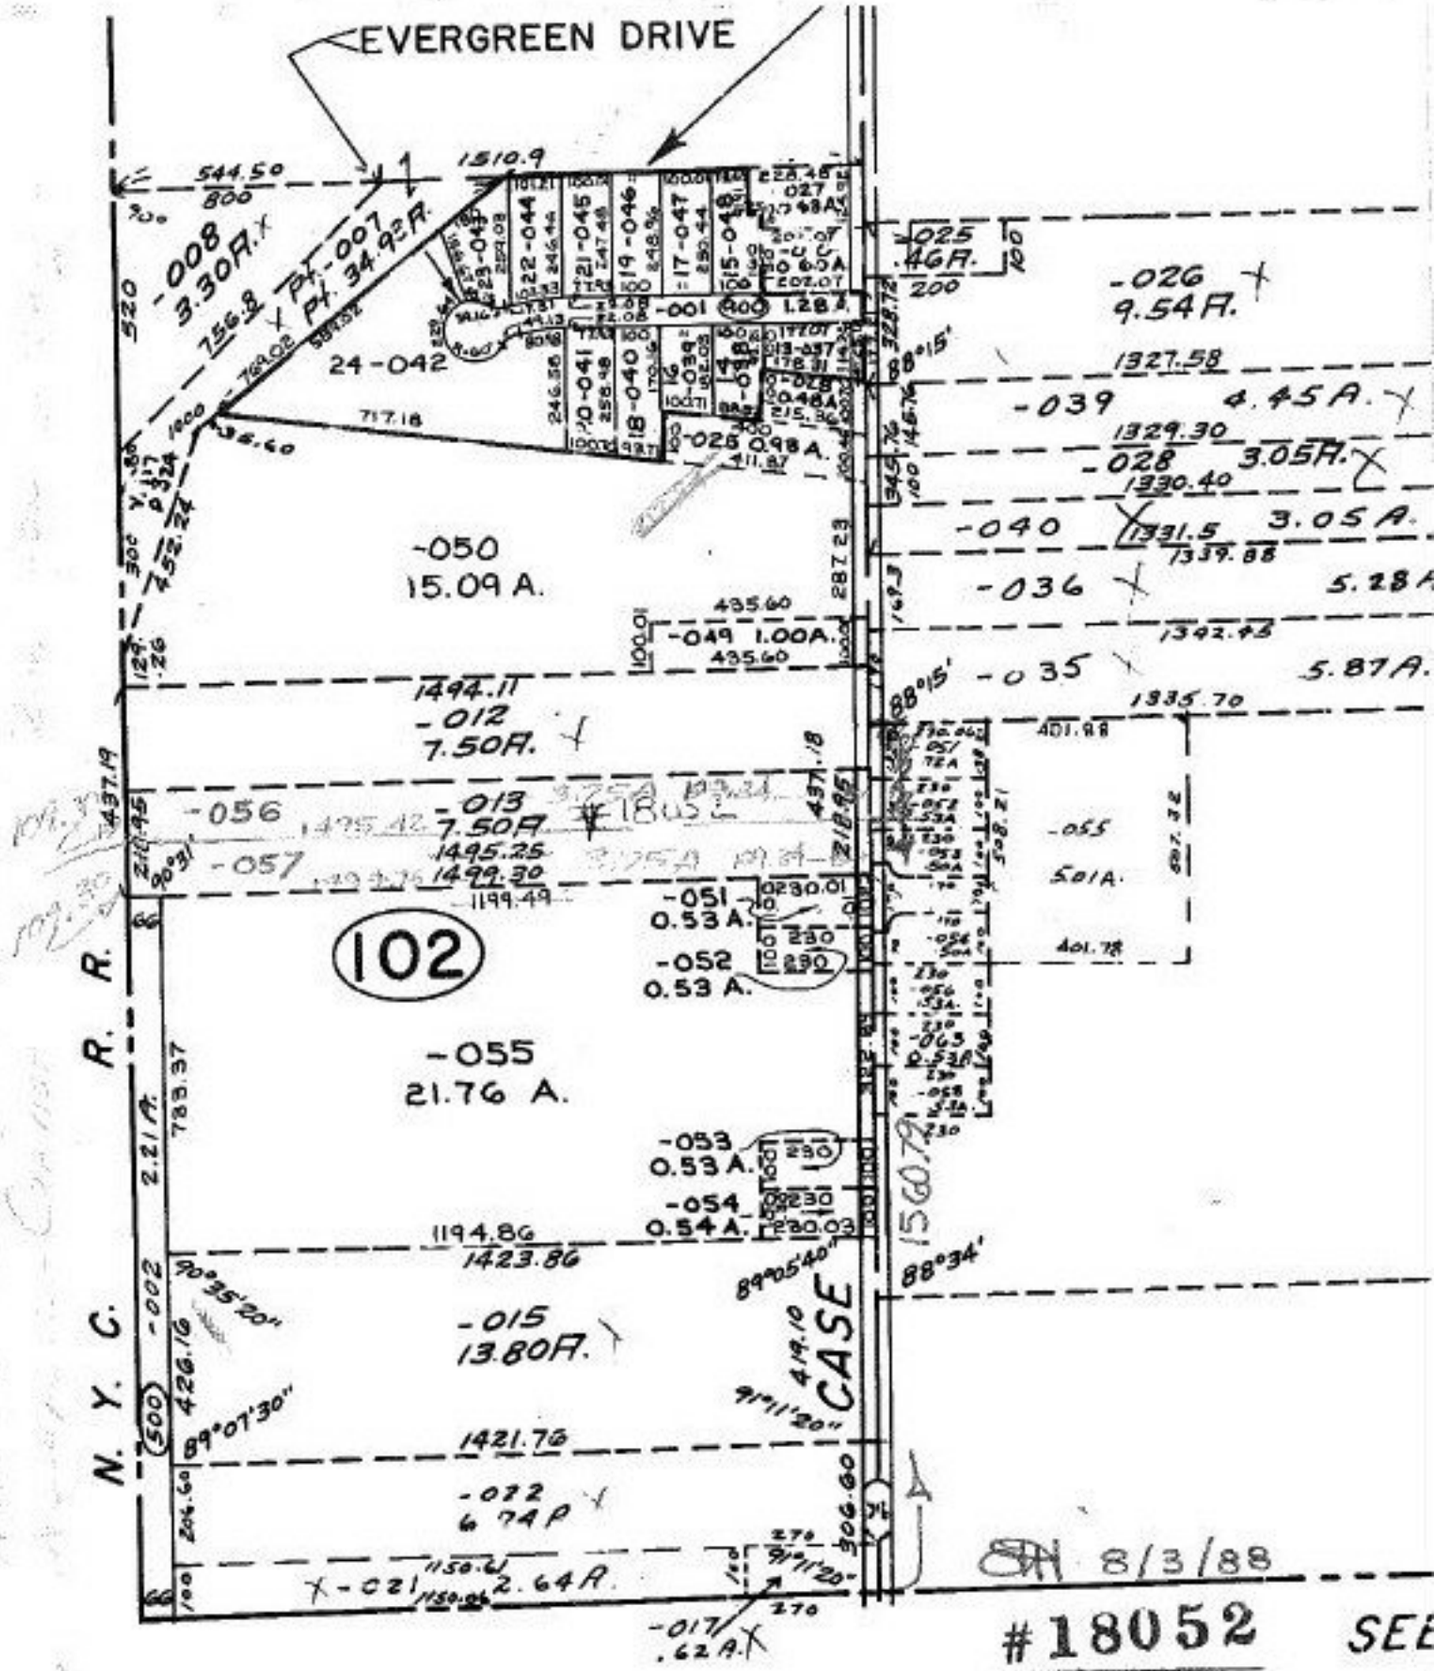

AVON CITY

SCALE: 1" = 400'

APPROVED
LORAIN CO.
MAP DEPT.

DATE 7-29-88

PAGE 4-1

BY

VOID AFTER