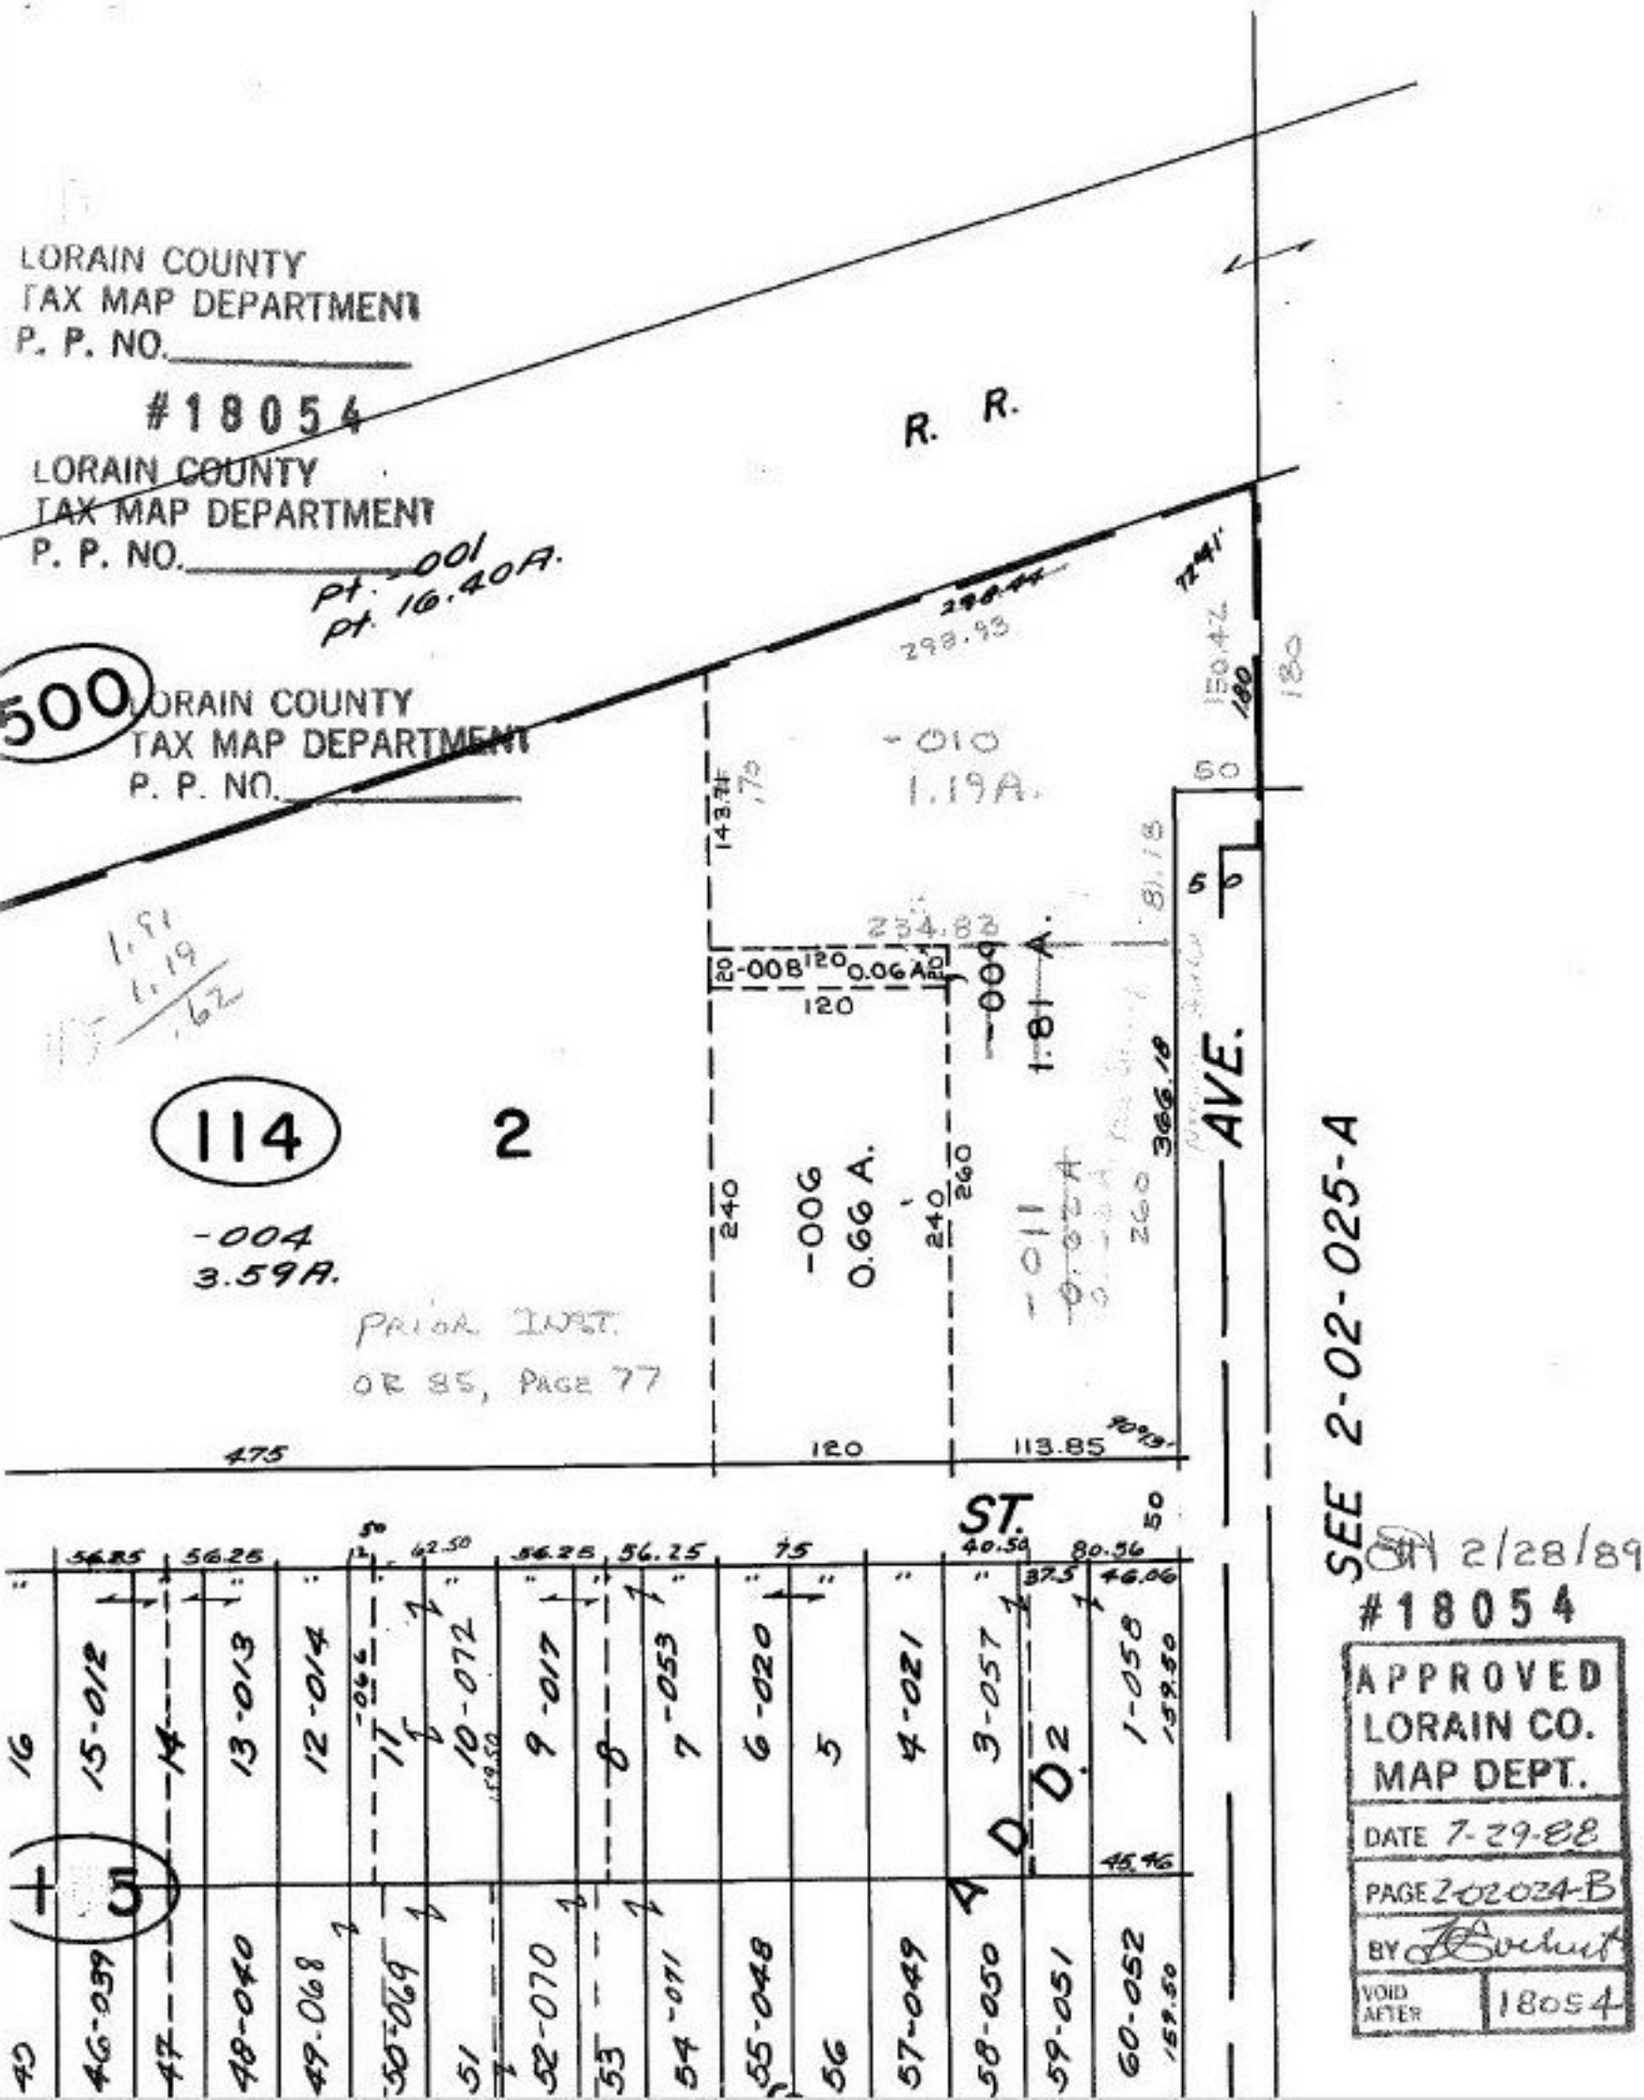
LORAIN COUNTY
TAX MAP DEPARTMENT
P. P. NO.
#18054
LORAIN COUNTY
TAX MAP DEPARTMENT
P. P. NO. -001 pt. 16.40A.
500
LORAIN COUNTY
TAX MAP DEPARTMENT
P. P. NO.
R. R.
-010
1.19A.
-009
1.81 A.
-008
0.06 A.
-006
0.66 A.
-011
0.92A
114
2
-004
3.59A.
PRIOR INST.
OR 85, PAGE 77
AVE.
ST.
SEE 2-02-025-A
2/28/89
#18054
APPROVED
LORAIN CO.
MAP DEPT.
DATE 7-29-88
PAGE 2-02024-B
BY
VOID AFTER
18054