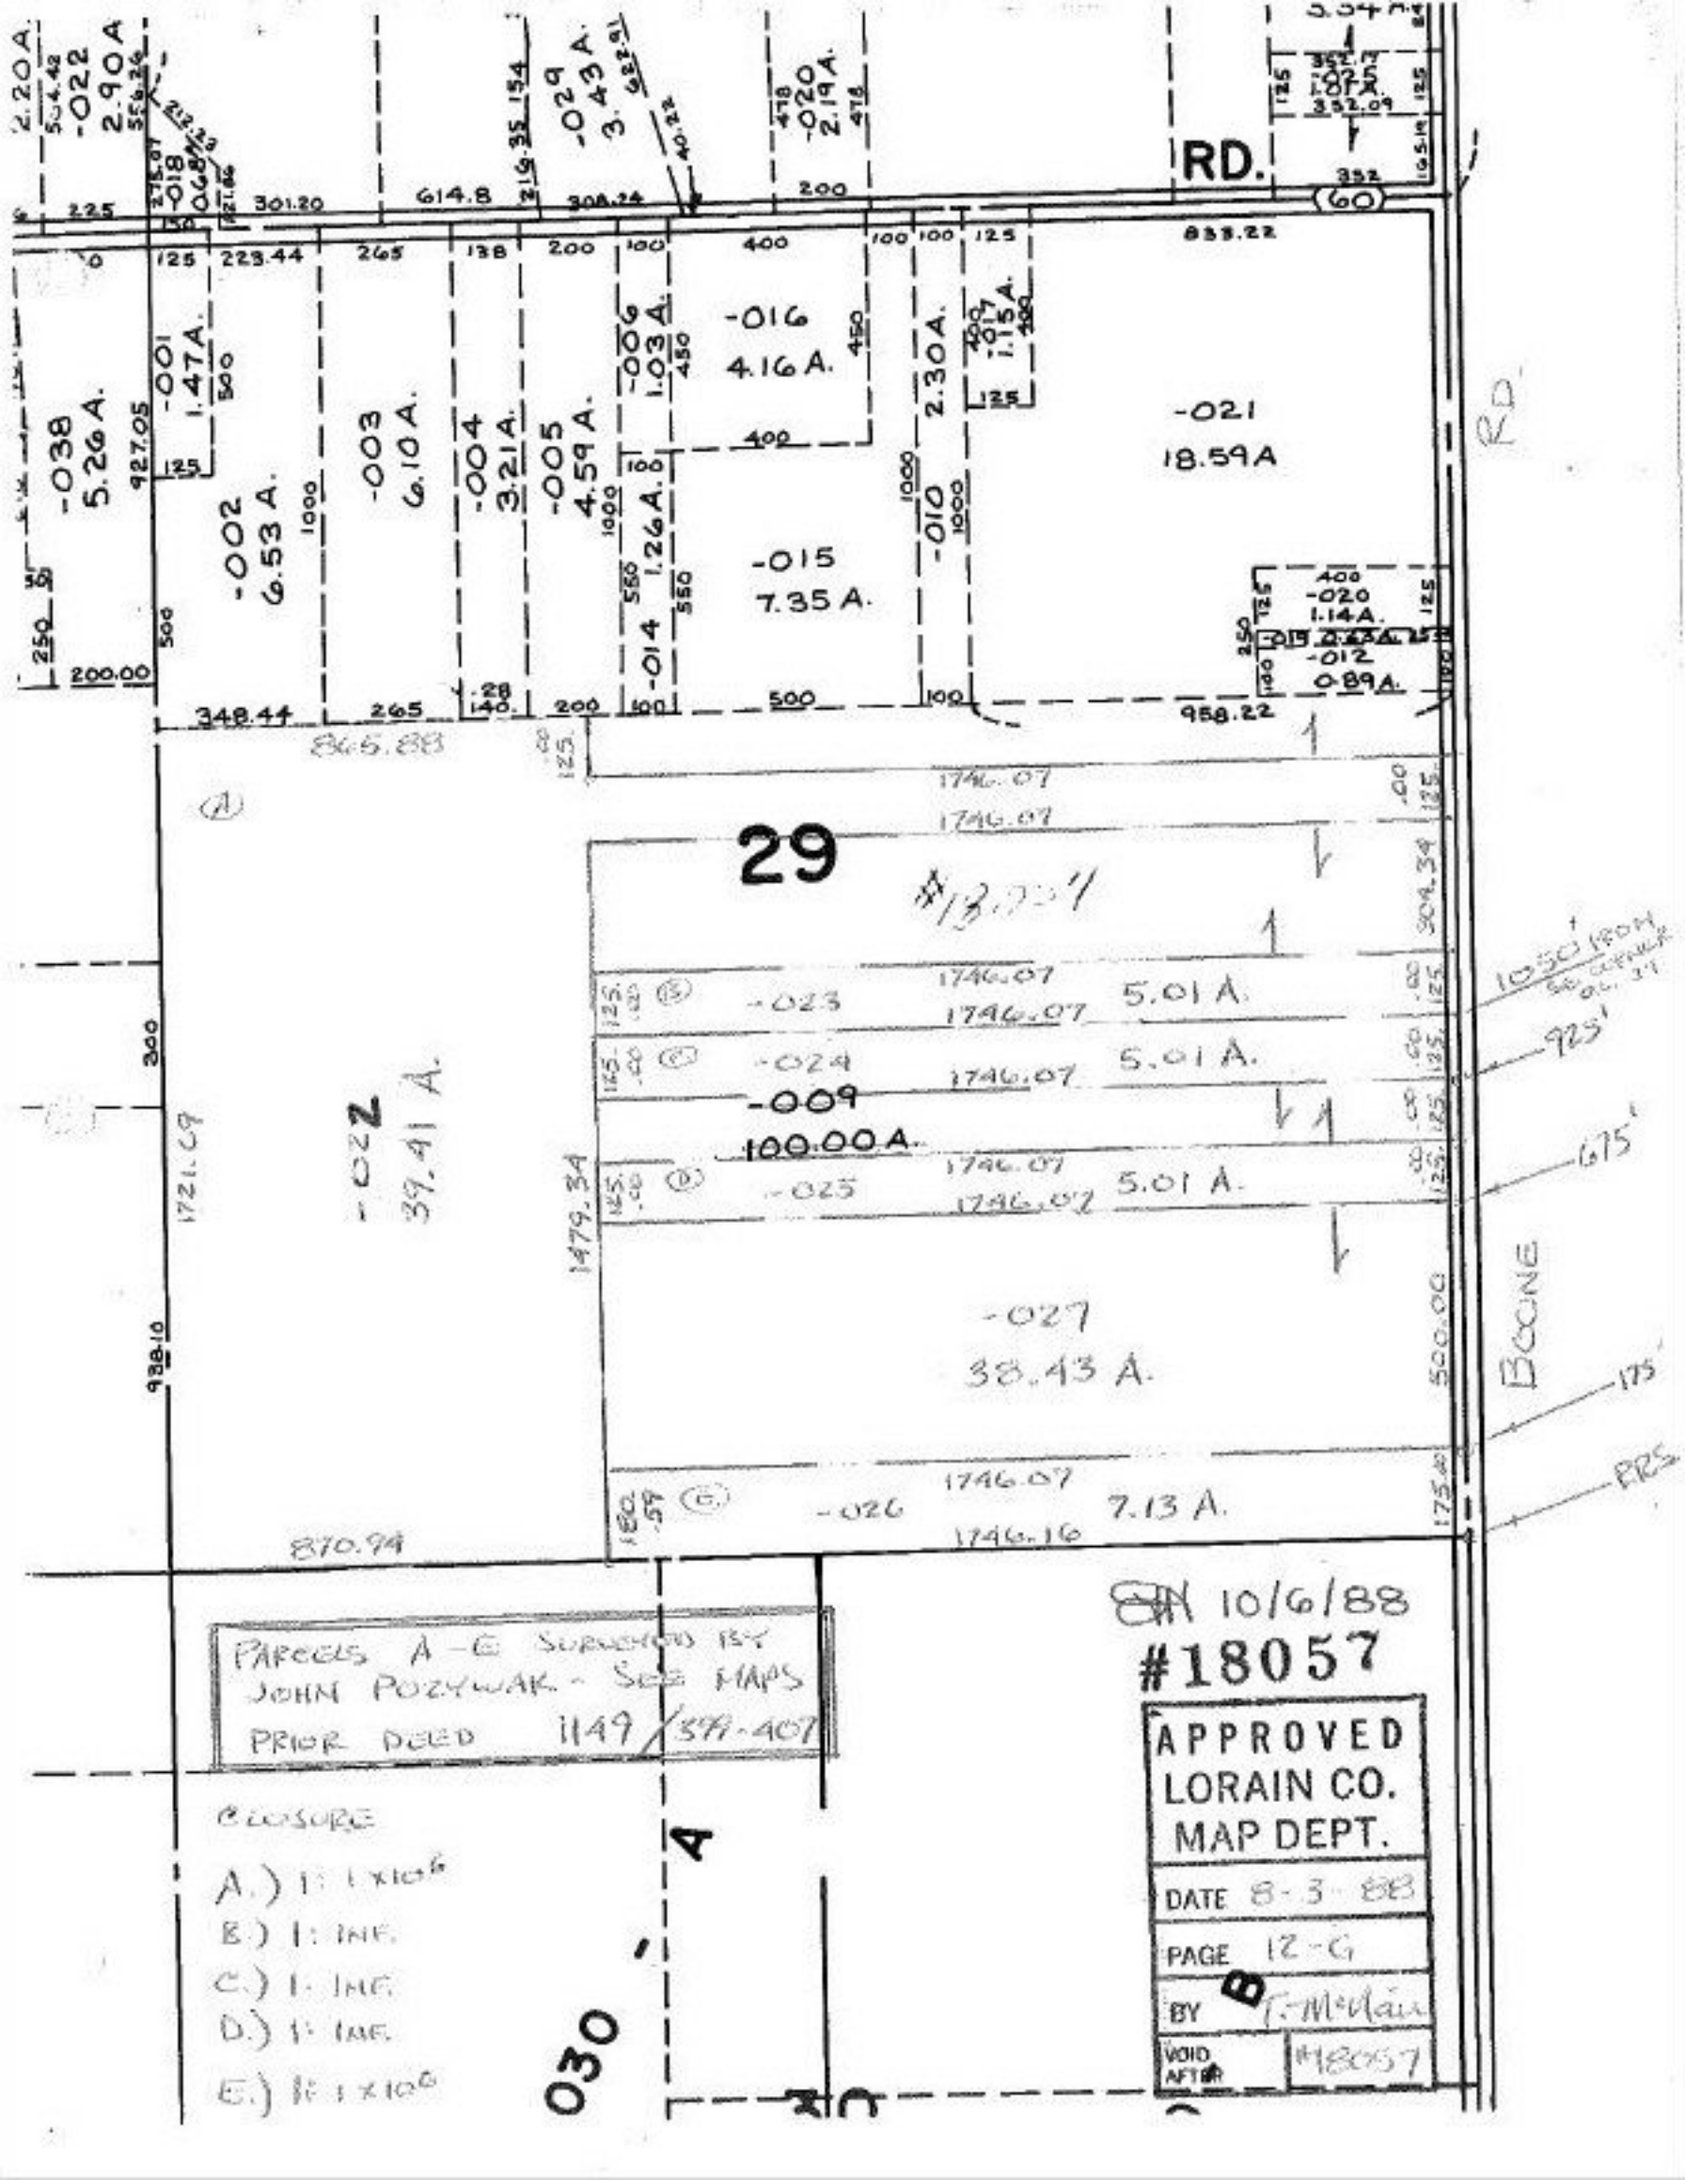
RD.
60
-038
5.26 A.
-001
1.47 A.
-002
6.53 A.
-003
6.10 A.
-004
3.21 A.
-005
4.59 A.
-006
1.03 A.
-016
4.16 A.
-014
1.26 A.
-015
7.35 A.
-010
2.30 A.
-017
1.15 A.
-021
18.59 A
-020
1.14 A.
-012
0.89 A.
29
-023
5.01 A.
-024
5.01 A.
-009
100.00 A.
-025
5.01 A.
-022
39.41 A.
-027
38.43 A.
-026
7.13 A.
1746.07
1746.16
1479.34
1721.09
938.10
870.99
865.88
927.05
958.22
833.22
348.44
BOONE
RD
PARCELS A-G SURVEYED BY JOHN POZYWAK - SEE MAPS
PRIOR DEED 1149/379-407
CLOSURE
A.) 1: 1 x 10^6
B.) 1: INF.
C.) 1: INF.
D.) 1: INF.
E.) 1: 1 x 10^6
10/6/88
#18057
APPROVED
LORAIN CO.
MAP DEPT.
DATE 8-3-88
PAGE 12-G
BY T. McClain
VOID AFTER
#18057