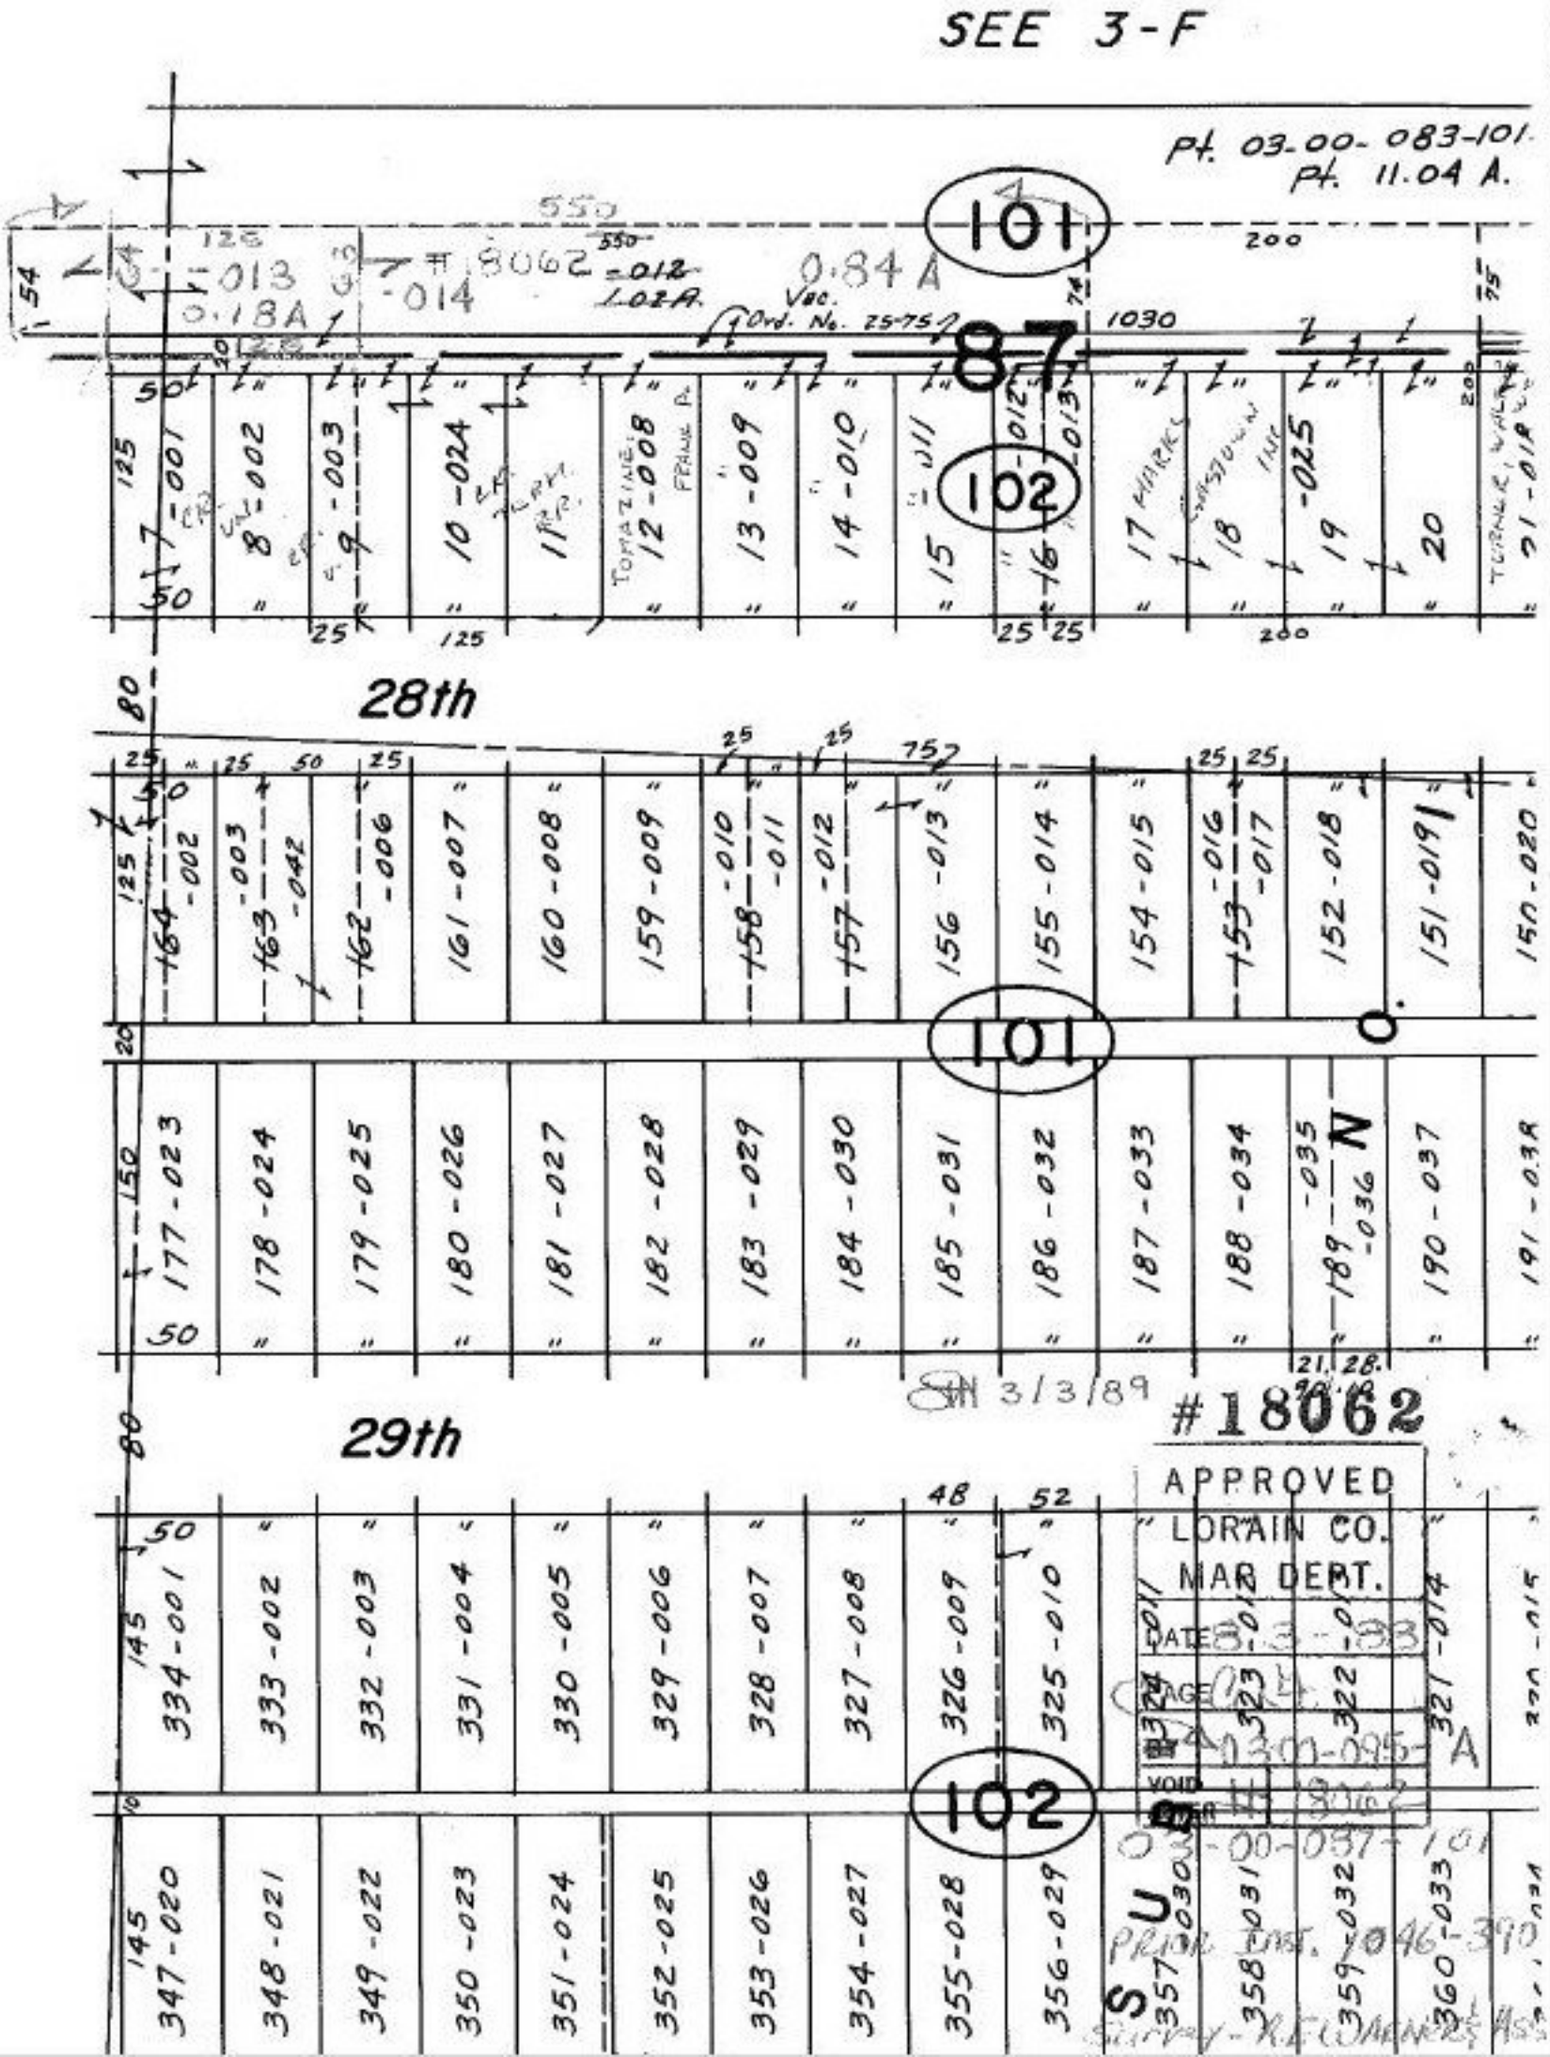
SEE 3-F
Pt. 03-00-083-101
Pt. 11.04 A.
101
87
102
28th
29th
#18062
APPROVED
LORAIN CO.
MAP DEPT.
DATE
PAGE
BY
VOID
03-00-087-101
PRIOR INST. 1046-390
Survey - R.E. Warner's Ass
SH 3/3/89