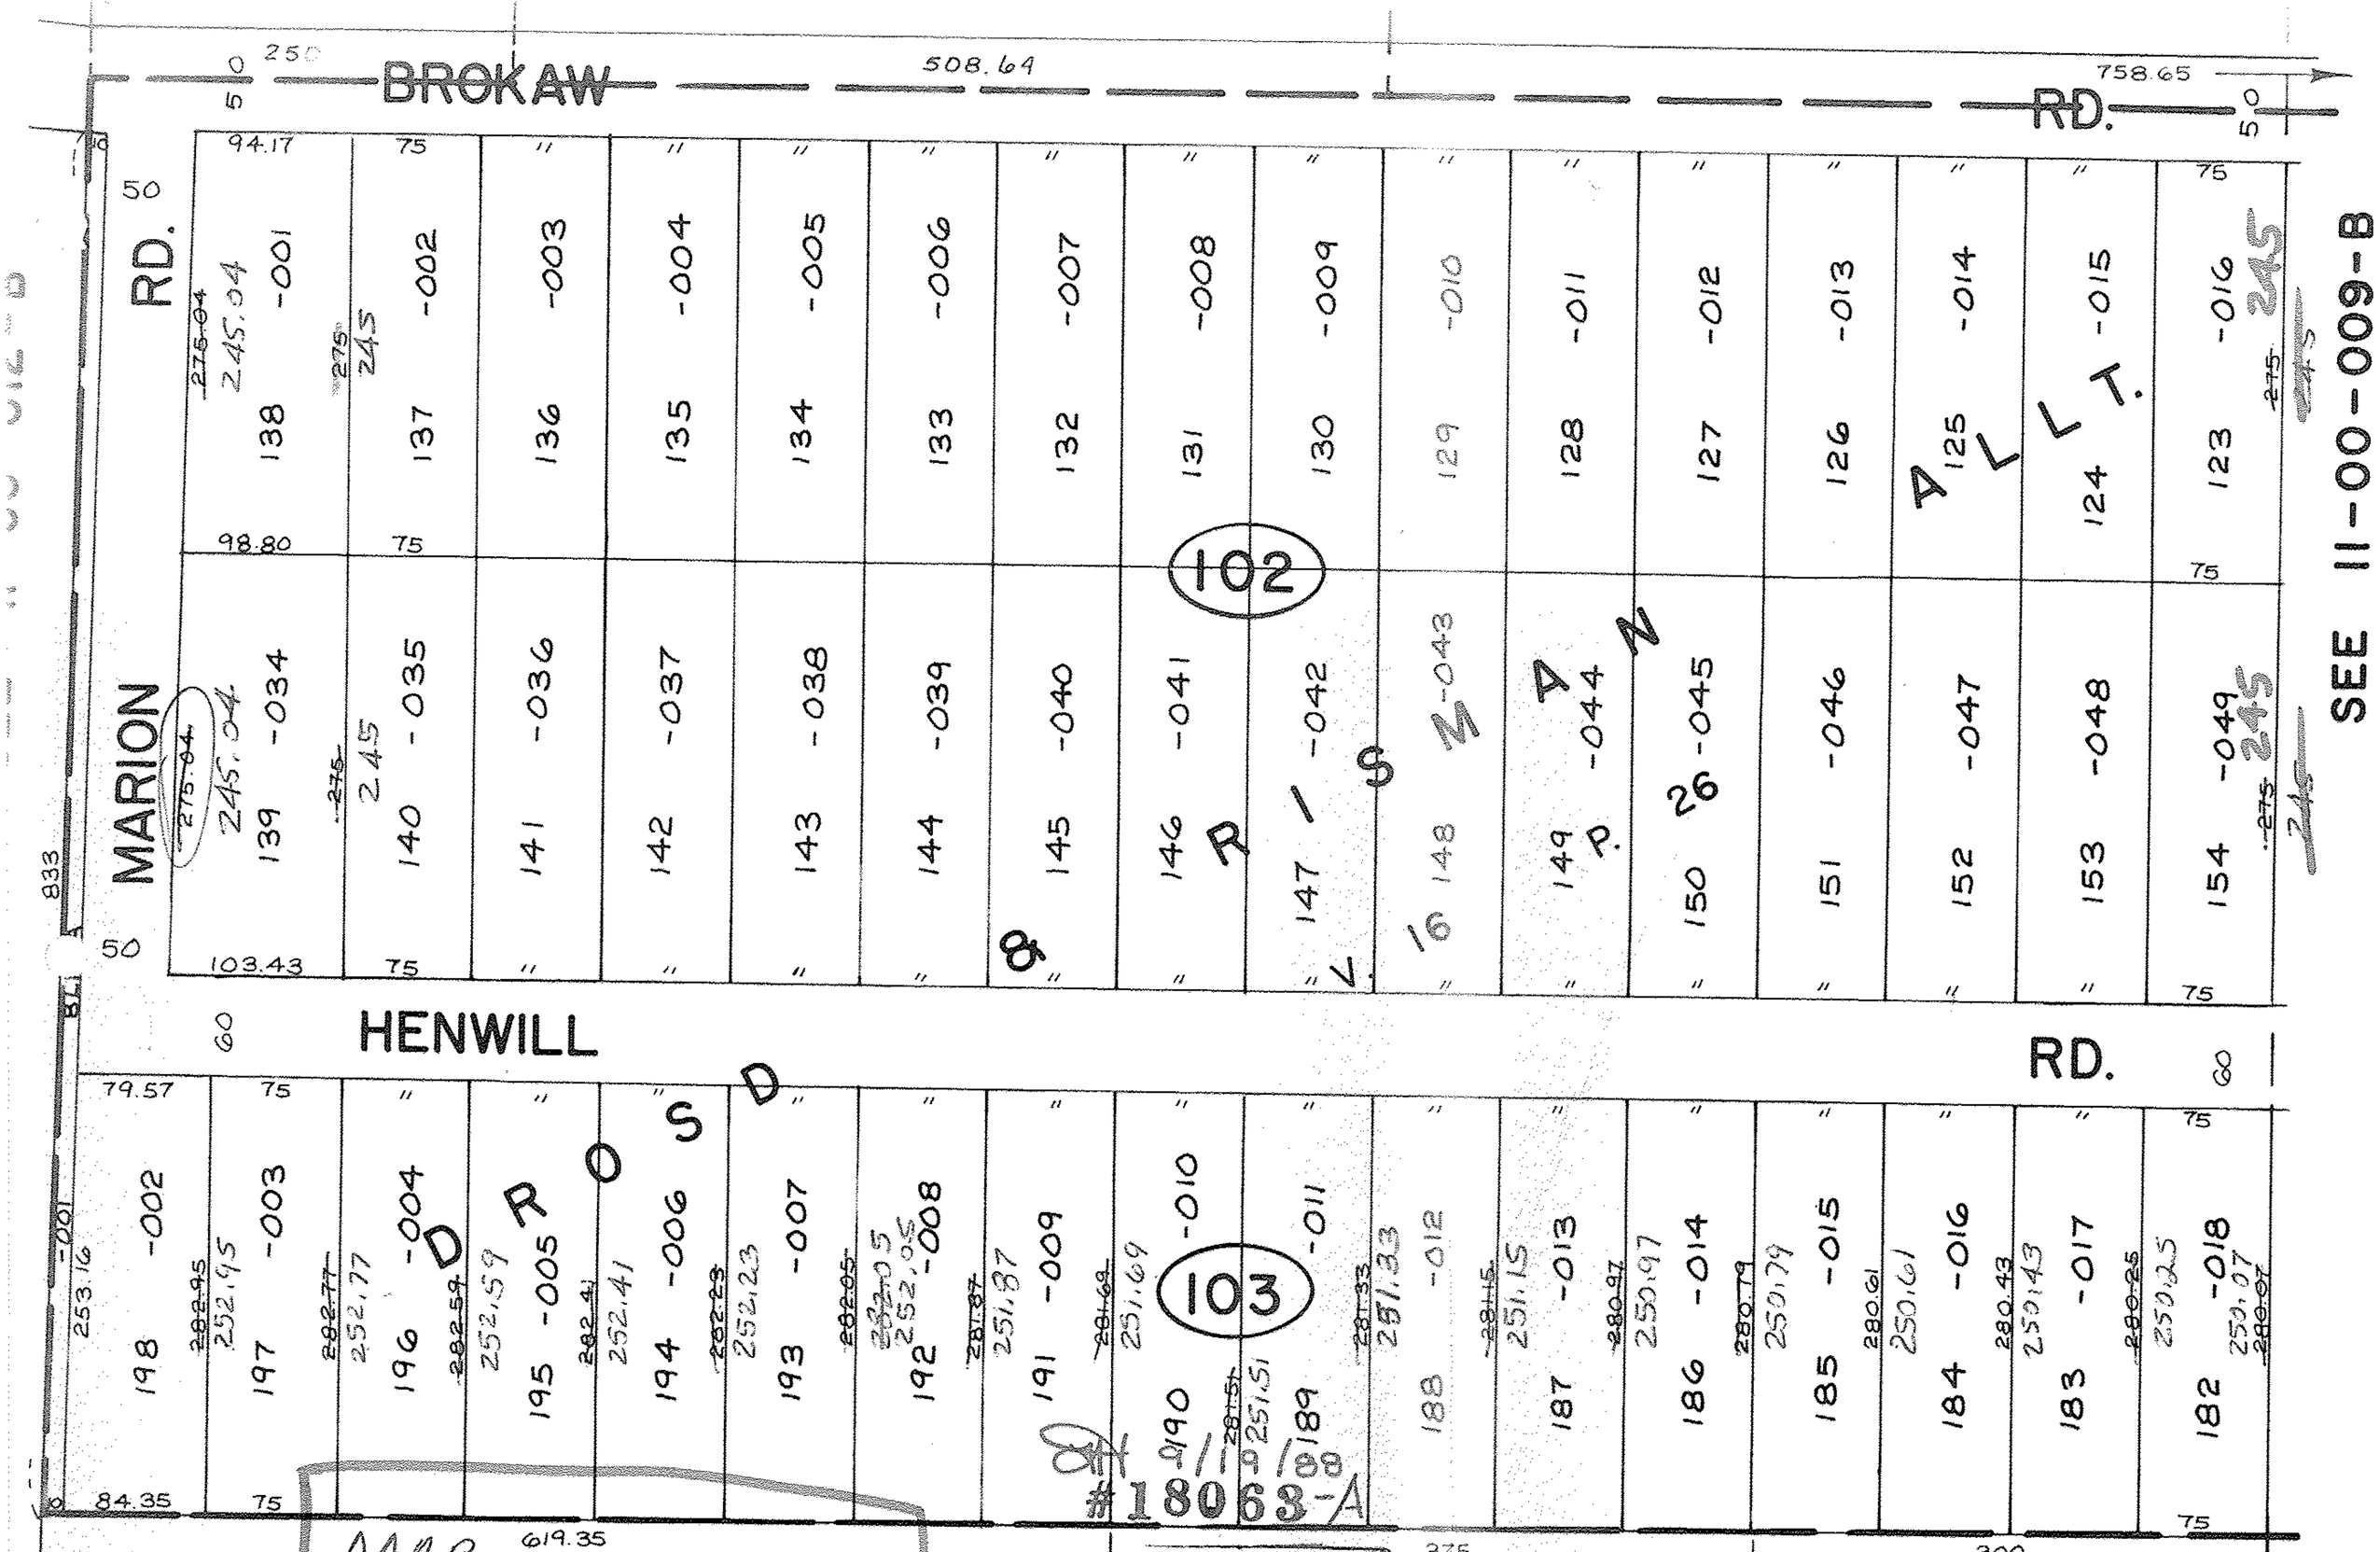

PARCEL DISTANCES MEASURE TO CENTER LINE OF ROAD. STREETS IN PLAT IS DEDICATED. ~~DISTANCES SHOULD READ TO THE SIDE LINE OF THE ROAD.~~

DISTANCES SHOULD READ TO THE SIDE LINE OF THE ROAD

APPROVED
LORAIN CO.
MAP DEPT.
DATE 8-4-88
PAGE 11-00-009A
BY
VOID AFTER