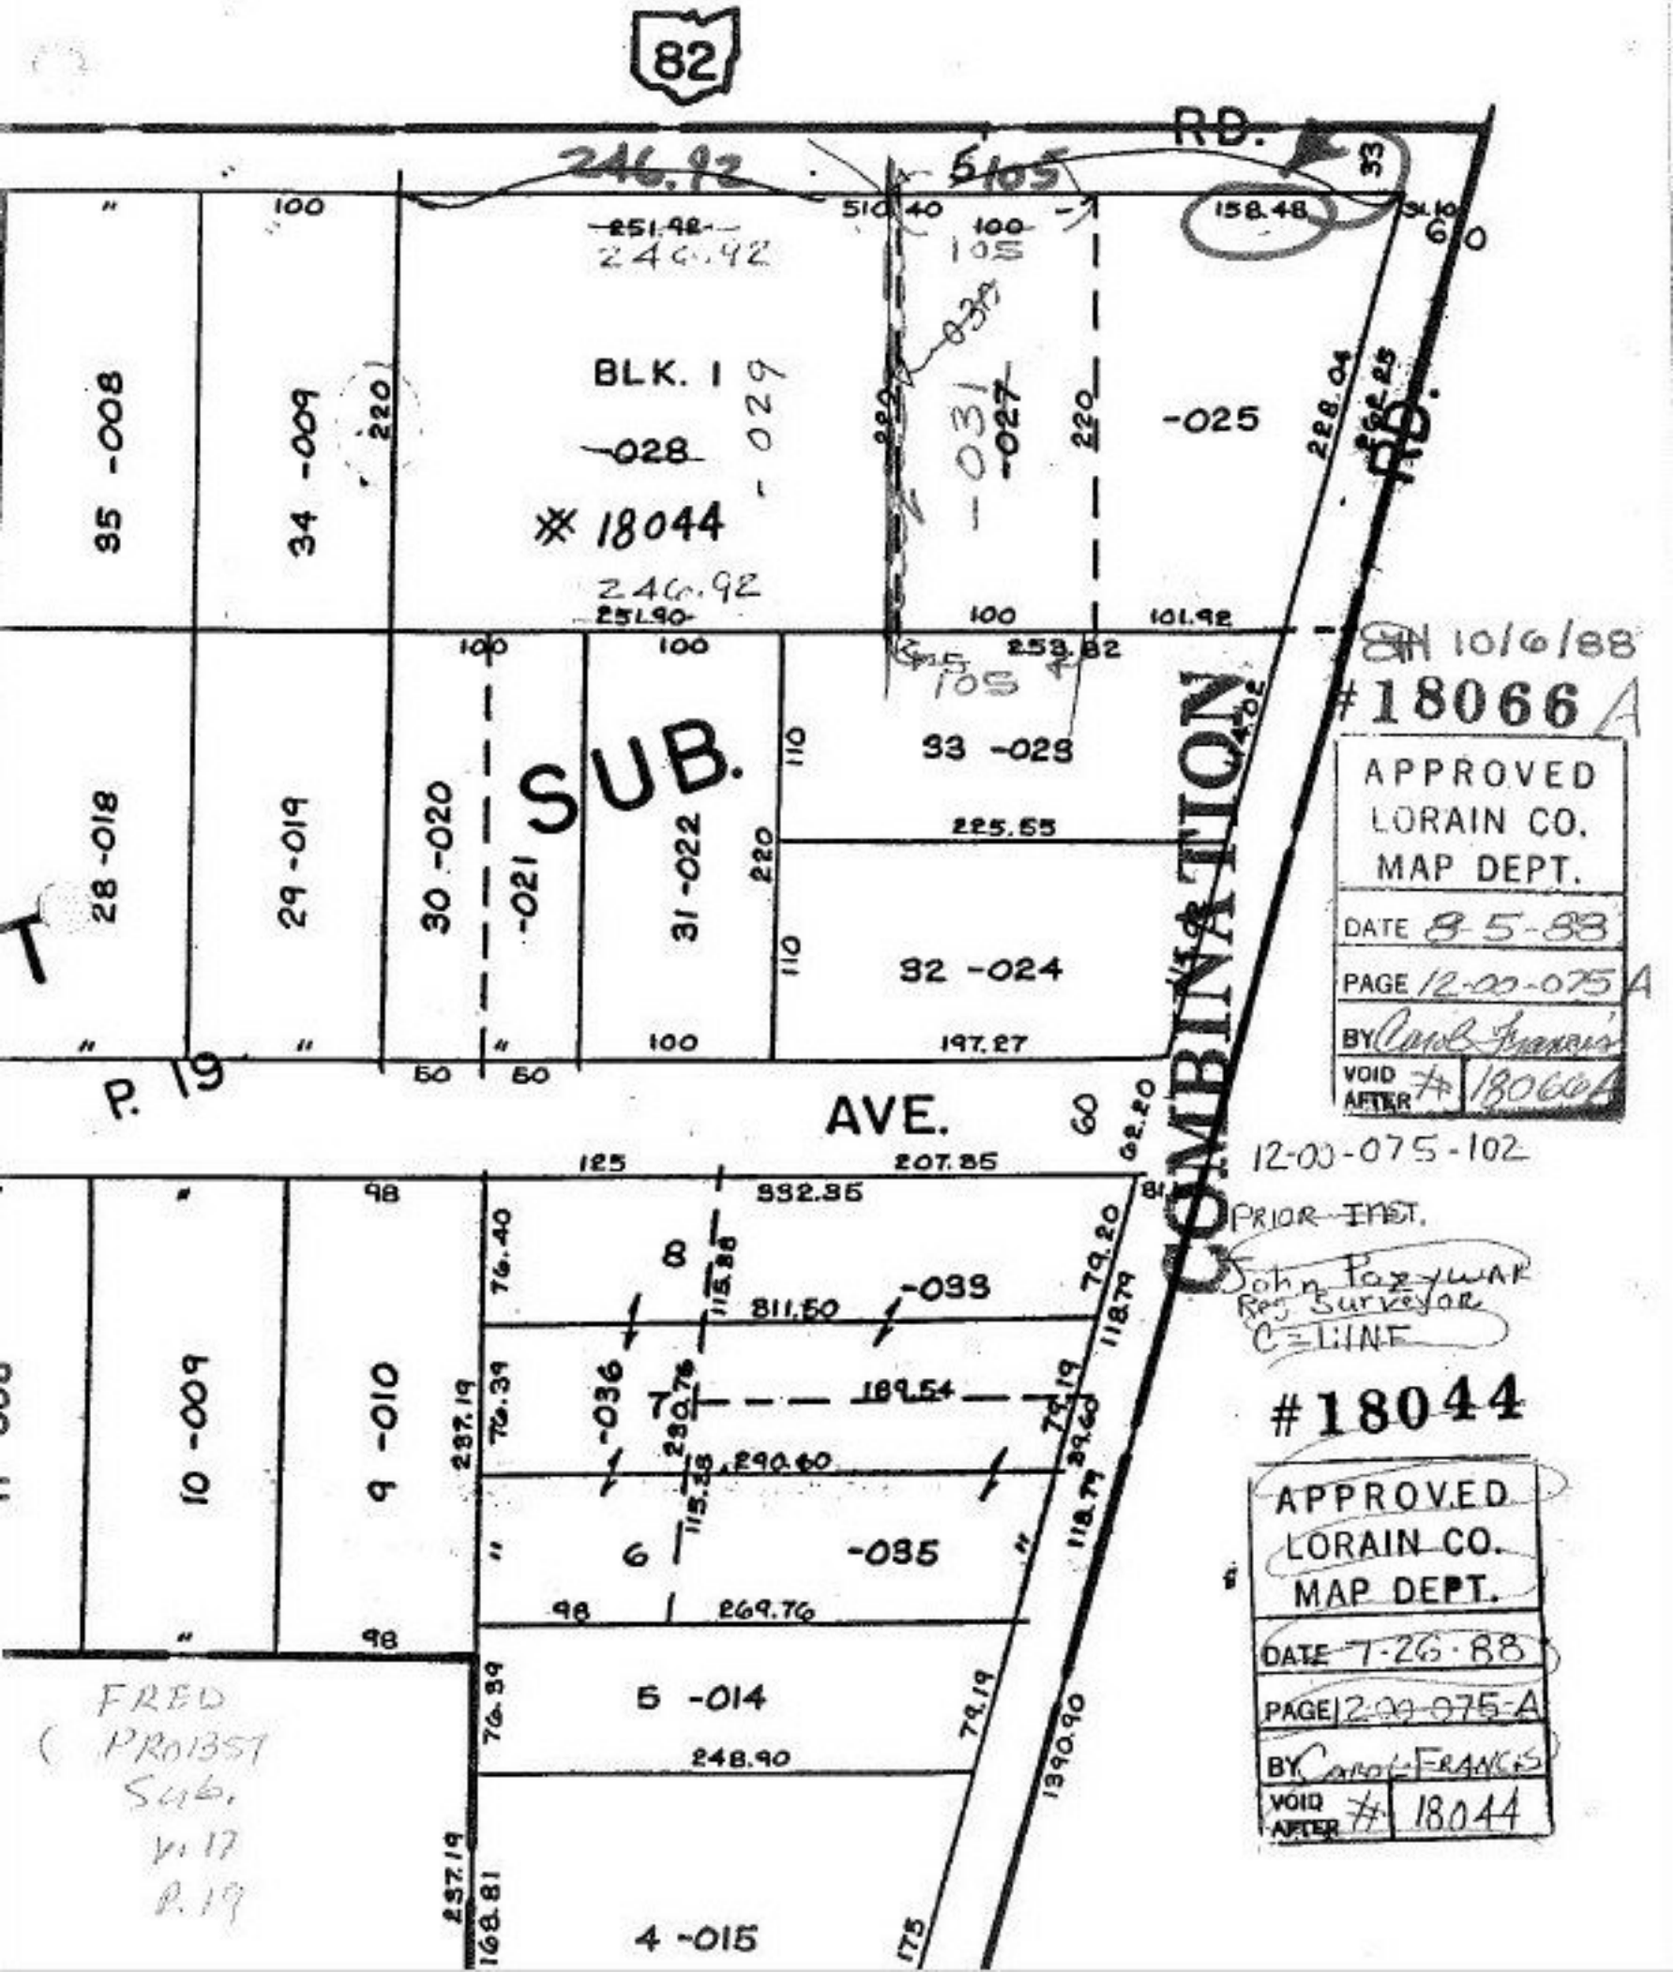
82
RD.
246.92
5105
33
158.48
510.40
100
105
251.92
246.92
BLK. I
-028
-029
-031
-027
-025
35 -008
34 -009
220
228.04
RD.
※ 18044
246.92
251.90
100
101.92
253.82
105
SUB.
33 -023
28 -018
29 -019
30 -020
-021
31 -022
225.55
32 -024
197.27
P. 19
50
50
AVE.
60
62.20
COMBINATION
125
207.85
332.35
98
76.40
8
115.38
-033
811.50
79.20
118.79
10 -009
9 -010
237.19
76.39
-036
7
230.76
189.54
79.19
290.60
115.38
6
-035
118.79
98
269.76
5 -014
76.39
79.19
248.90
1390.90
237.19
168.81
4 -015
175
10/6/88
#18066 A
APPROVED
LORAIN CO.
MAP DEPT.
DATE 8-5-88
PAGE 12-00-075 A
BY Carol Francis
VOID AFTER # 18066A
12-00-075-102
PRIOR INST.
John Pozywak
Reg Surveyor
C=LINE
#18044
APPROVED
LORAIN CO.
MAP DEPT.
DATE 7-26-88
PAGE 12-00-075-A
BY Carol FRANCIS
VOID AFTER # 18044
FRED
(PROBST
Sub.
v. 17
P. 19