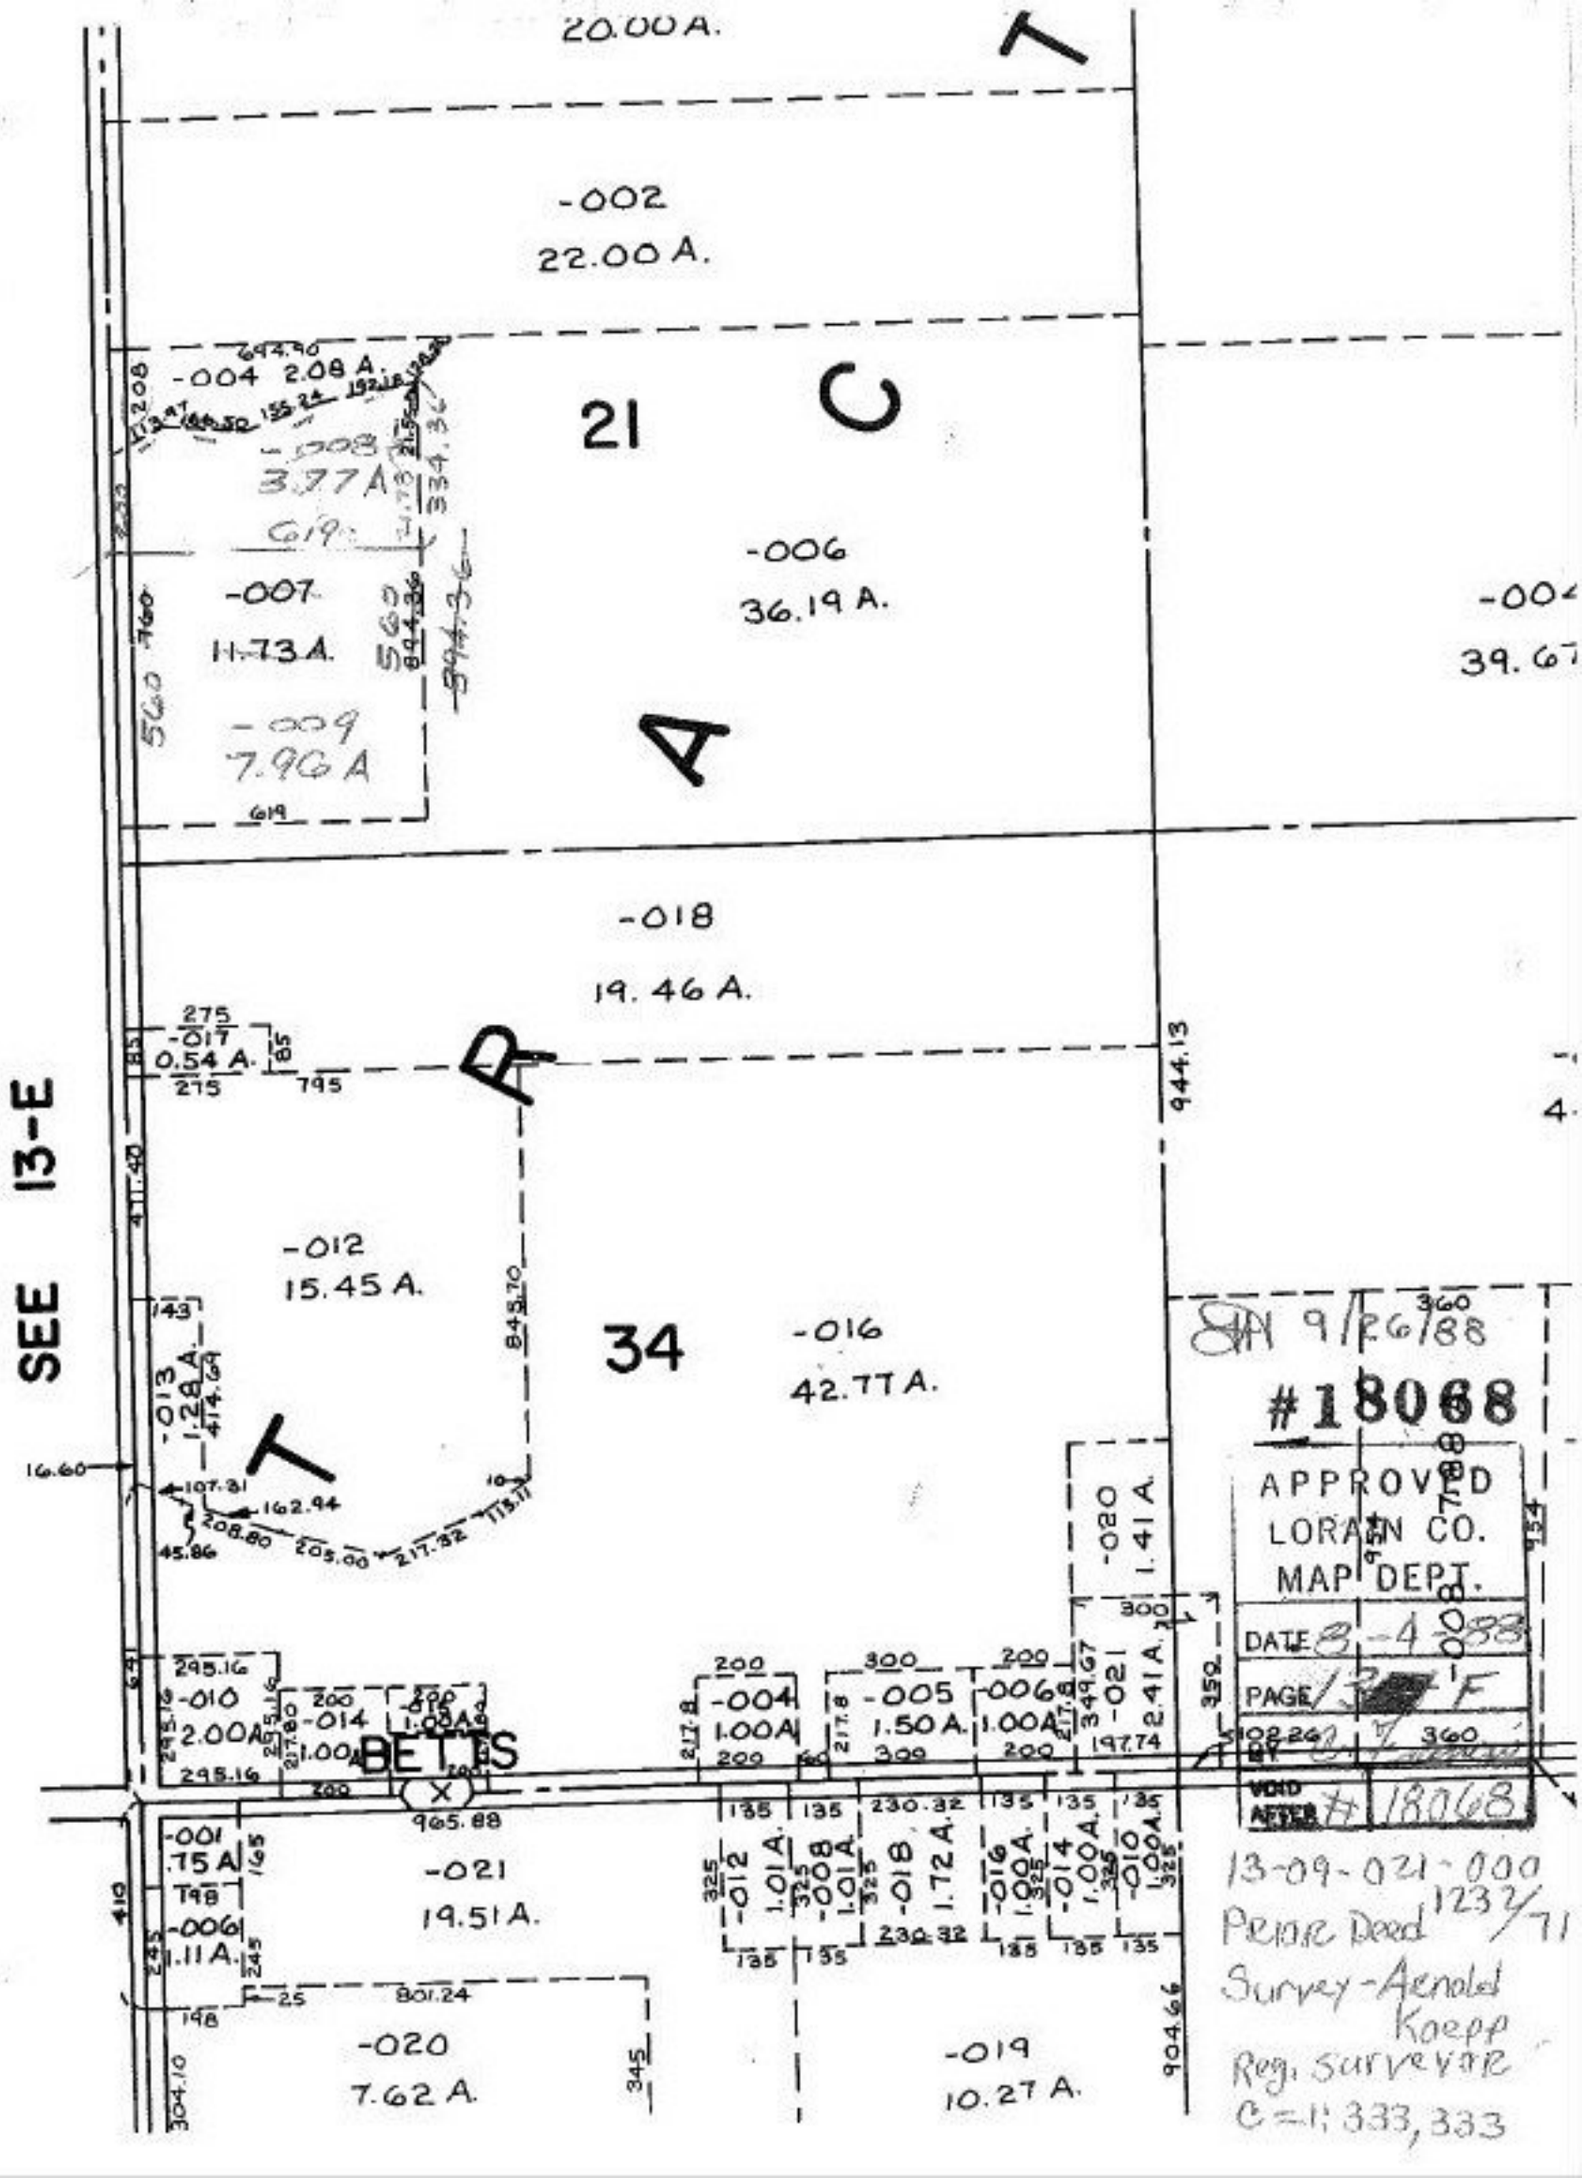
20.00 A.
-002
22.00 A.
-004 2.08 A.
-008
3.77 A
-007
11.73 A.
-009
7.96 A
21
C
A
-006
36.19 A.
-018
19.46 A.
-017
0.54 A.
-012
15.45 A.
-013
1.28 A.
34
-016
42.77 A.
-020
1.41 A.
-021
2.41 A.
-010
2.00 A.
-014
1.00 A.
-004
1.00 A.
-005
1.50 A.
-006
1.00 A.
BETTS
-001
.75 A
T98
-006
1.11 A.
-021
19.51 A.
-012
1.01 A.
-008
1.01 A.
-018
1.72 A.
-016
1.00 A.
-014
1.00 A.
-010
1.00 A.
-020
7.62 A.
-019
10.27 A.
SEE 13-E
#18068
APPROVED
LORAIN CO.
MAP DEPT.
DATE 8-4-88
PAGE 1 F
VOID AFTER # 18068
13-09-021-000
Prior Deed 1232/71
Survey - Arnold Koepp
Reg. Surveyor
C-1; 333, 333