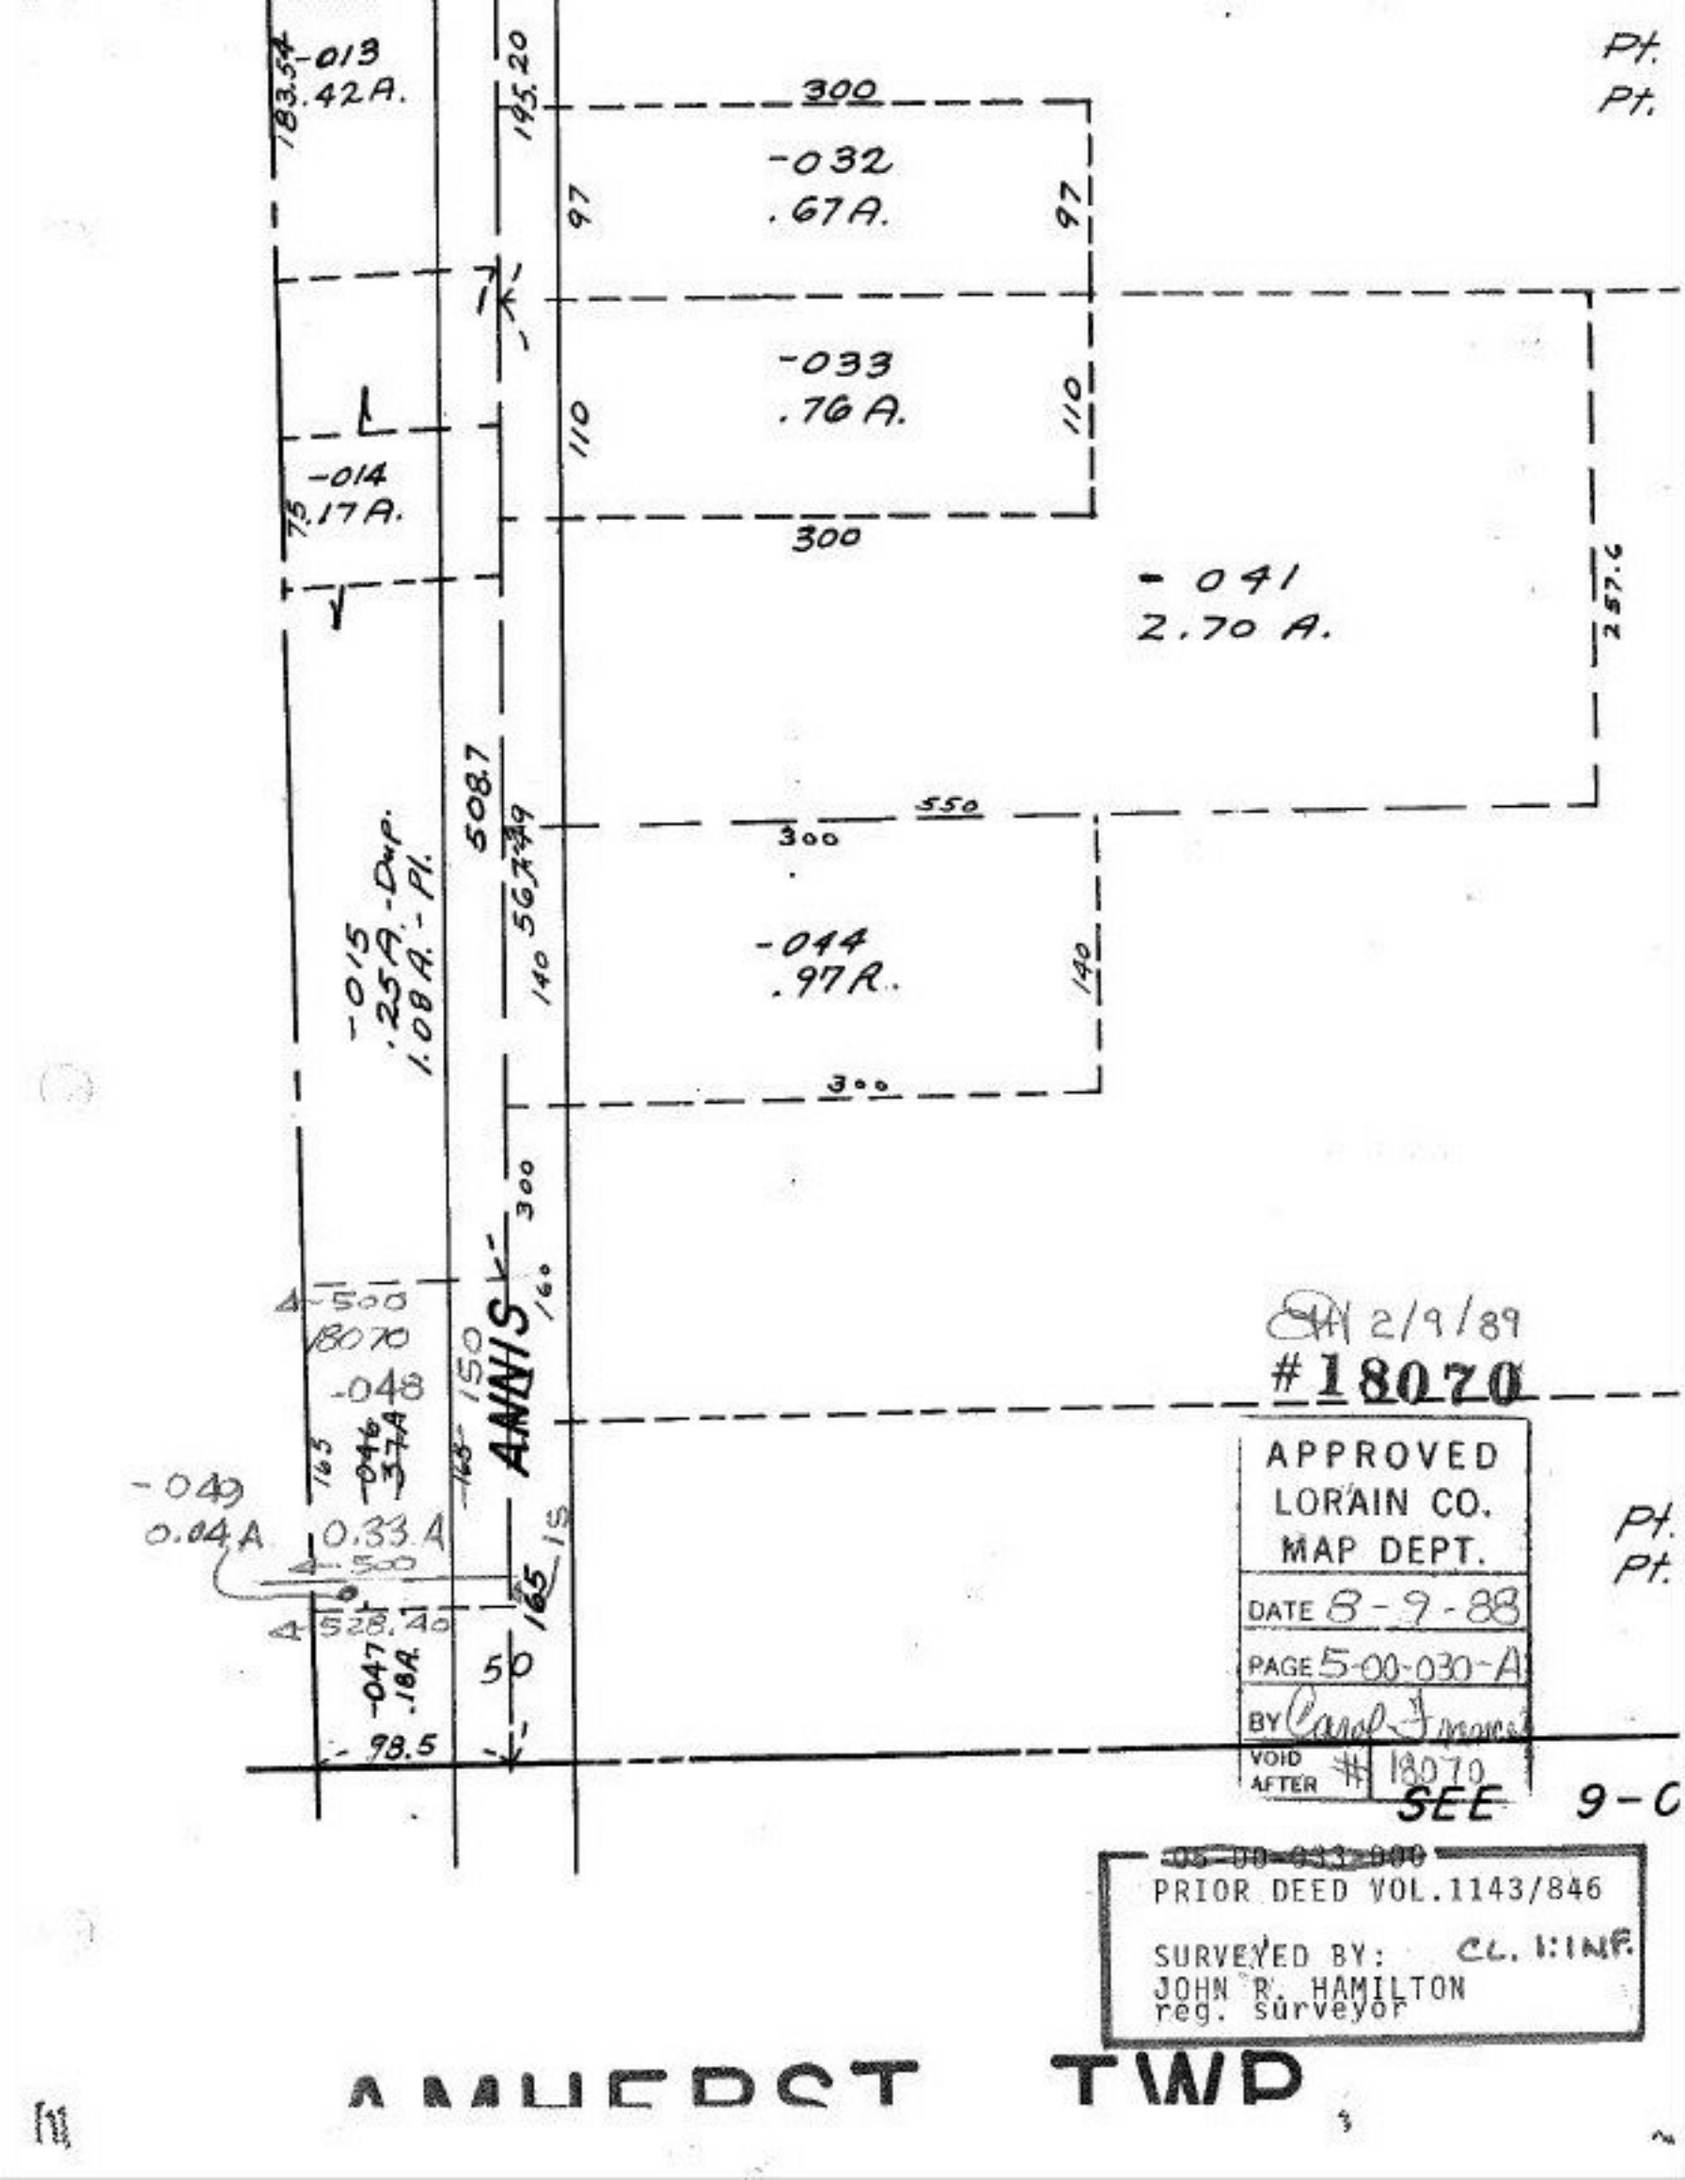
-013
.42A.
183.54
145.20
300
-032
.67A.
97
97
-033
.76A.
110
110
-014
.17A.
75
300
-041
2.70 A.
257.6
550
300
-044
.97R.
140
140
300
-015
.25A.-Dup.
1.08A.-Pt.
508.7
56.739
-048
.37A
-049
0.04A
0.33A
4-500
4-528.40
-047
.18A.
98.5
50
165
165
150
300
160
ANNIS
4-500
18070
Pt.
Pt.
Pt.
Pt.
2/9/89
#18070
APPROVED
LORAIN CO.
MAP DEPT.
DATE 8-9-88
PAGE 5-00-030-A
BY Carol J. Moore
VOID AFTER # 18070
SEE 9-C
05-00-033.000
PRIOR DEED VOL.1143/846
SURVEYED BY: CL. INF.
JOHN R. HAMILTON
reg. surveyor
AMHERST TWP