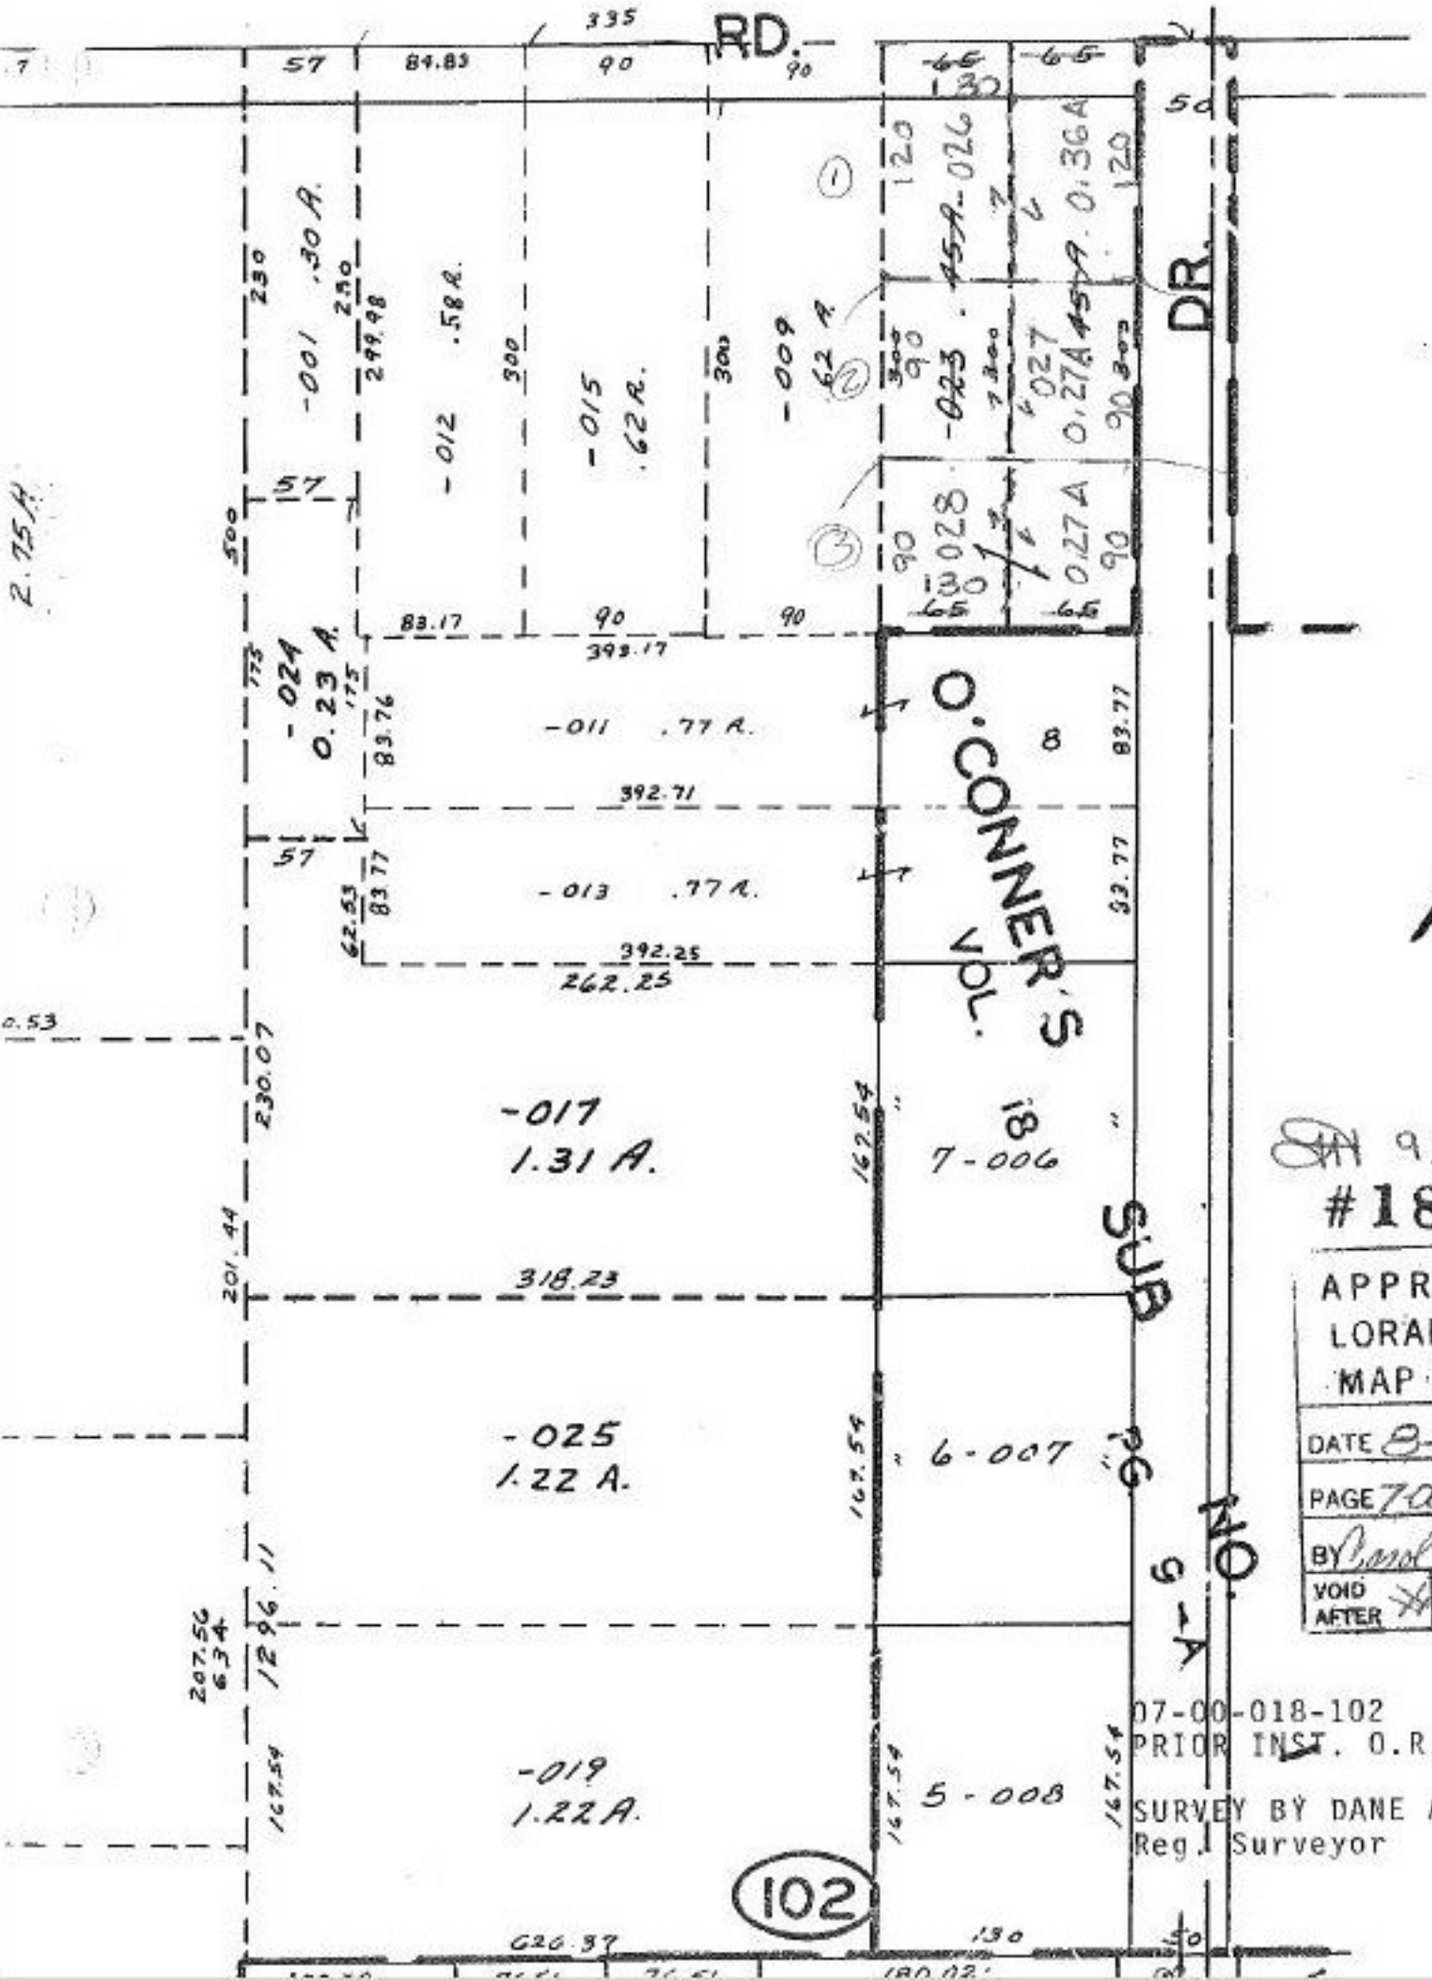

9/12/88
#18074

APPROVED
LORAIN CO.
MAP DEPT.
DATE 8-11-88
PAGE 700-018B
BY Carol Francis
VOID AFTER 18074

07-00-018-102
PRIOR INST. O.R.VOL.51
PG. 551
SURVEY BY DANE A.HAPONEK
Reg. Surveyor