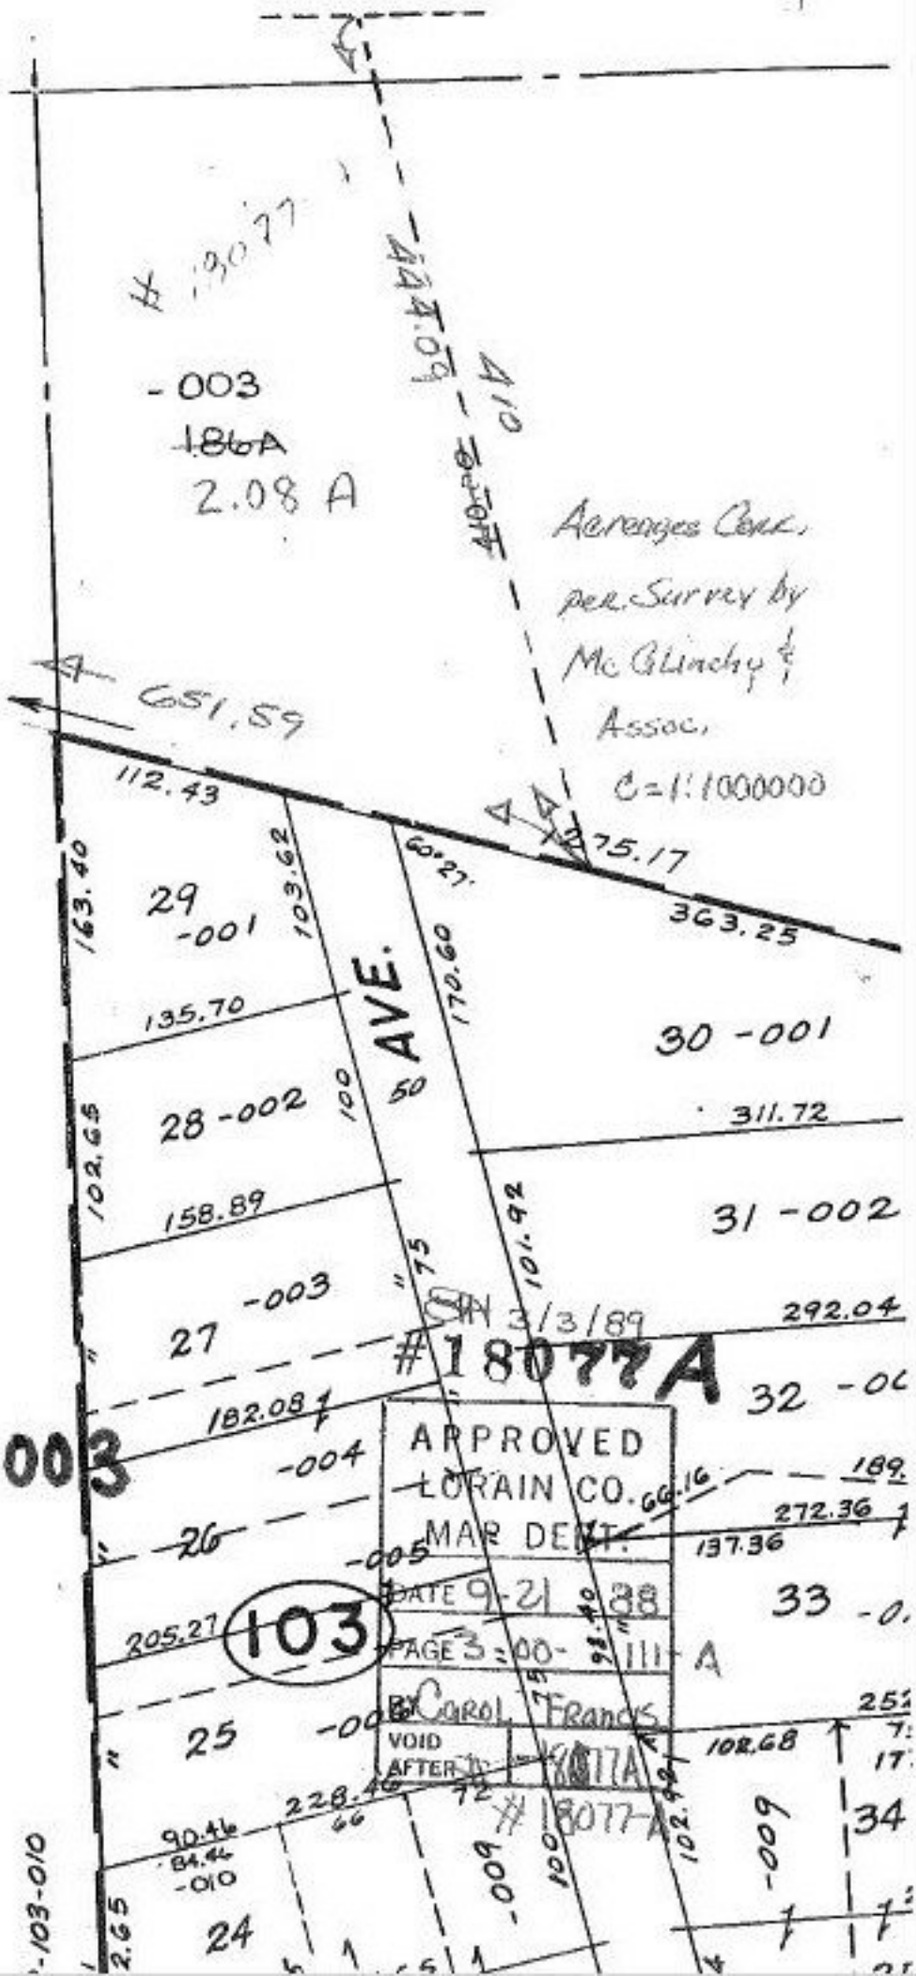Acreages
Corr.
03-00-111-101-003