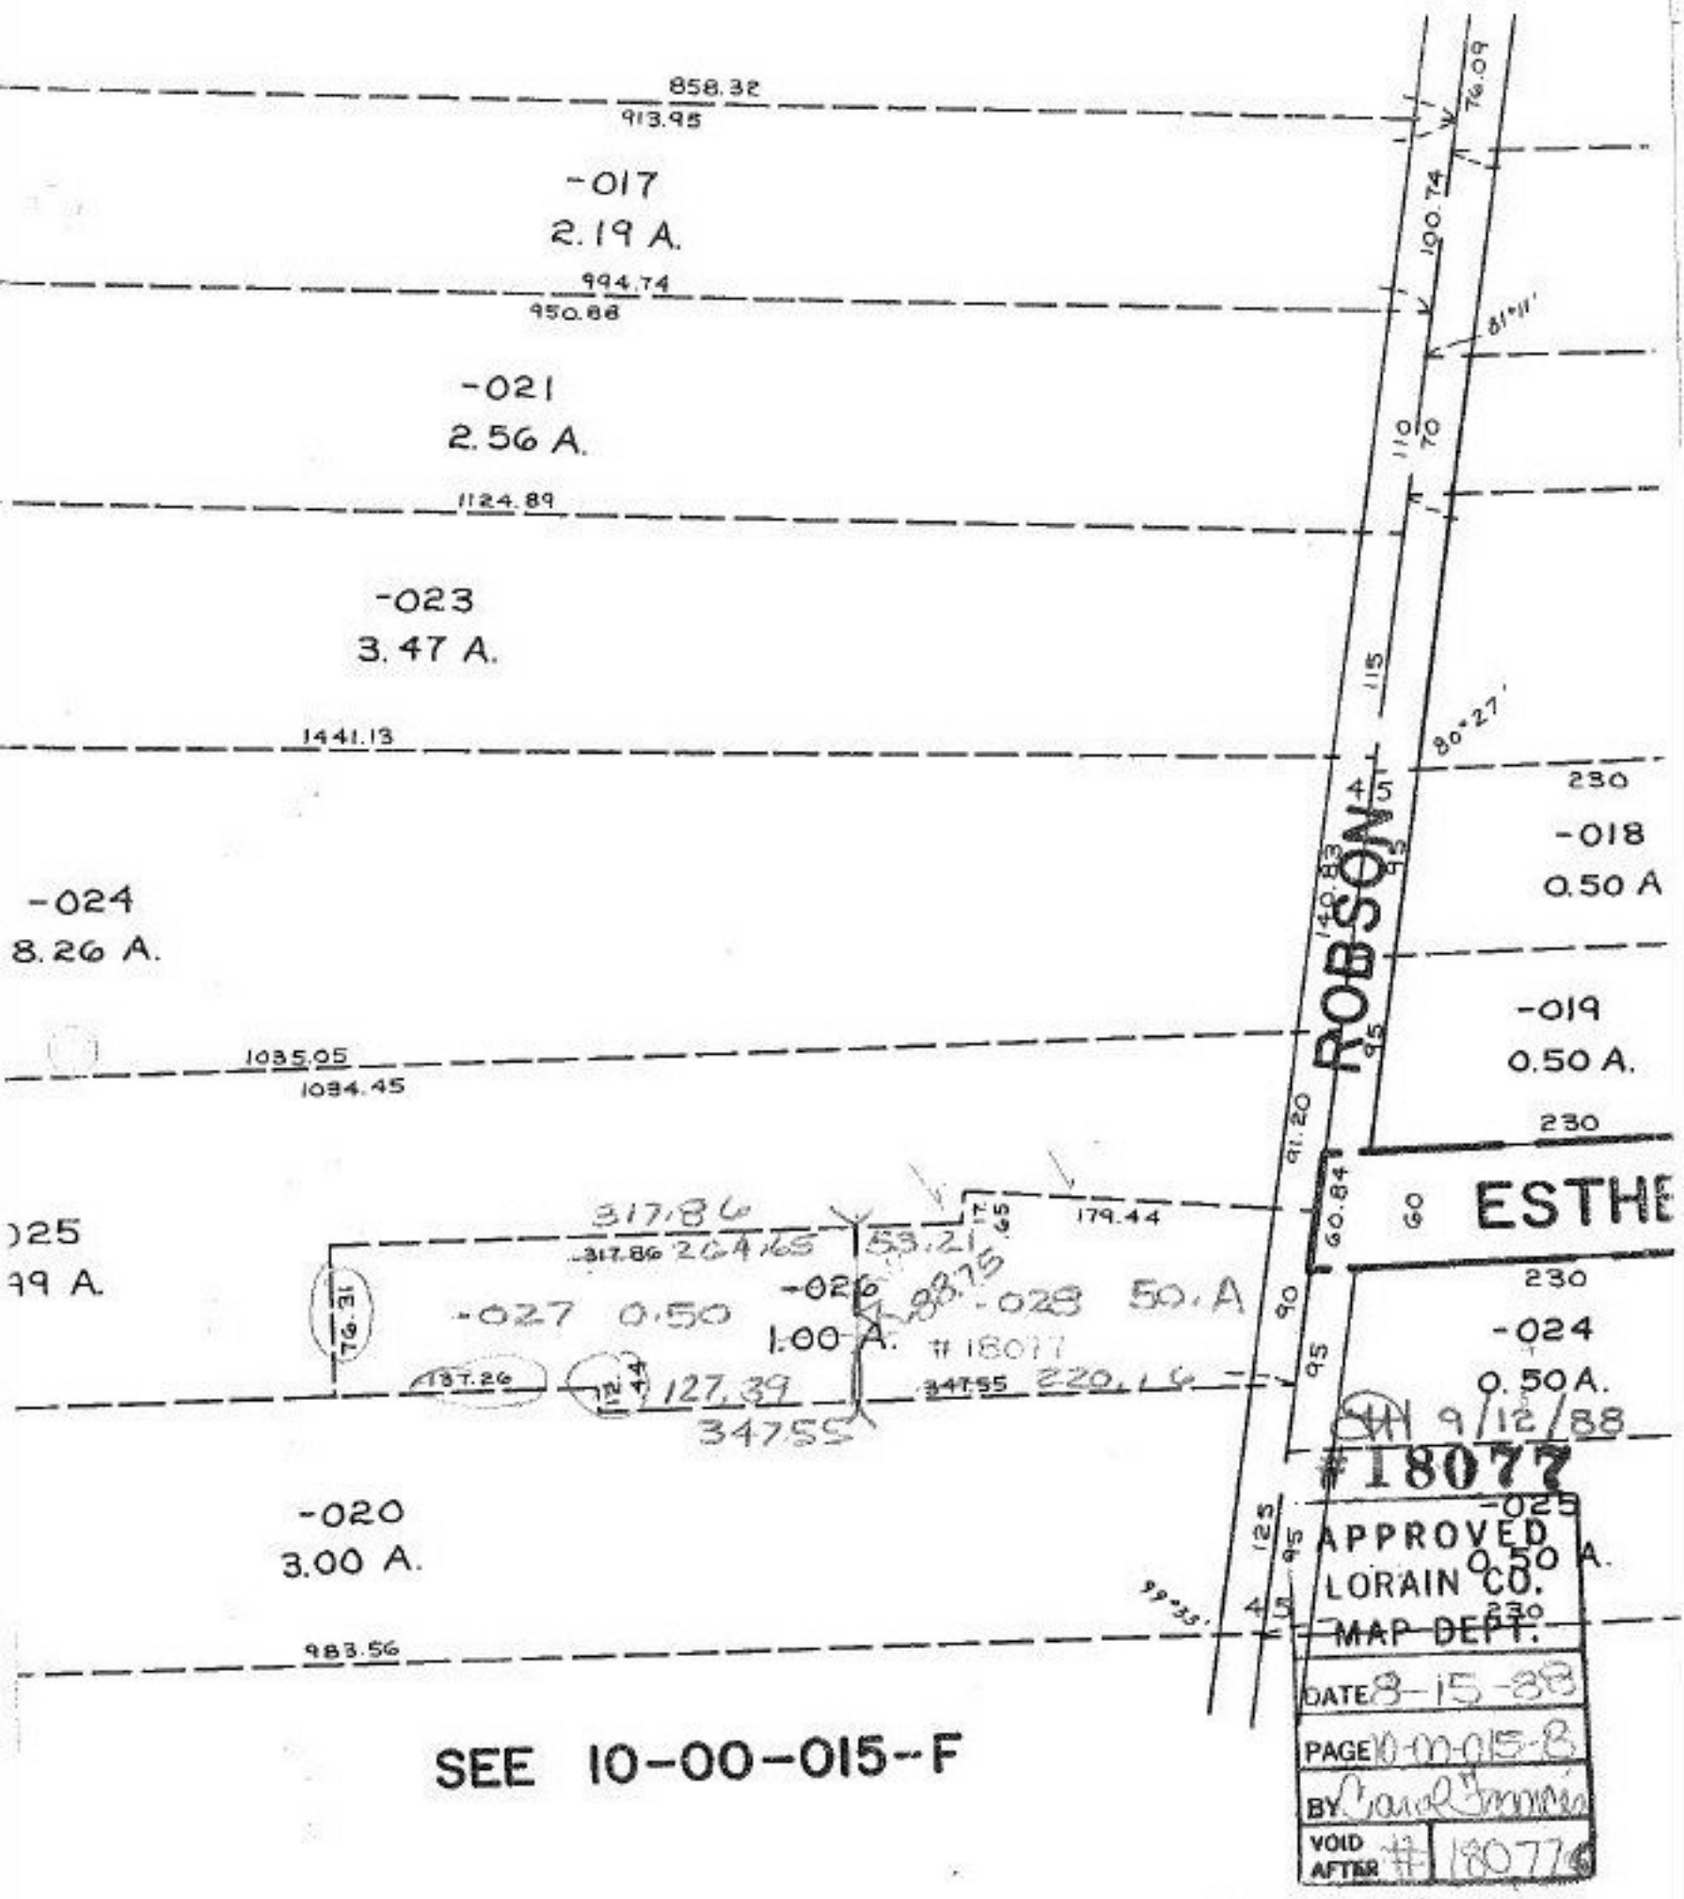

SEE 10-00-015-F

10-00-015-102
PRIOR INST. 1264 PG. 81
SURVEYED BY GARY E. PENFOUND
Reg. Surveyor
C = 1.INF