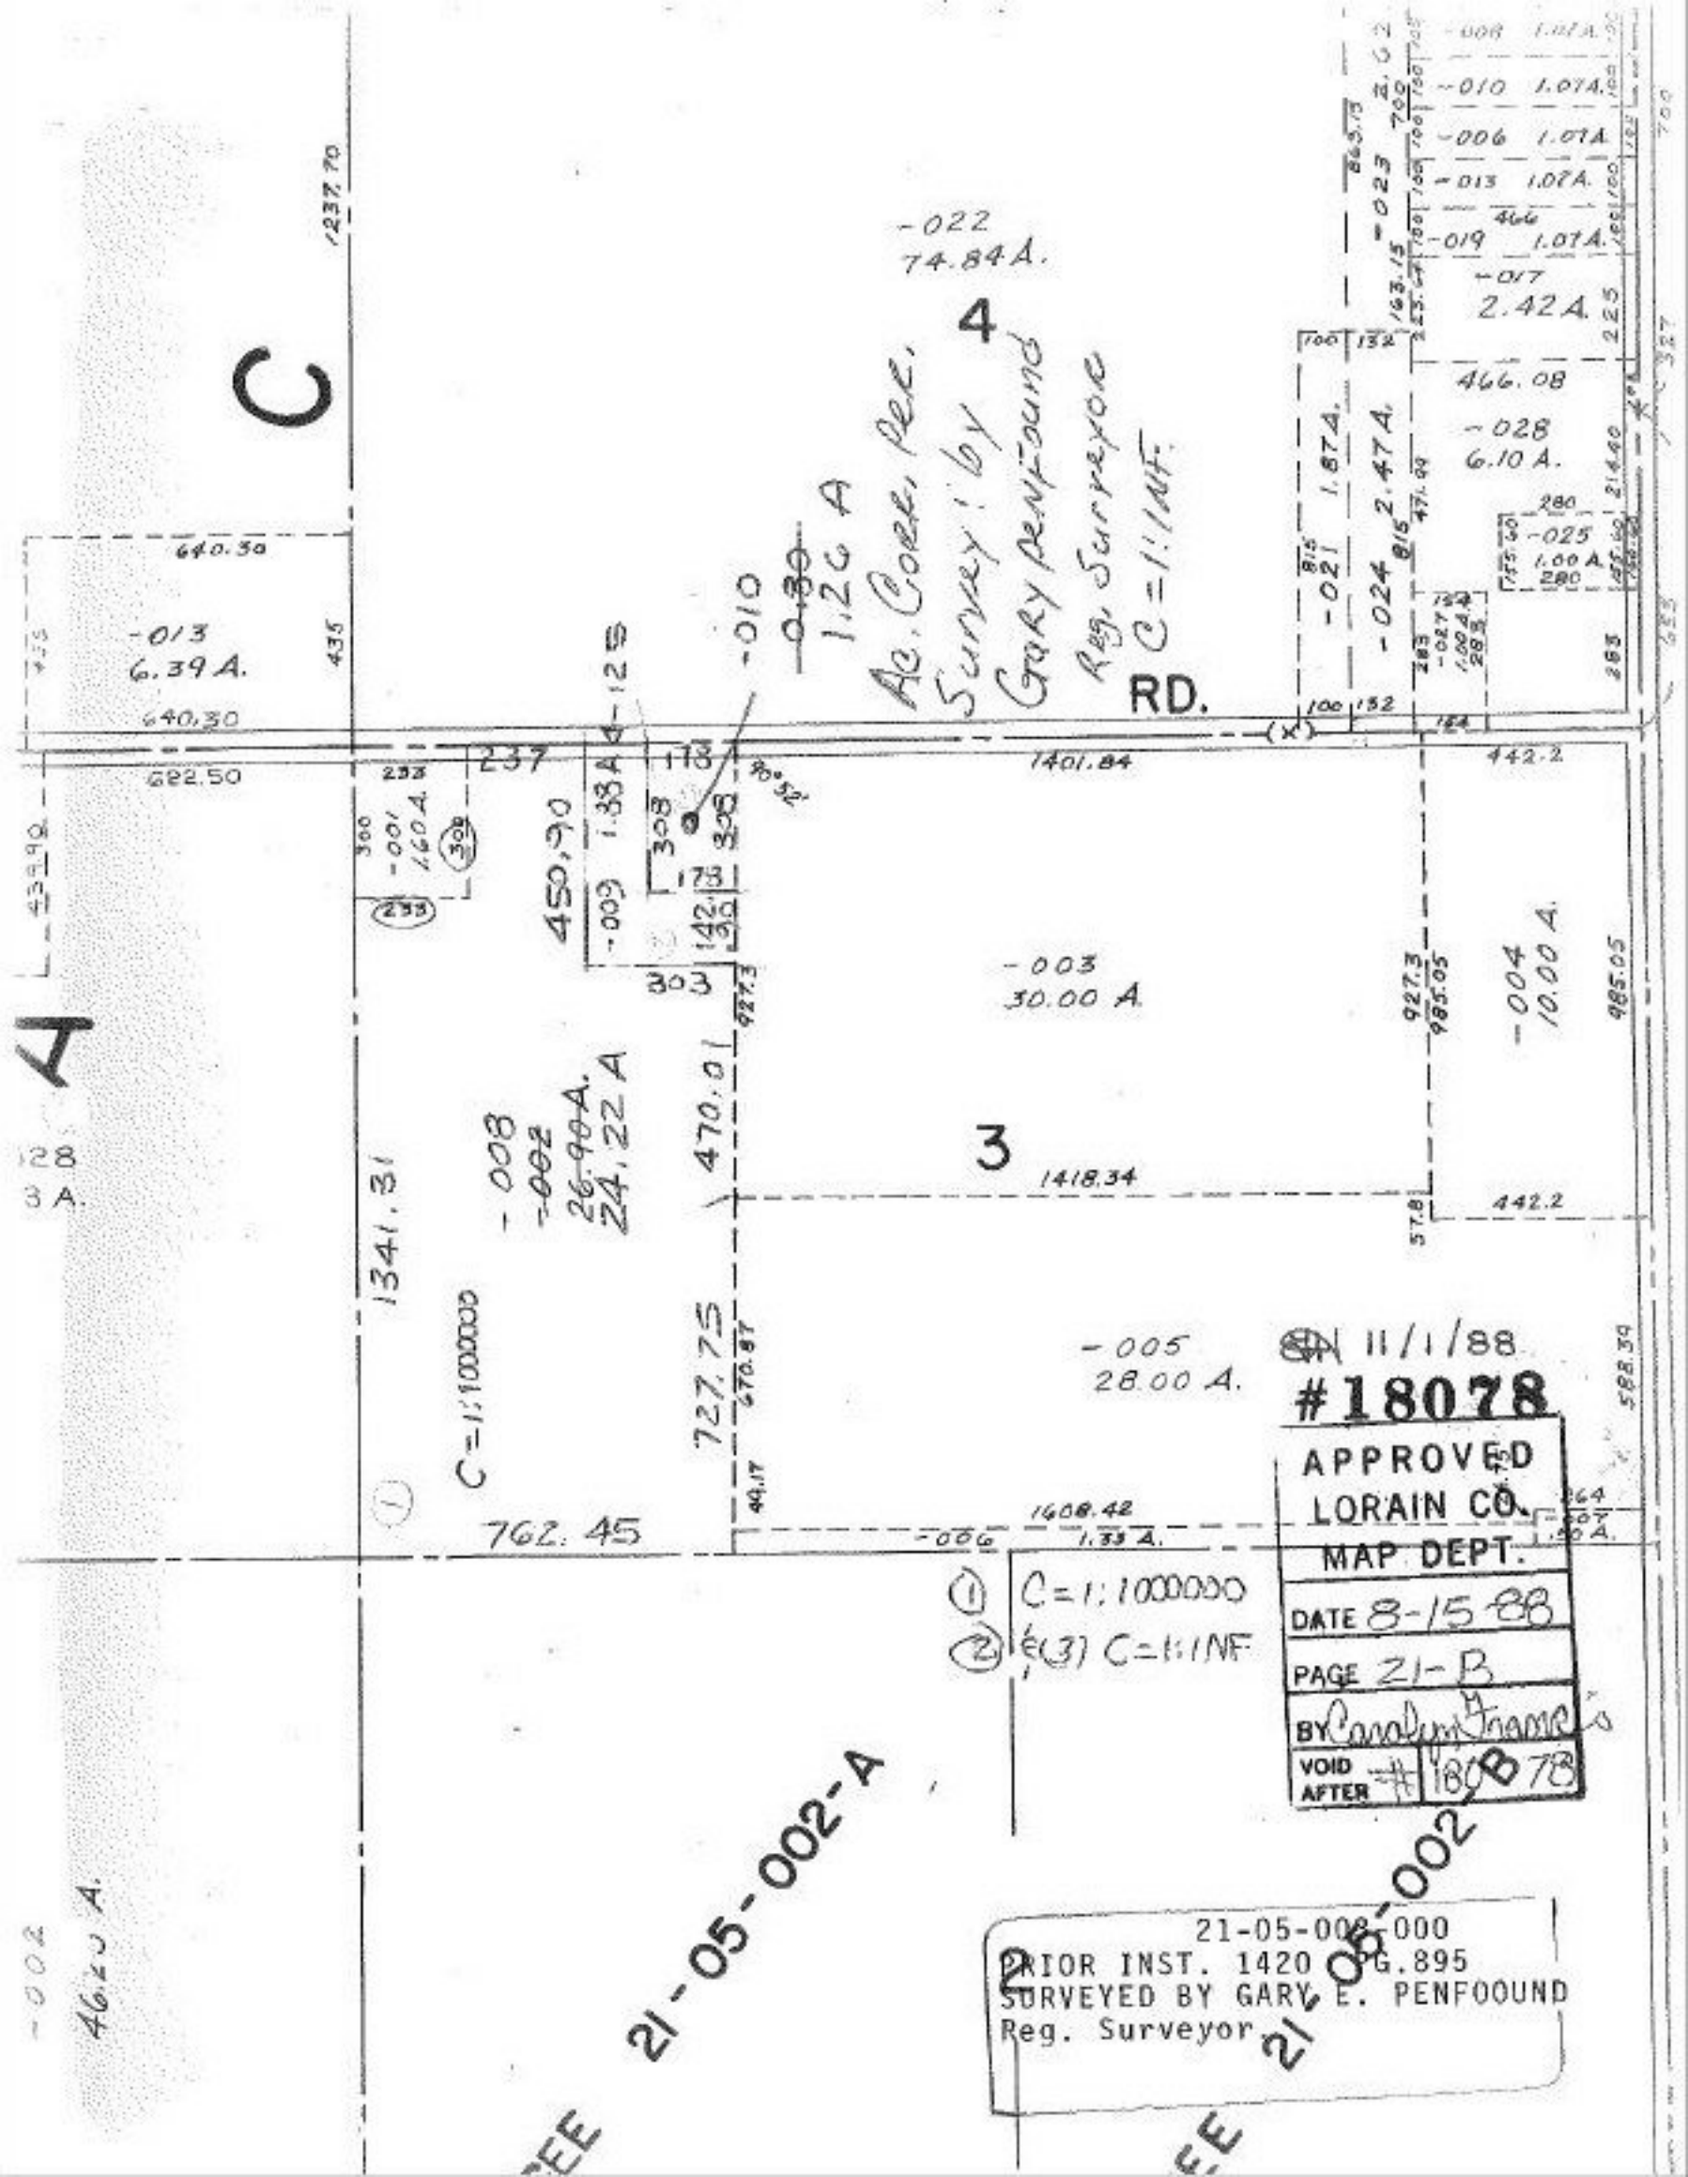

C
A
RD.
4
3
-022
74.84 A.
Ac. Corr. Per. Survey: by Gary Penfound Reg. Surveyor C=1:1NF.
-013
6.39 A.
640.30
622.50
1237.70
-010
1.26 A
-003
30.00 A.
-004
10.00 A.
-005
28.00 A.
-008
-002
26.90 A.
24.22 A
1341.31
C=1:1000000
727.75
762.45
1401.84
1418.34
442.2
1608.42
-006
1.33 A.
-008 1.07 A.
-010 1.07 A.
-006 1.07 A.
-013 1.07 A.
-019 1.07 A.
-017
2.42 A.
466.08
-028
6.10 A.
-025
1.00 A.
-021 1.87 A.
-024 2.47 A.
-001
1.60 A.
450.90
-009 1.33 A.
-125
-002
46.20 A.
C=1:1000000
(3) C=1:1NF
11/1/88
#18078
APPROVED
LORAIN CO.
MAP DEPT.
DATE 8-15-88
PAGE 21-B
BY Carolyn Francis
VOID AFTER #18078
21-05-002-A
21-05-002-B
21-05-008-000
PRIOR INST. 1420 PG.895
SURVEYED BY GARY E. PENFOOUND
Reg. Surveyor