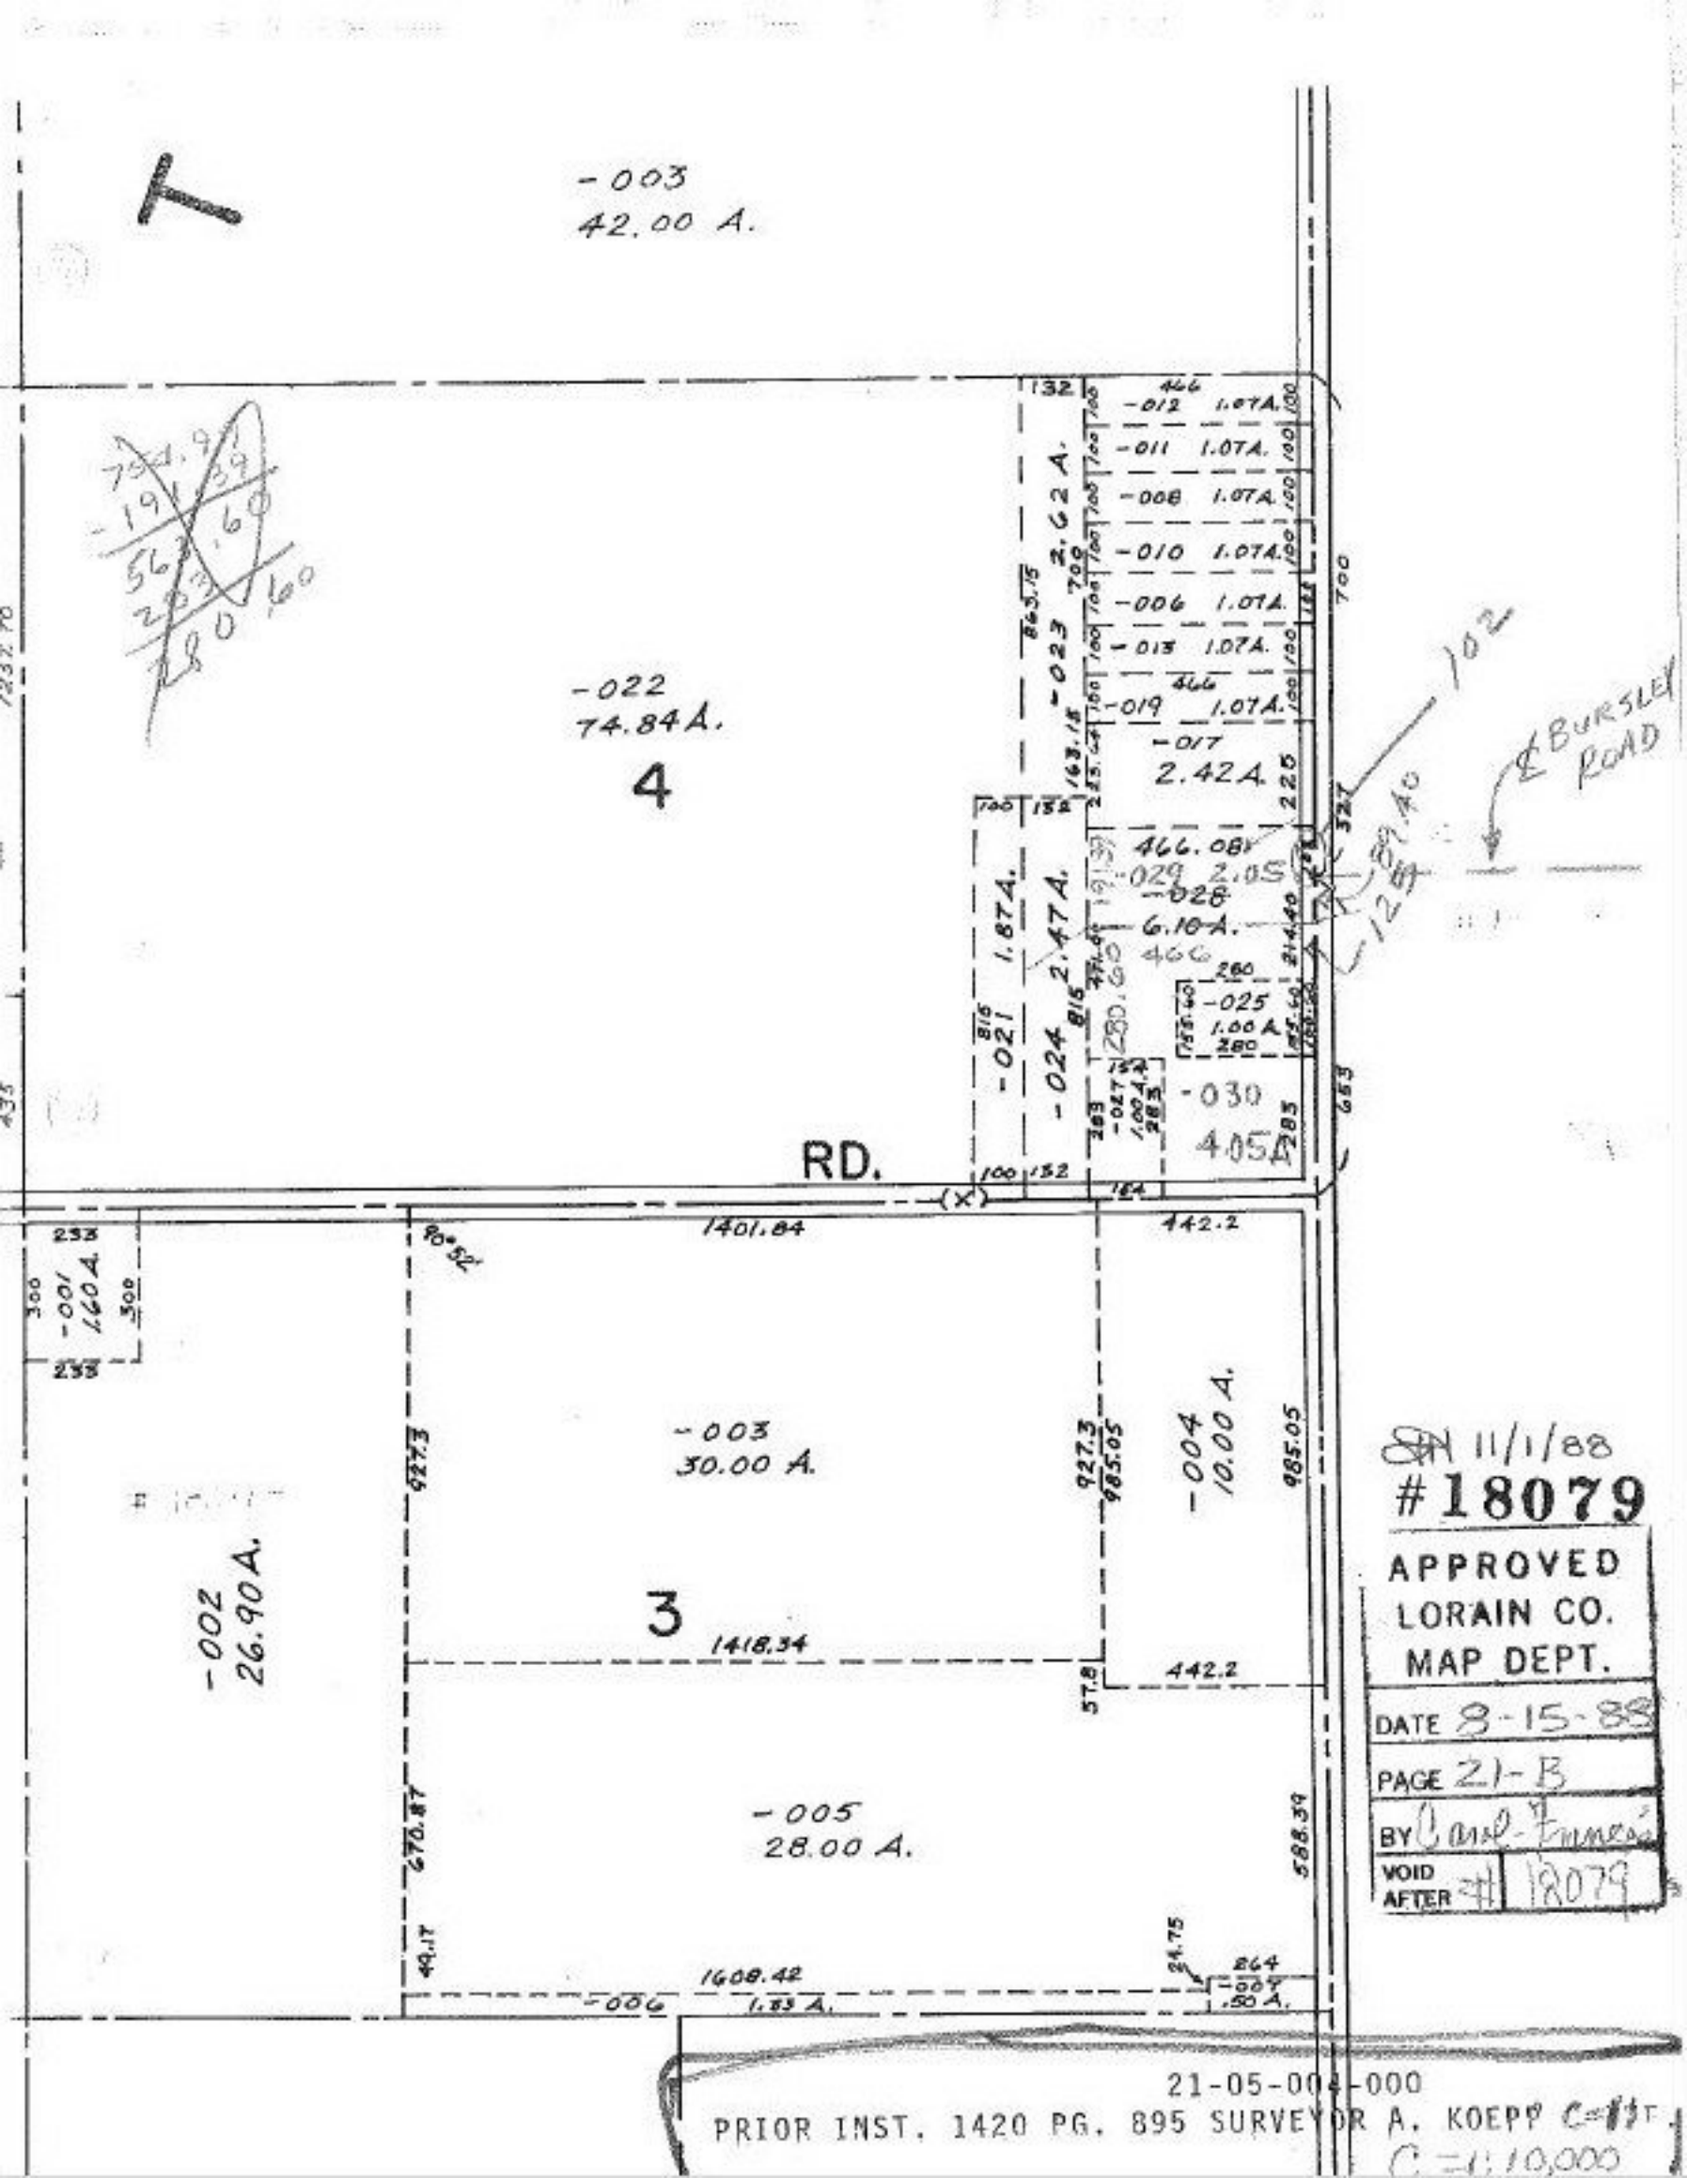

11/1/88
#18079

APPROVED
LORAIN CO.
MAP DEPT.

DATE 8-15-88
PAGE 21-B
BY Carol Farmer
VOID AFTER # 18079

21-05-004-000
PRIOR INST. 1420 PG. 895 SURVEYOR A. KOEPP C-1 T
C-1: 10,000