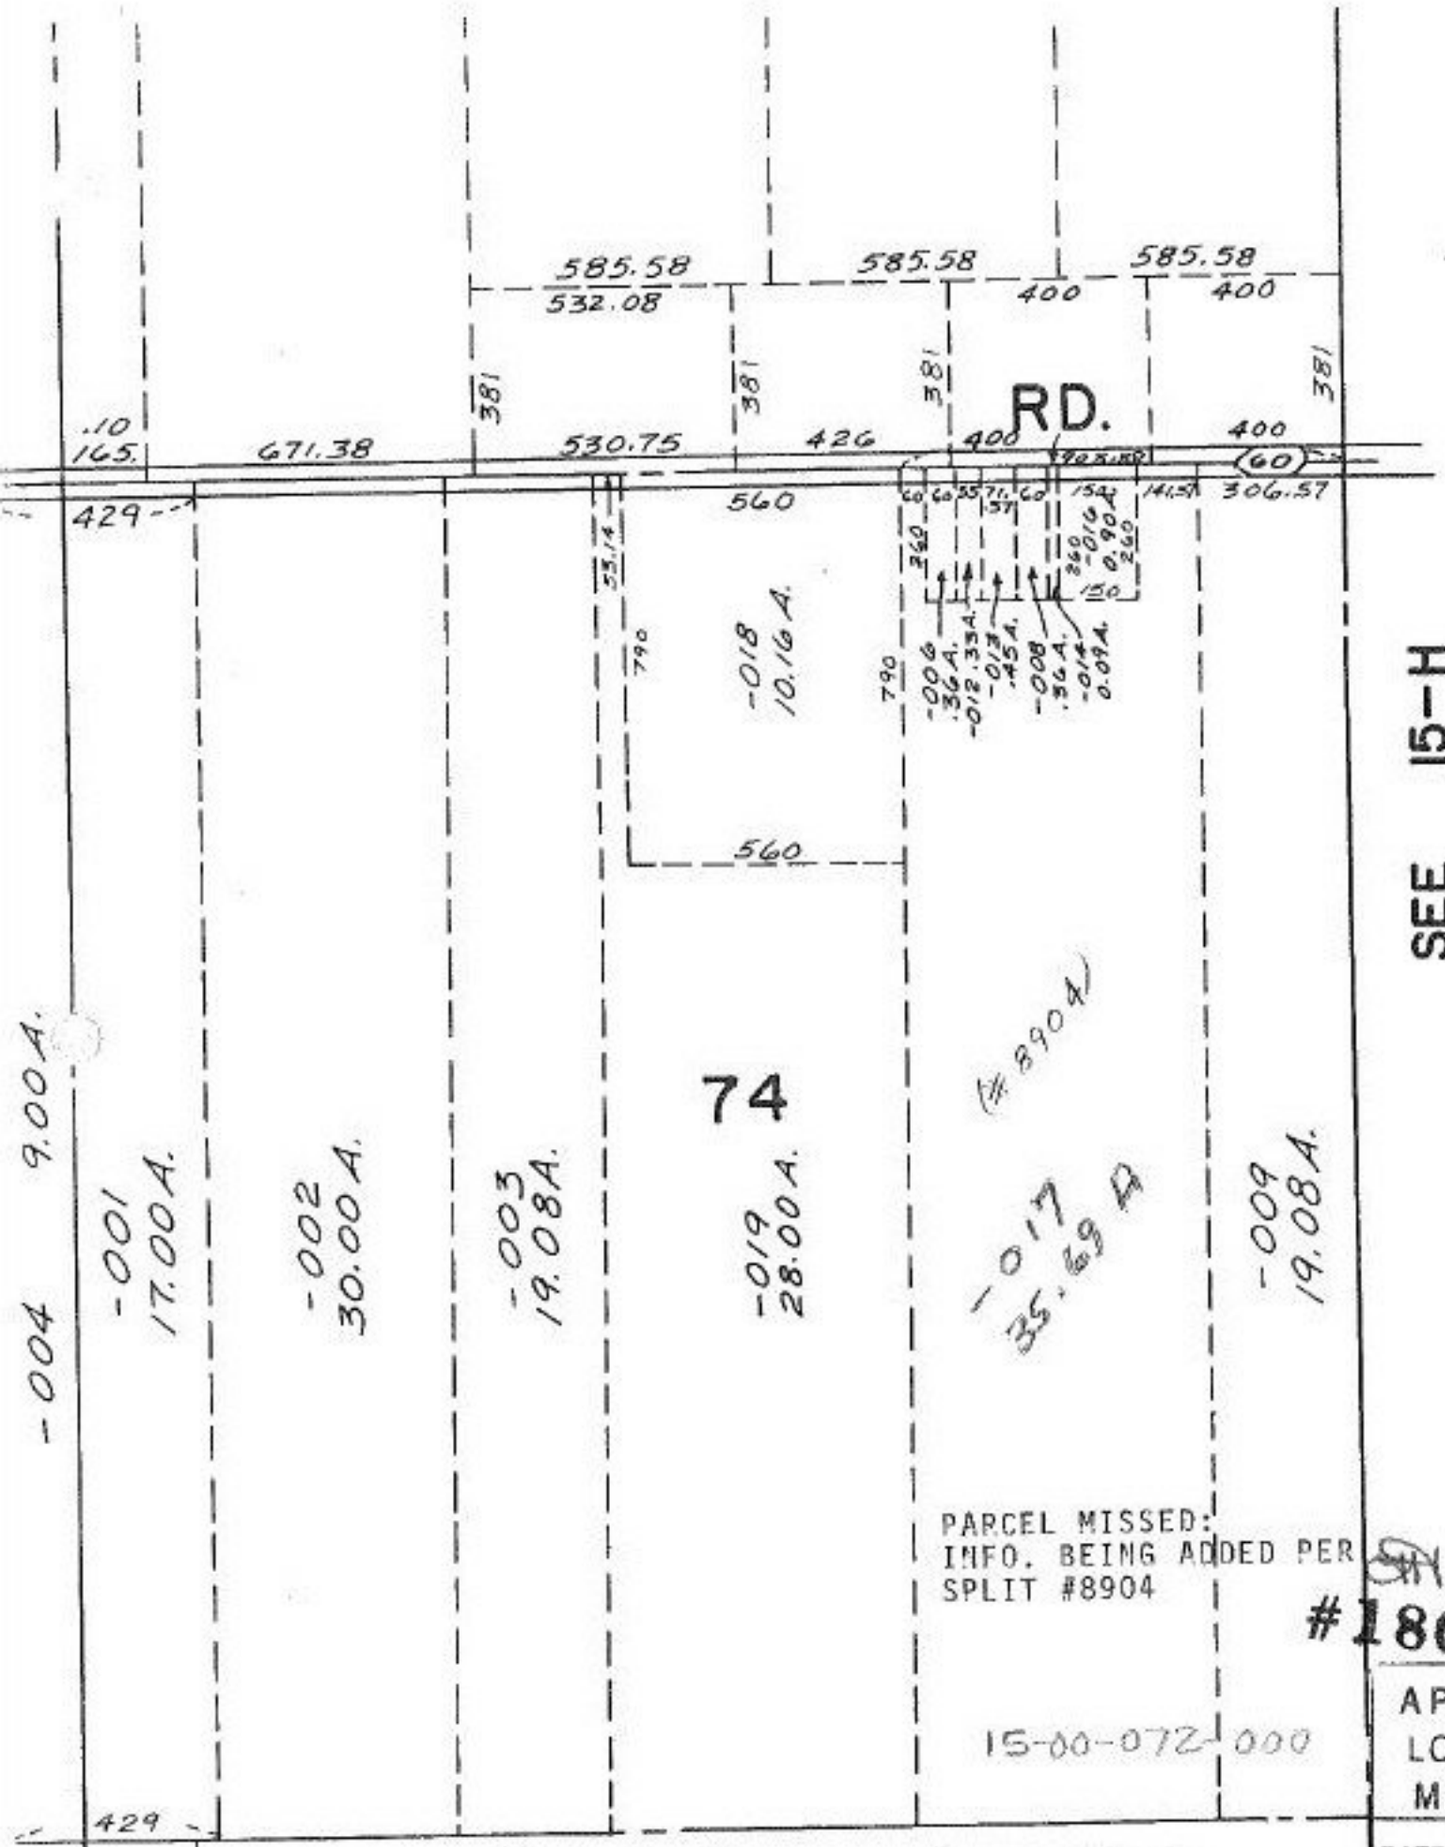
585.58
532.08
585.58
585.58
400
400
381
381
381
381
RD.
.10
165.
671.38
530.75
426
400
400
60
429
560
SEE 15-H
-018
10.16A.
560
74
(#8904)
-017
35.69A
-001
17.00A.
-002
30.00A.
-003
19.08A.
-019
28.00A.
-009
19.08A.
-004
9.00A.
PARCEL MISSED:
INFO. BEING ADDED PER SPLIT #8904
10/7/88
#18083-A
15-00-072.000
APPROVED
LORAIN CO.
MAP DEPT.
DATE 8-18-88
PAGE 15-G
BY Gould-Francis
VOID AFTER # 18083-A
MAP CORR.
ONLY