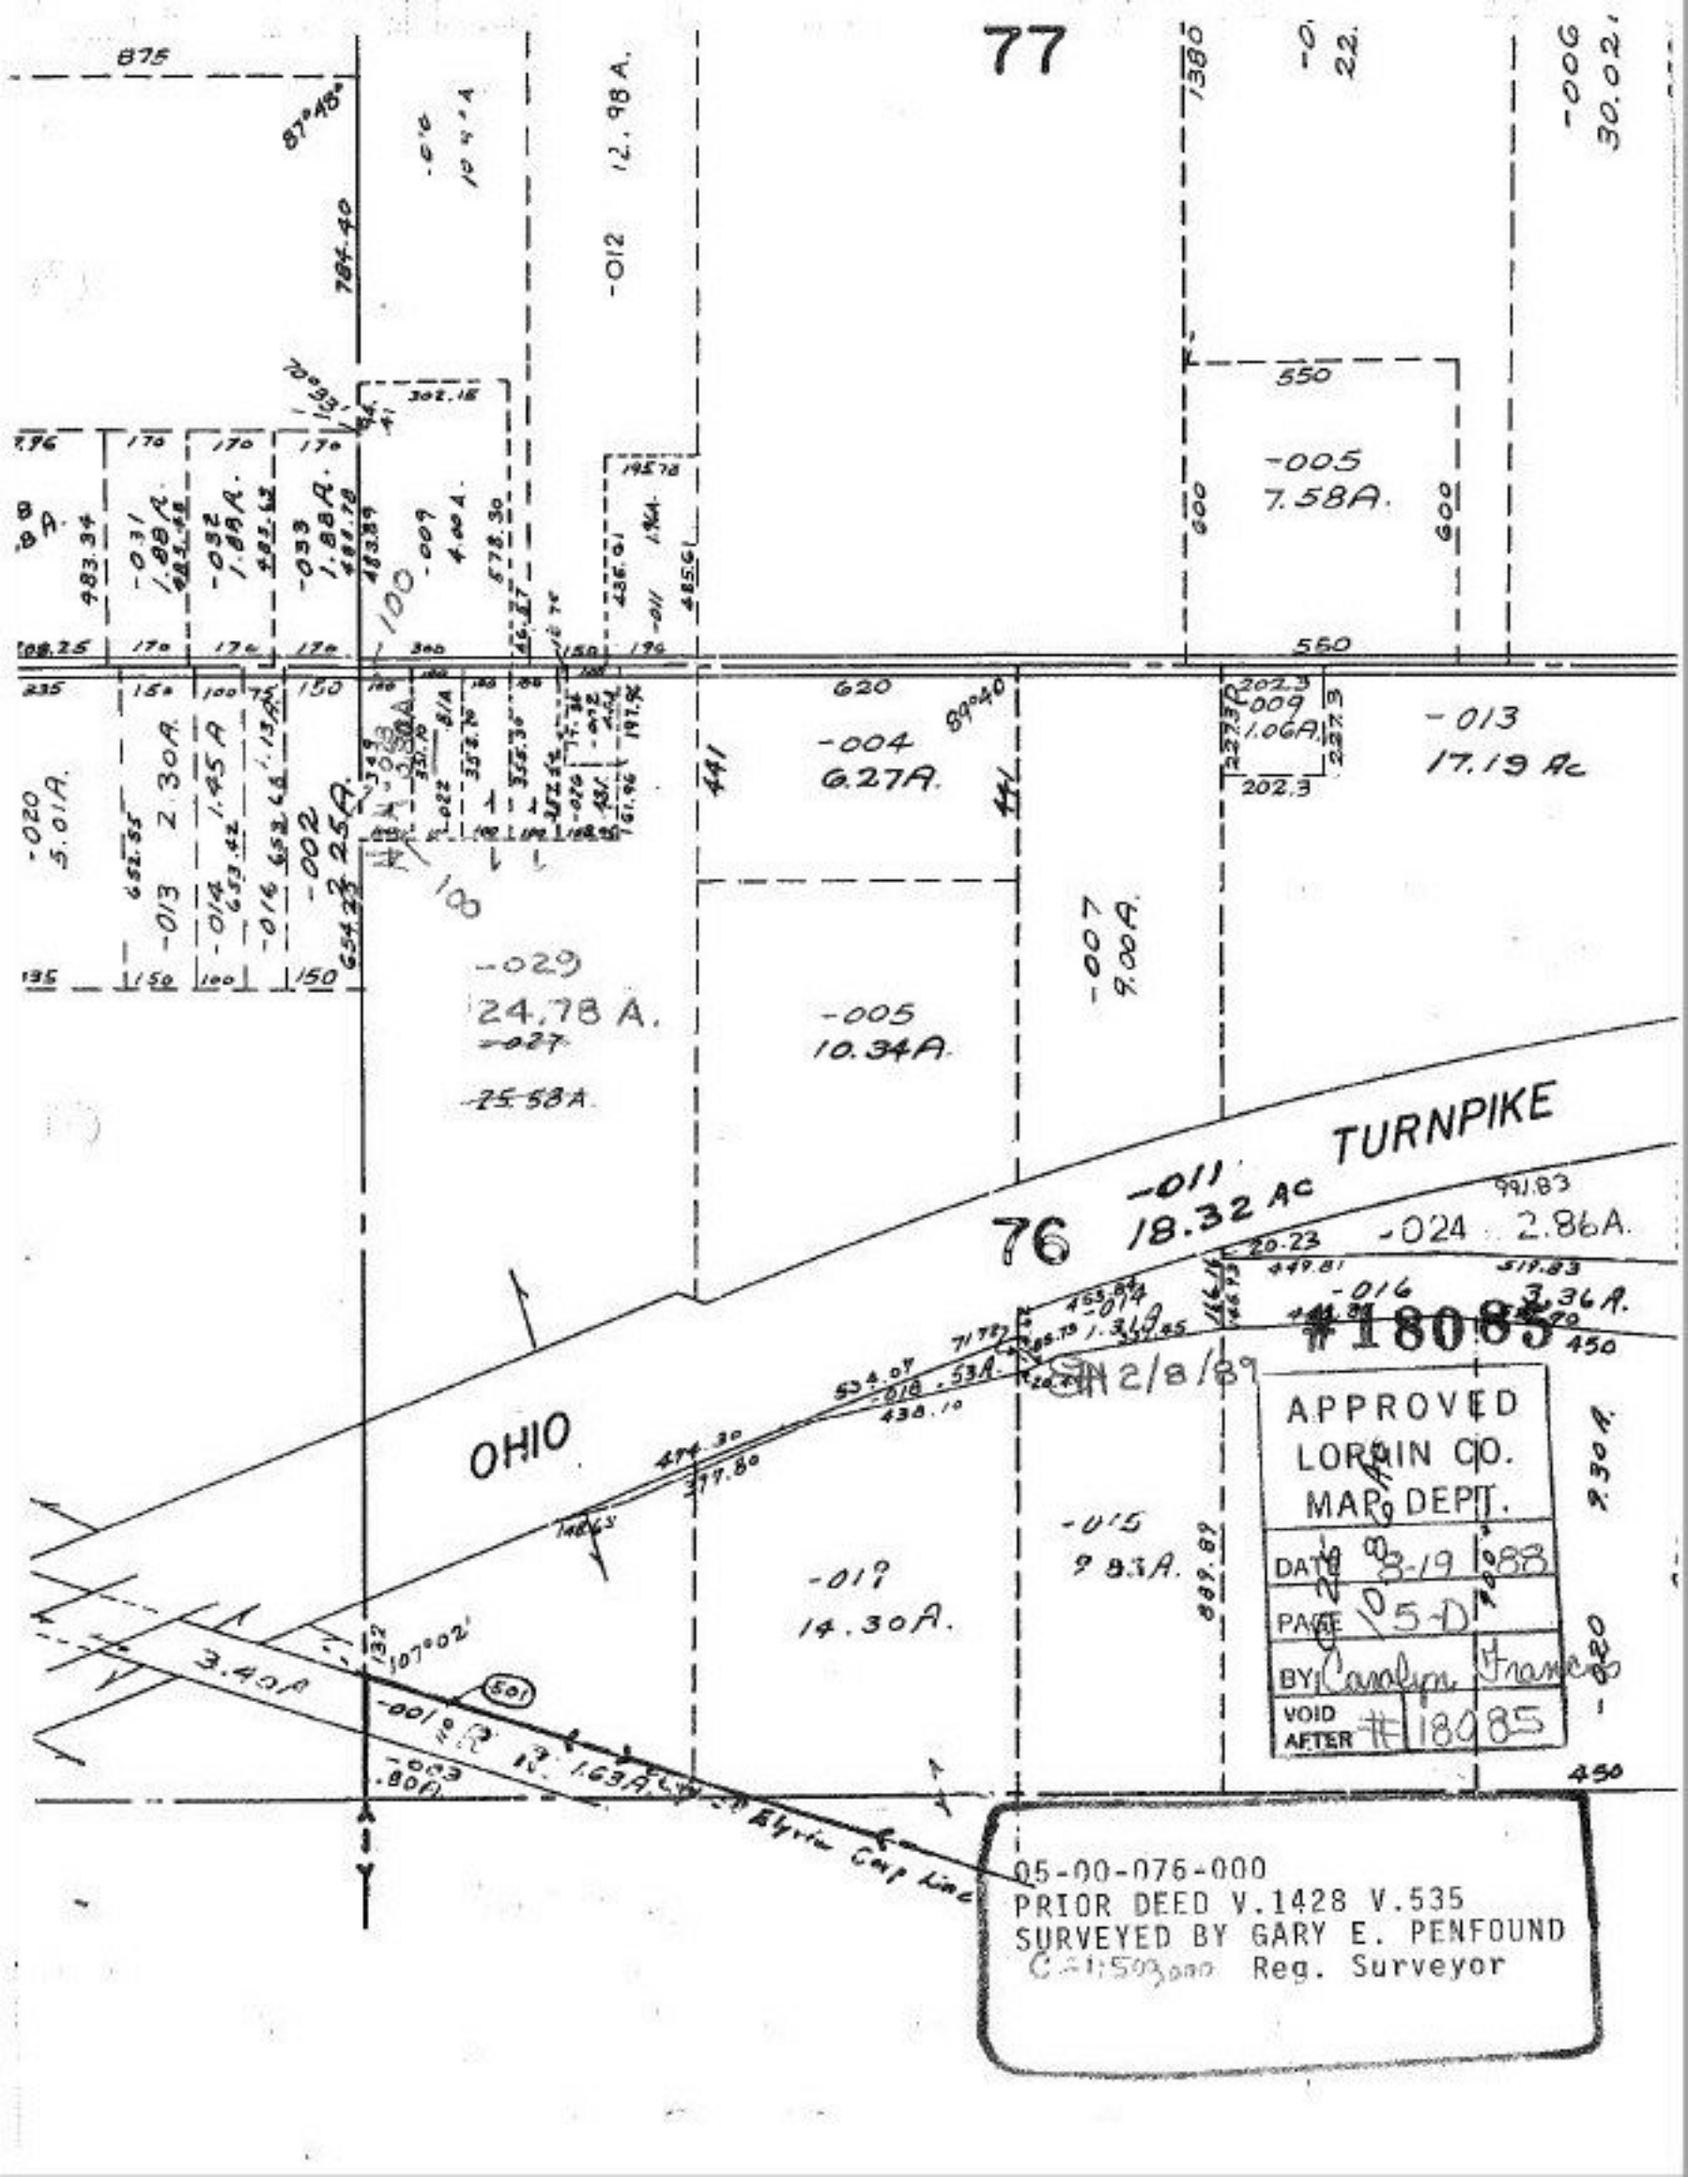
77
76
875
784.40
-012 12.98 A.
1380
550
-005
7.58A.
600
983.34
-031 1.88A.
-032 1.88A.
-033 1.88A.
-009 4.60A.
-020 5.01A.
-013 2.30A.
-014 1.45A.
-016
-002 2.25A.
620
-004 6.27A.
-013 17.19 Ac
202.3
-009 1.06A.
441
-029 24.78 A.
-027 25.58A.
-005 10.34A.
-007 9.00A.
-011 18.32 Ac
TURNPIKE
-024 2.86A.
-016 3.36A.
#18085
OHIO
-018 .53A.
-015 9.33A.
-017 14.30A.
3.40A
-001
-003 .80A
N. 163A
Elyria Corp Line
APPROVED
LORAIN CO.
MAP DEPT.
DATE 3-19-1988
PAGE 15-D
BY Carolyn Franco
VOID AFTER #18085
05-00-076-000
PRIOR DEED V.1428 V.535
SURVEYED BY GARY E. PENFOUND
Reg. Surveyor