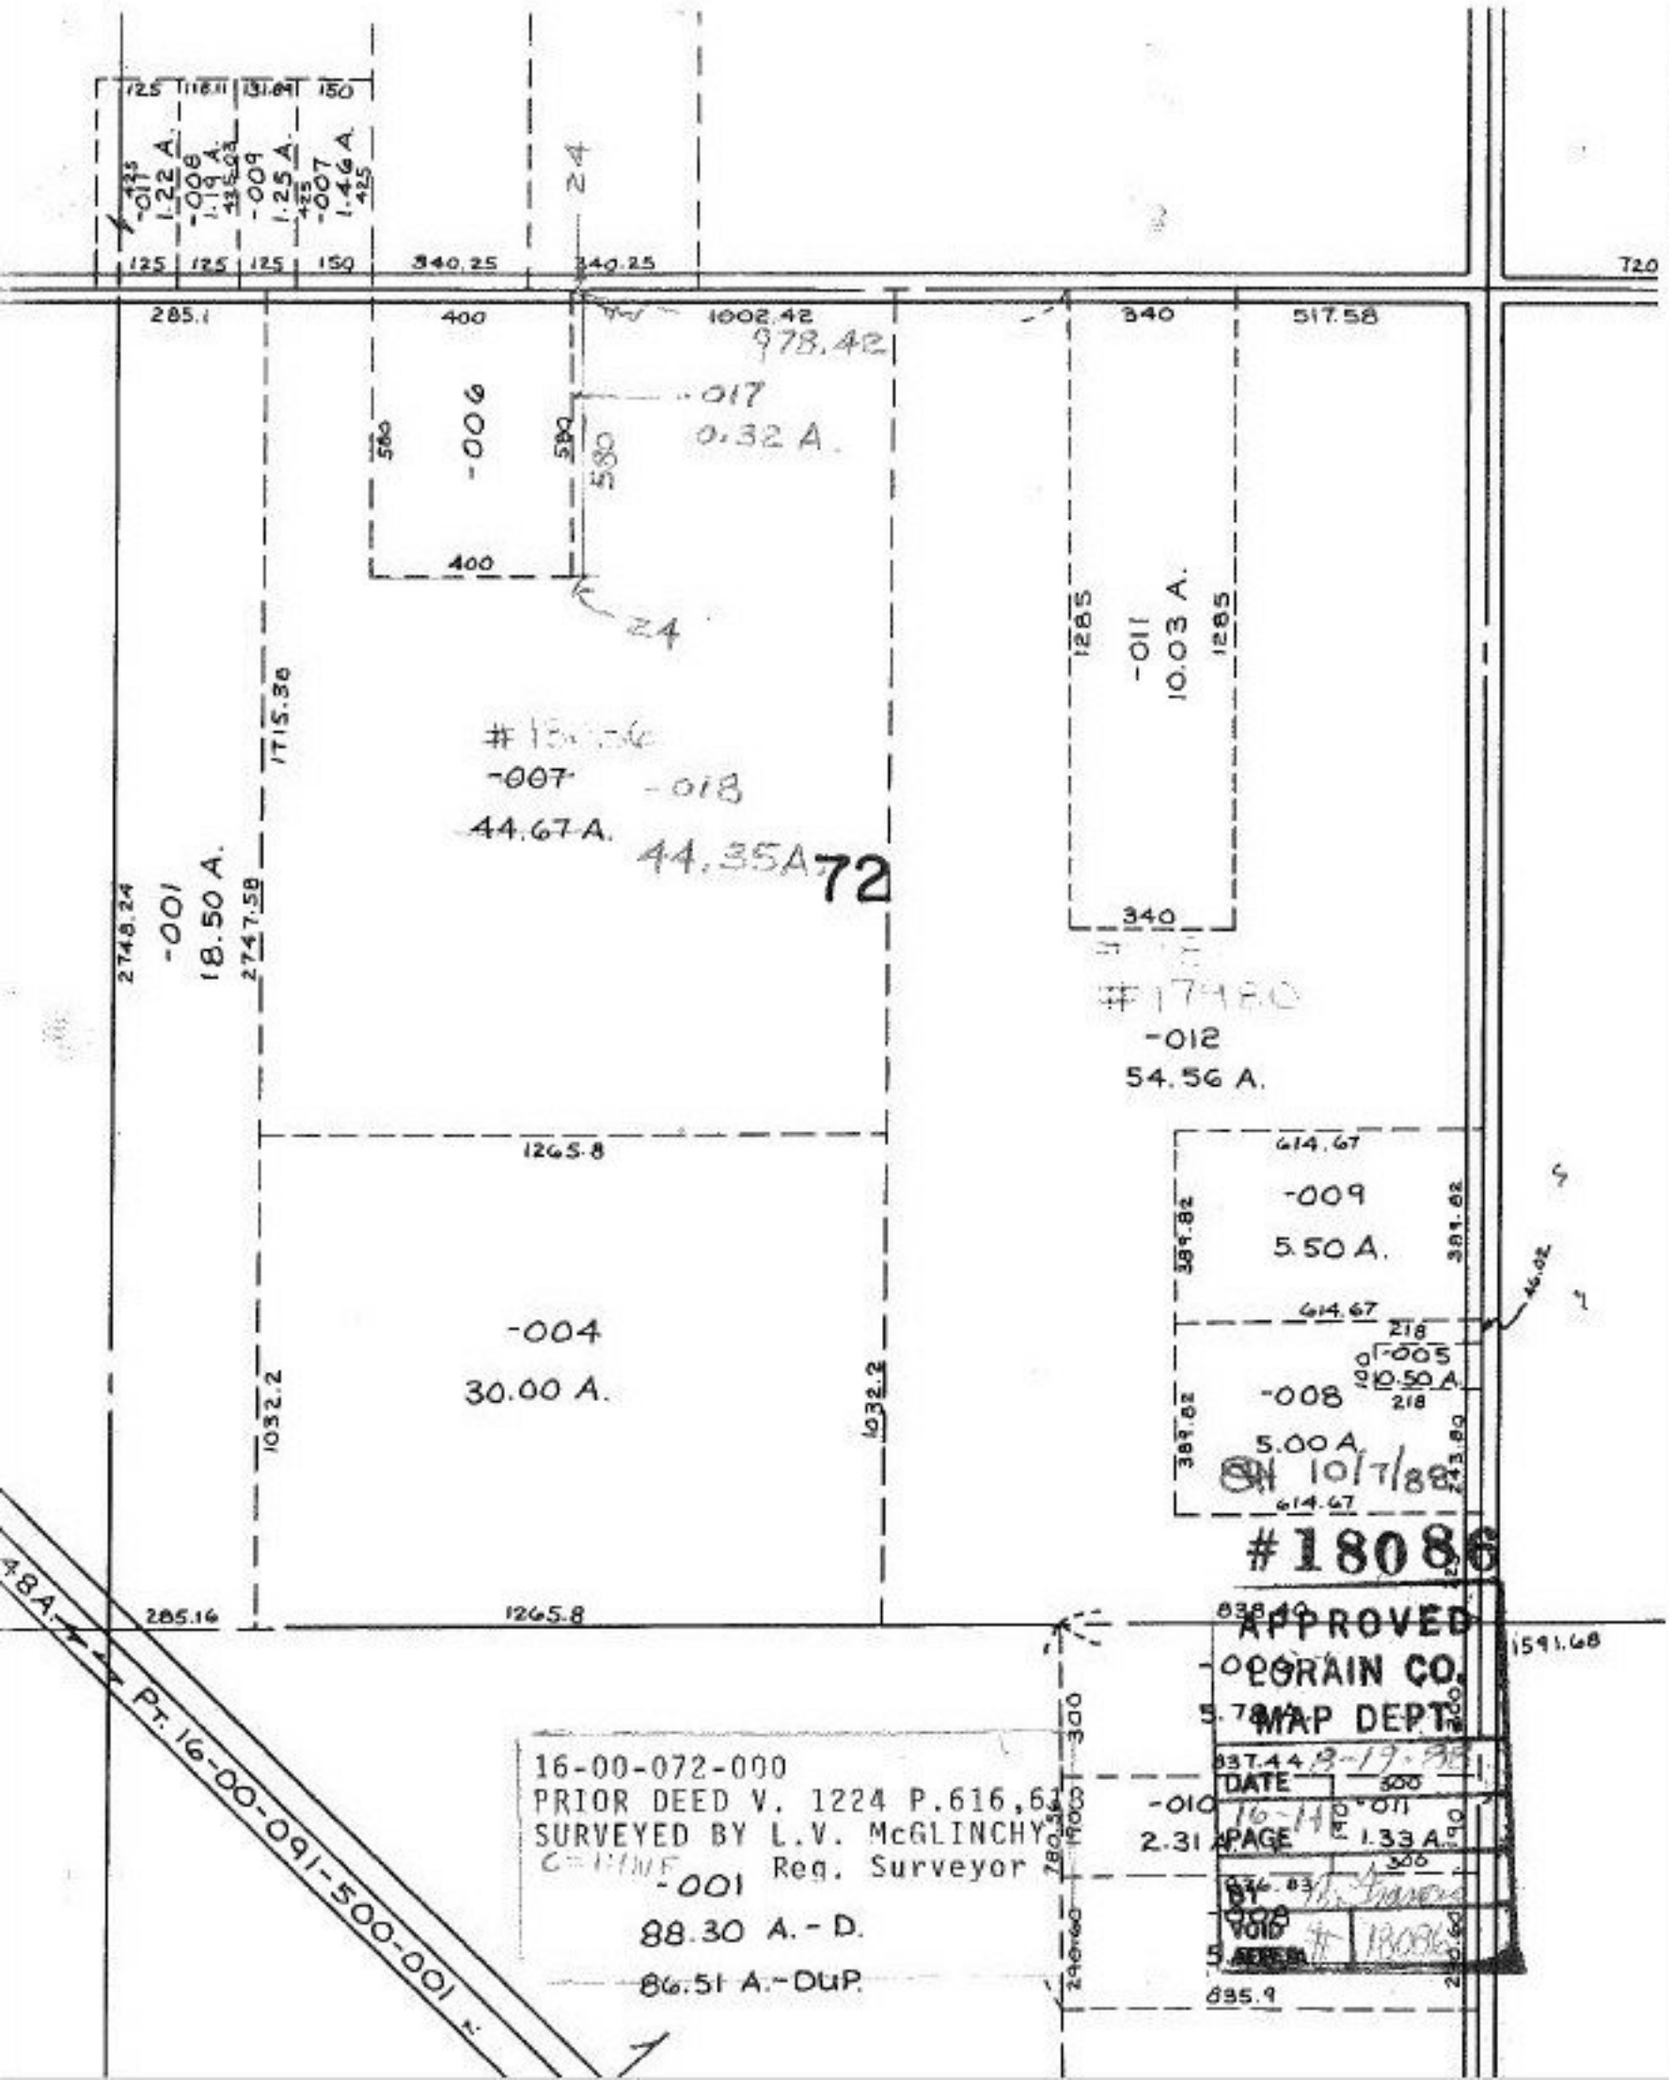


16-00-072-000
PRIOR DEED V. 1224 P.616,61
SURVEYED BY L.V. McGLINCHY
Reg. Surveyor