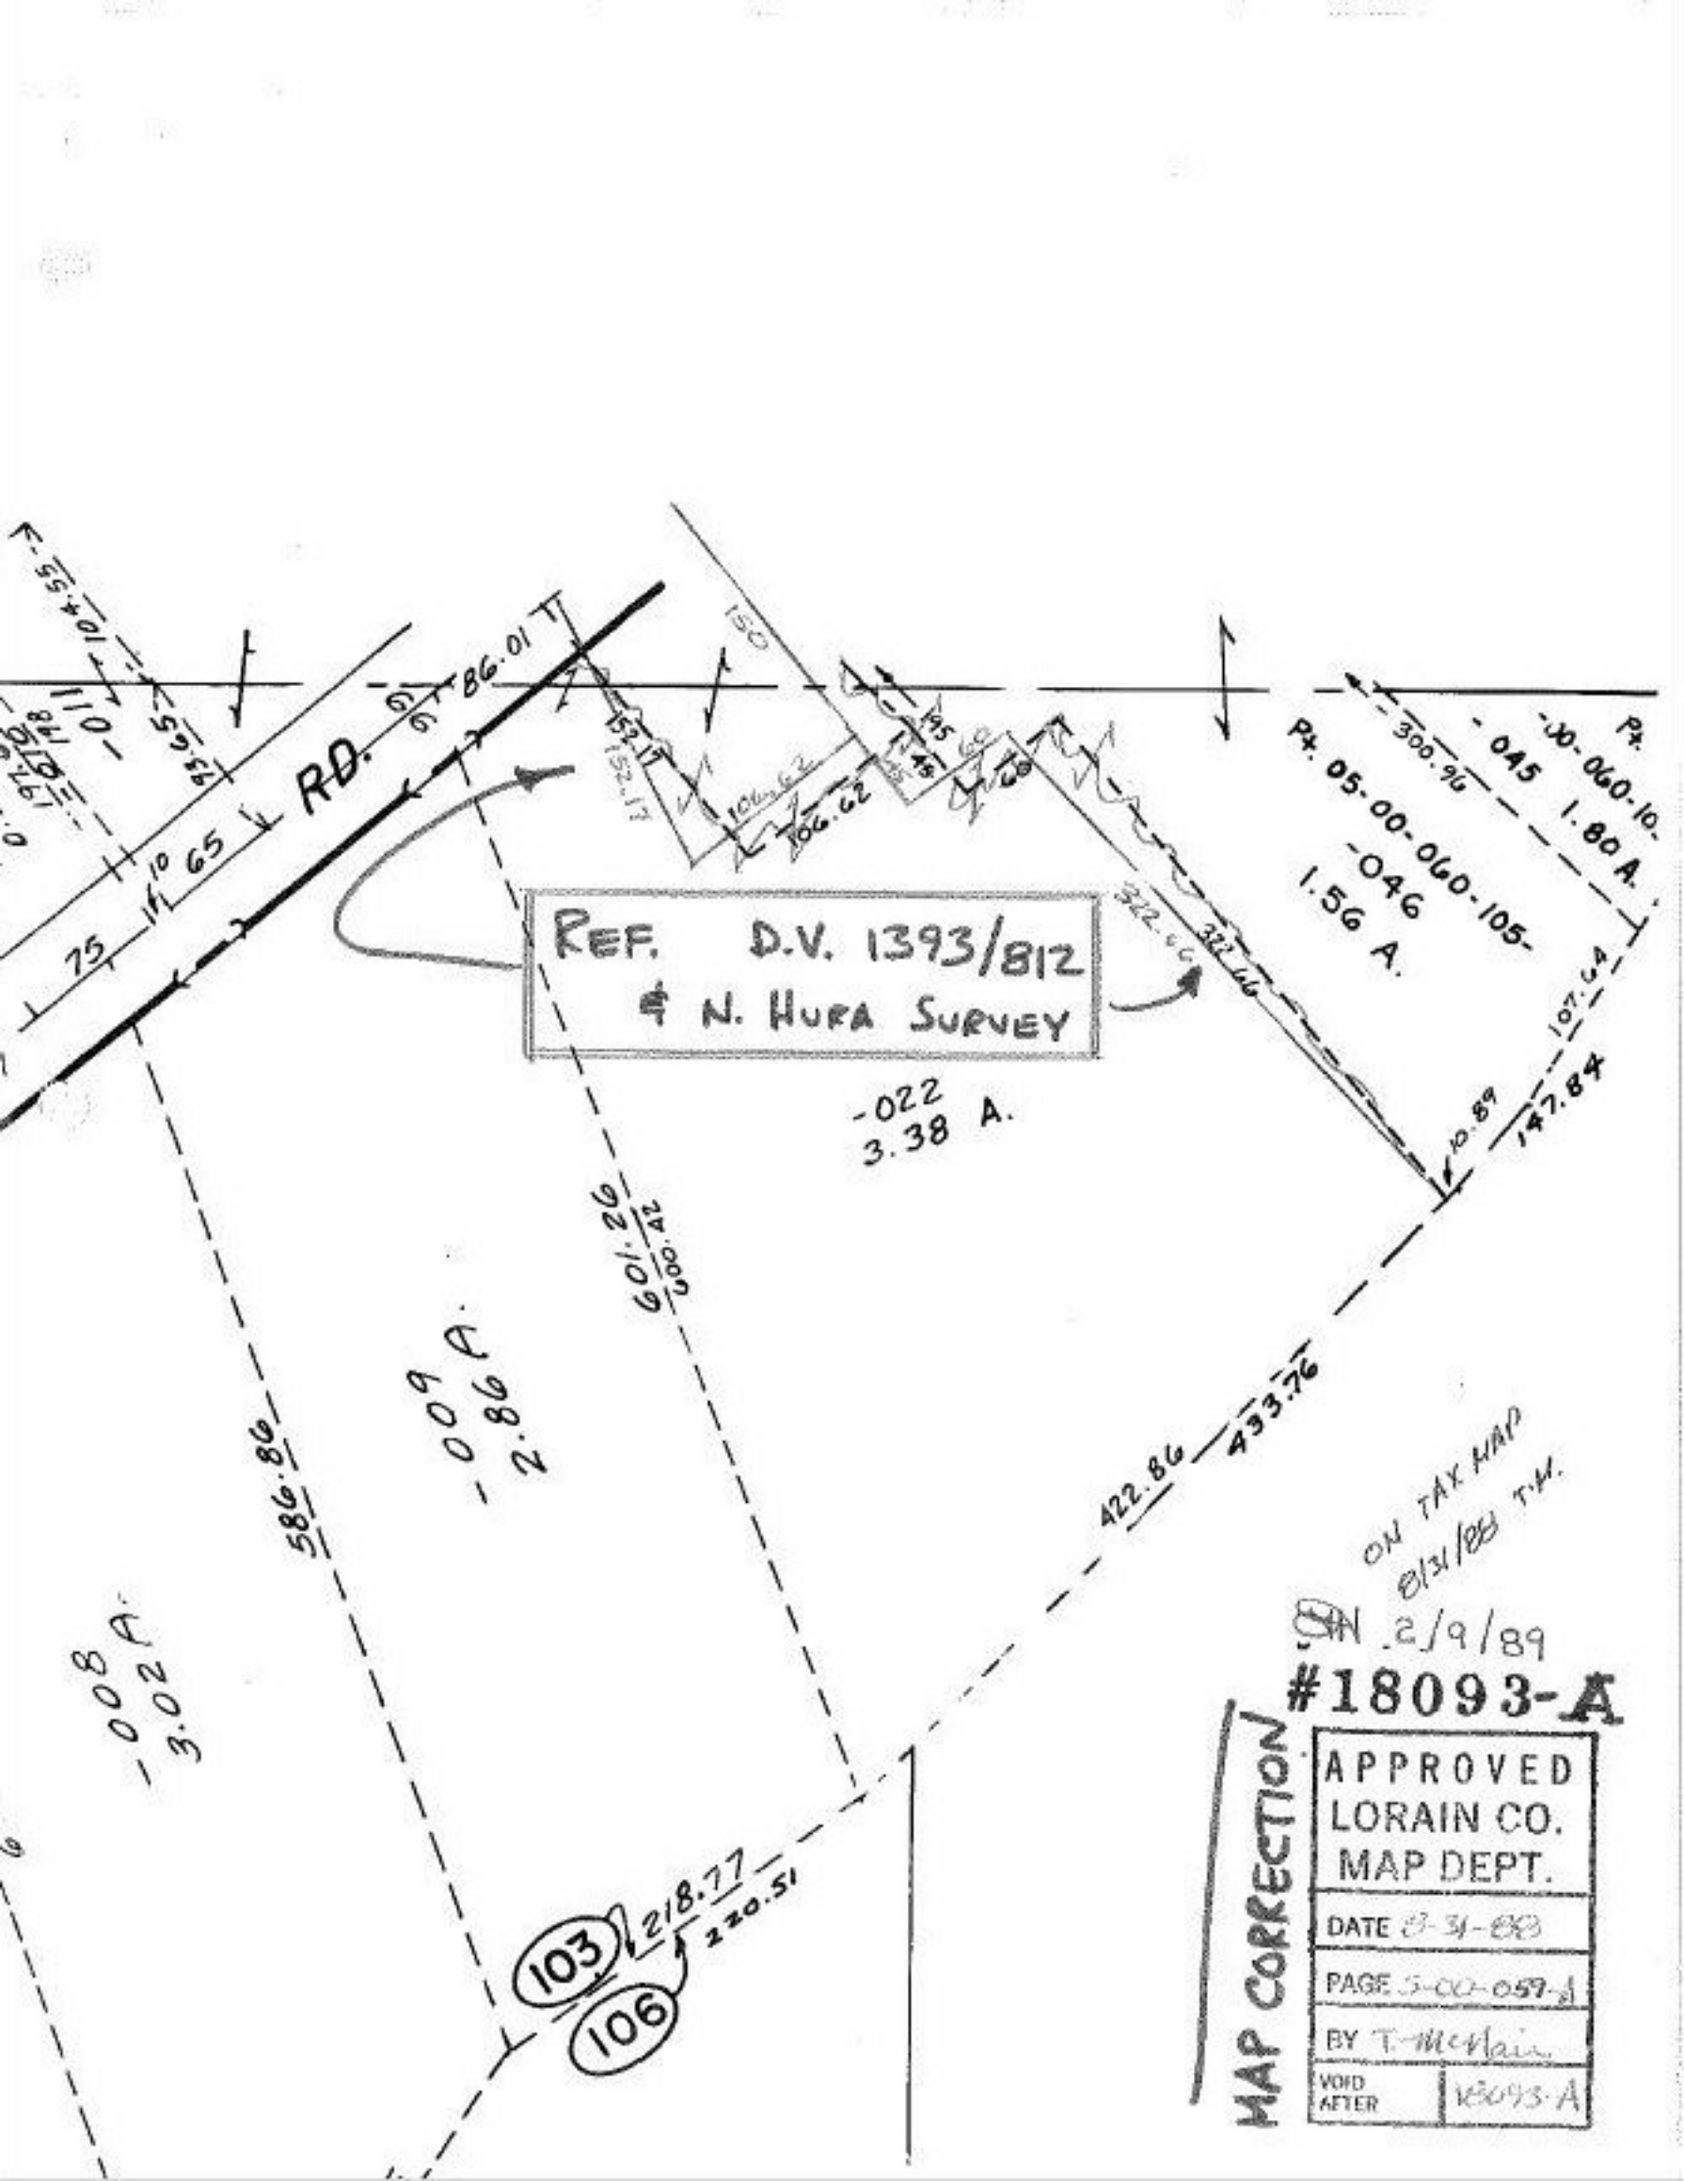
RD.
REF. D.V. 1393/812
& N. HUFA SURVEY
-022
3.38 A.
-009
2.86 A.
-008
3.02 A.
-045
1.80 A.
Pt. 05-00-060-105-
-046
1.56 A.
Pt. 05-00-060-10-
300.96
322.66
107.54
147.84
10.89
586.86
422.86
433.76
601.26
600.00
218.77
220.51
103
106
150
152.17
106.62
86.01
75
65
ON TAX MAP
8/31/88 T.M.
2/9/89
#18093-A
MAP CORRECTION
APPROVED
LORAIN CO.
MAP DEPT.
DATE 8-31-88
PAGE 5-00-059-A
BY T. McClain
VOID AFTER
18093-A