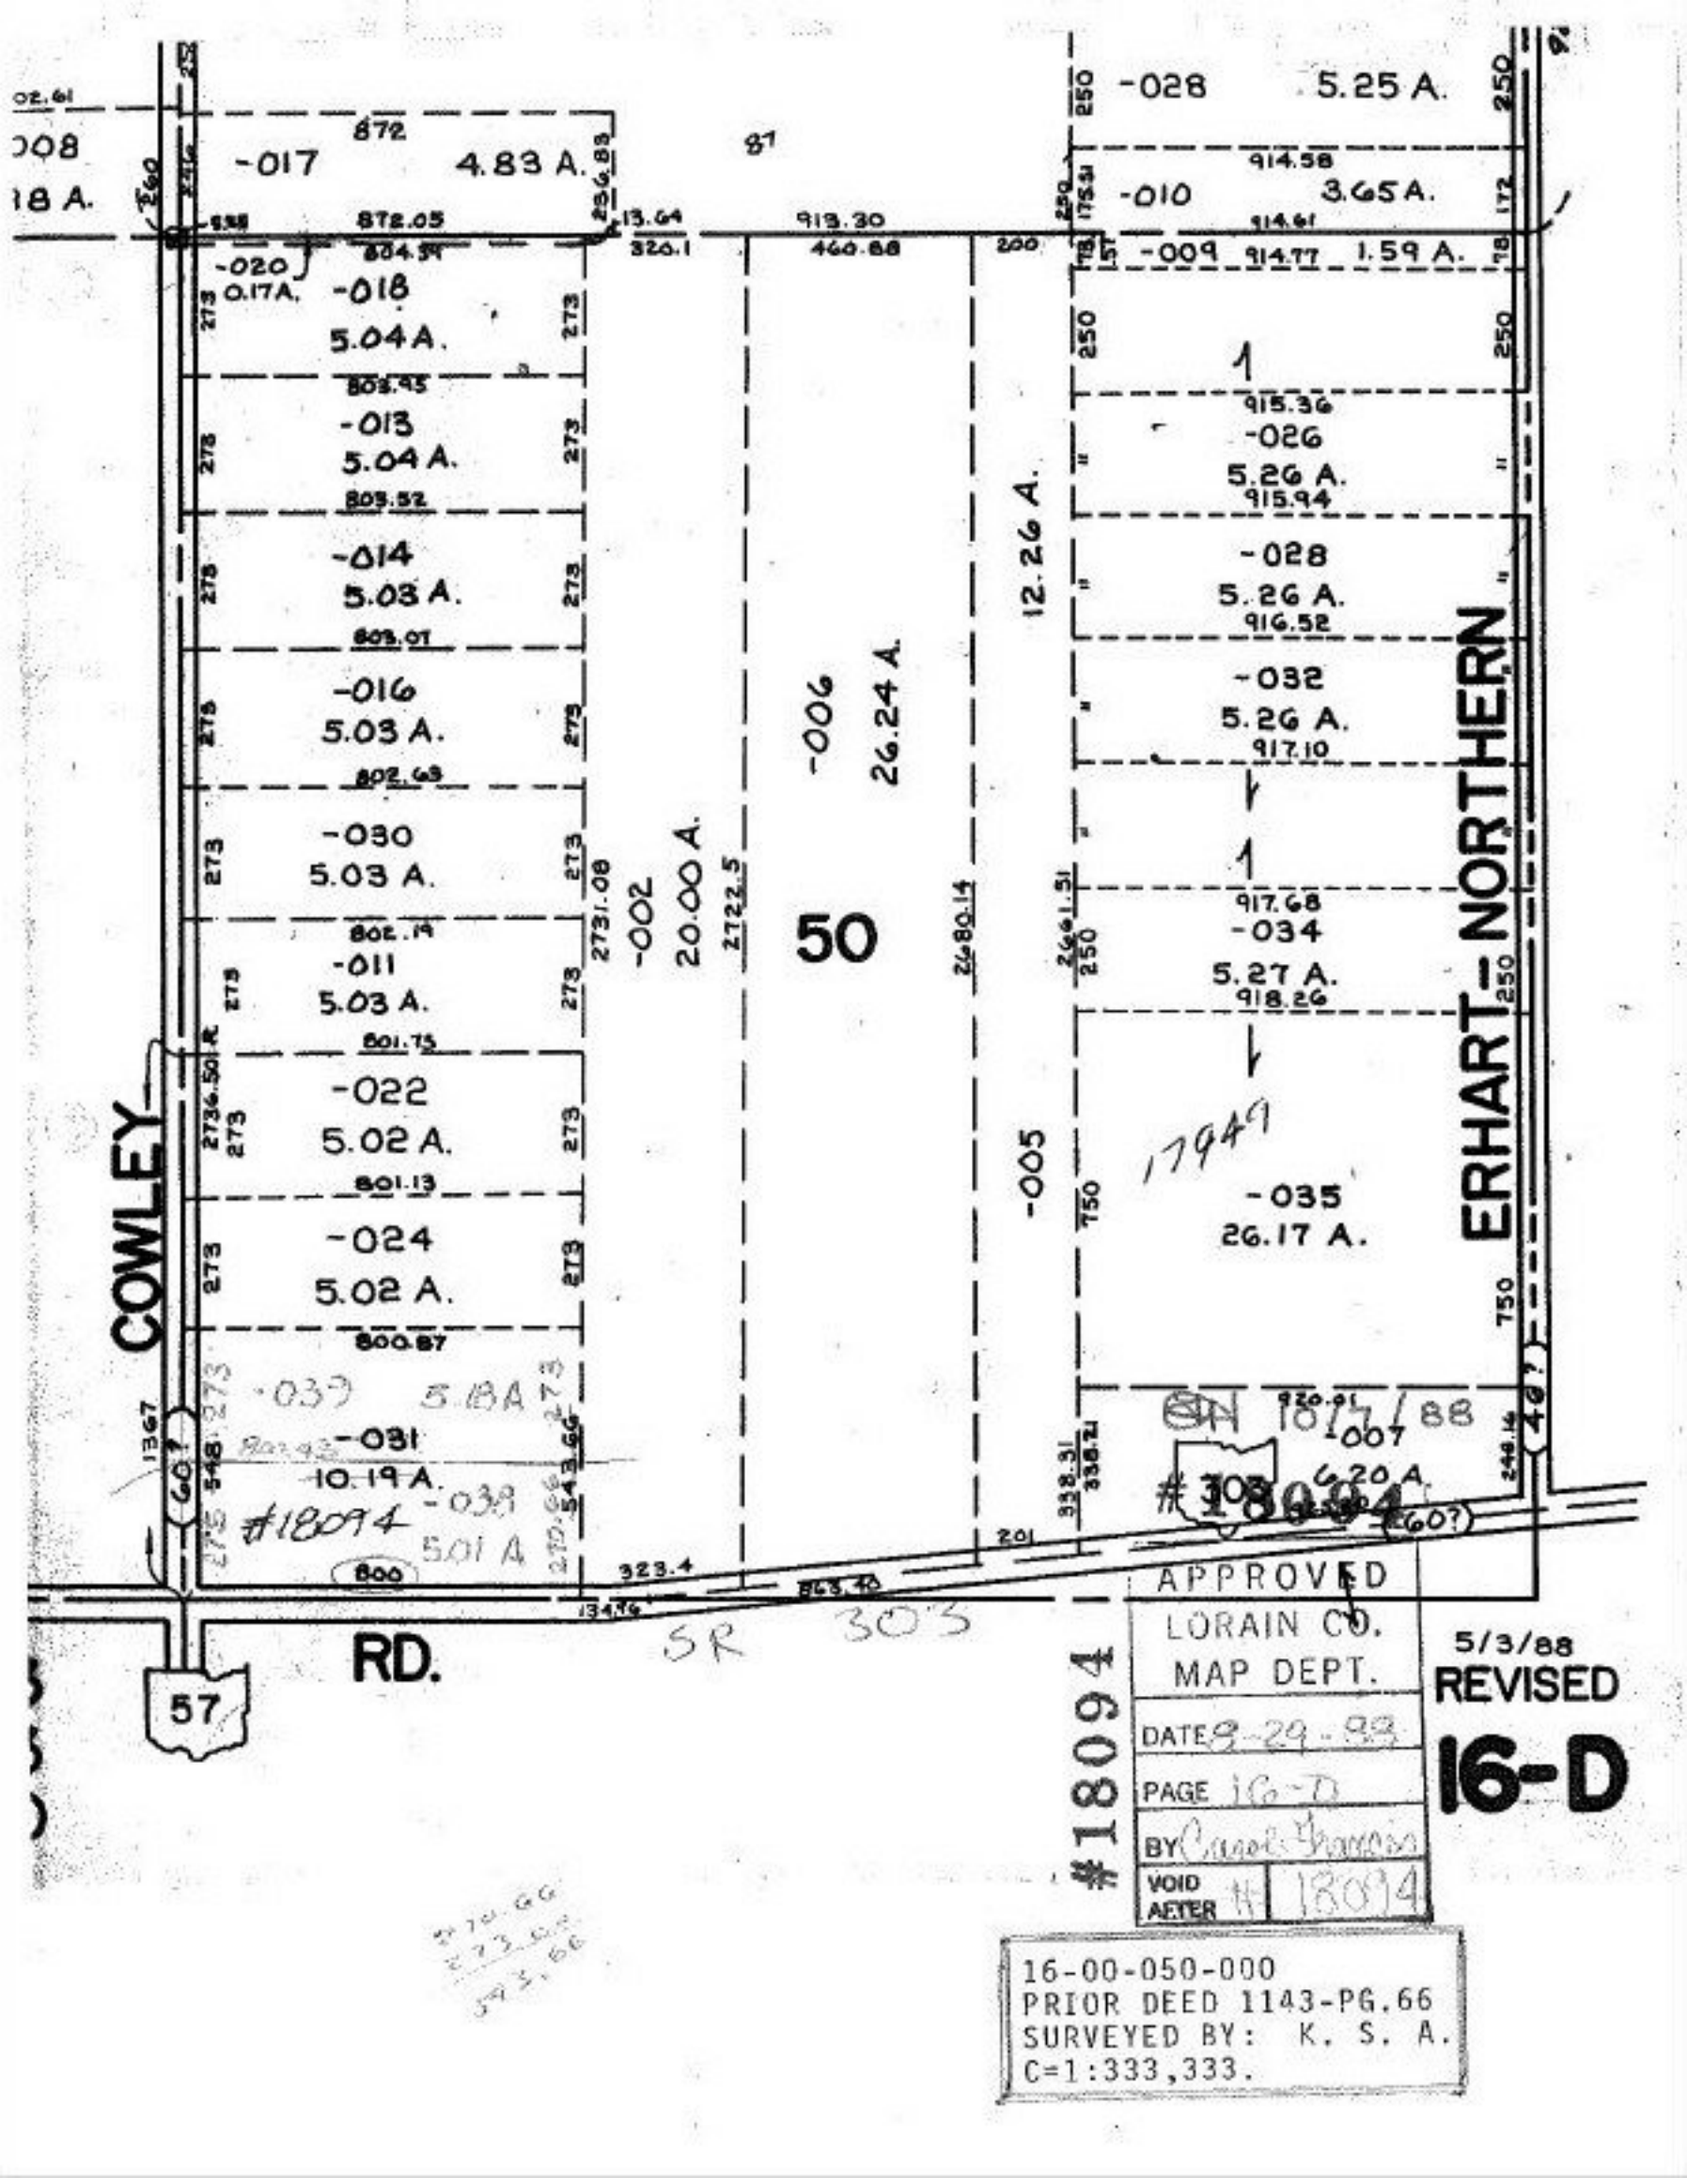
-017 4.83 A.
-028 5.25 A.
-010 3.65 A.
-009 1.59 A.
-020 0.17A.
-018 5.04 A.
-013 5.04 A.
-014 5.03 A.
-016 5.03 A.
-030 5.03 A.
-011 5.03 A.
-022 5.02 A.
-024 5.02 A.
-039 5.18A
-031 10.19 A.
-039 5.01 A
#18094
-026 5.26 A.
-028 5.26 A.
-032 5.26 A.
-034 5.27 A.
-035 26.17 A.
-002 20.00 A.
-006 26.24 A.
-005 12.26 A.
50
COWLEY
ERHART-NORTHERN
RD.
SR 303
57
APPROVED
LORAIN CO.
MAP DEPT.
DATE 8-29-88
PAGE 16-D
BY Carol Harris
VOID AFTER #
#18094
5/3/88
REVISED
16-D
16-00-050-000
PRIOR DEED 1143-PG.66
SURVEYED BY: K. S. A.
C=1:333,333.