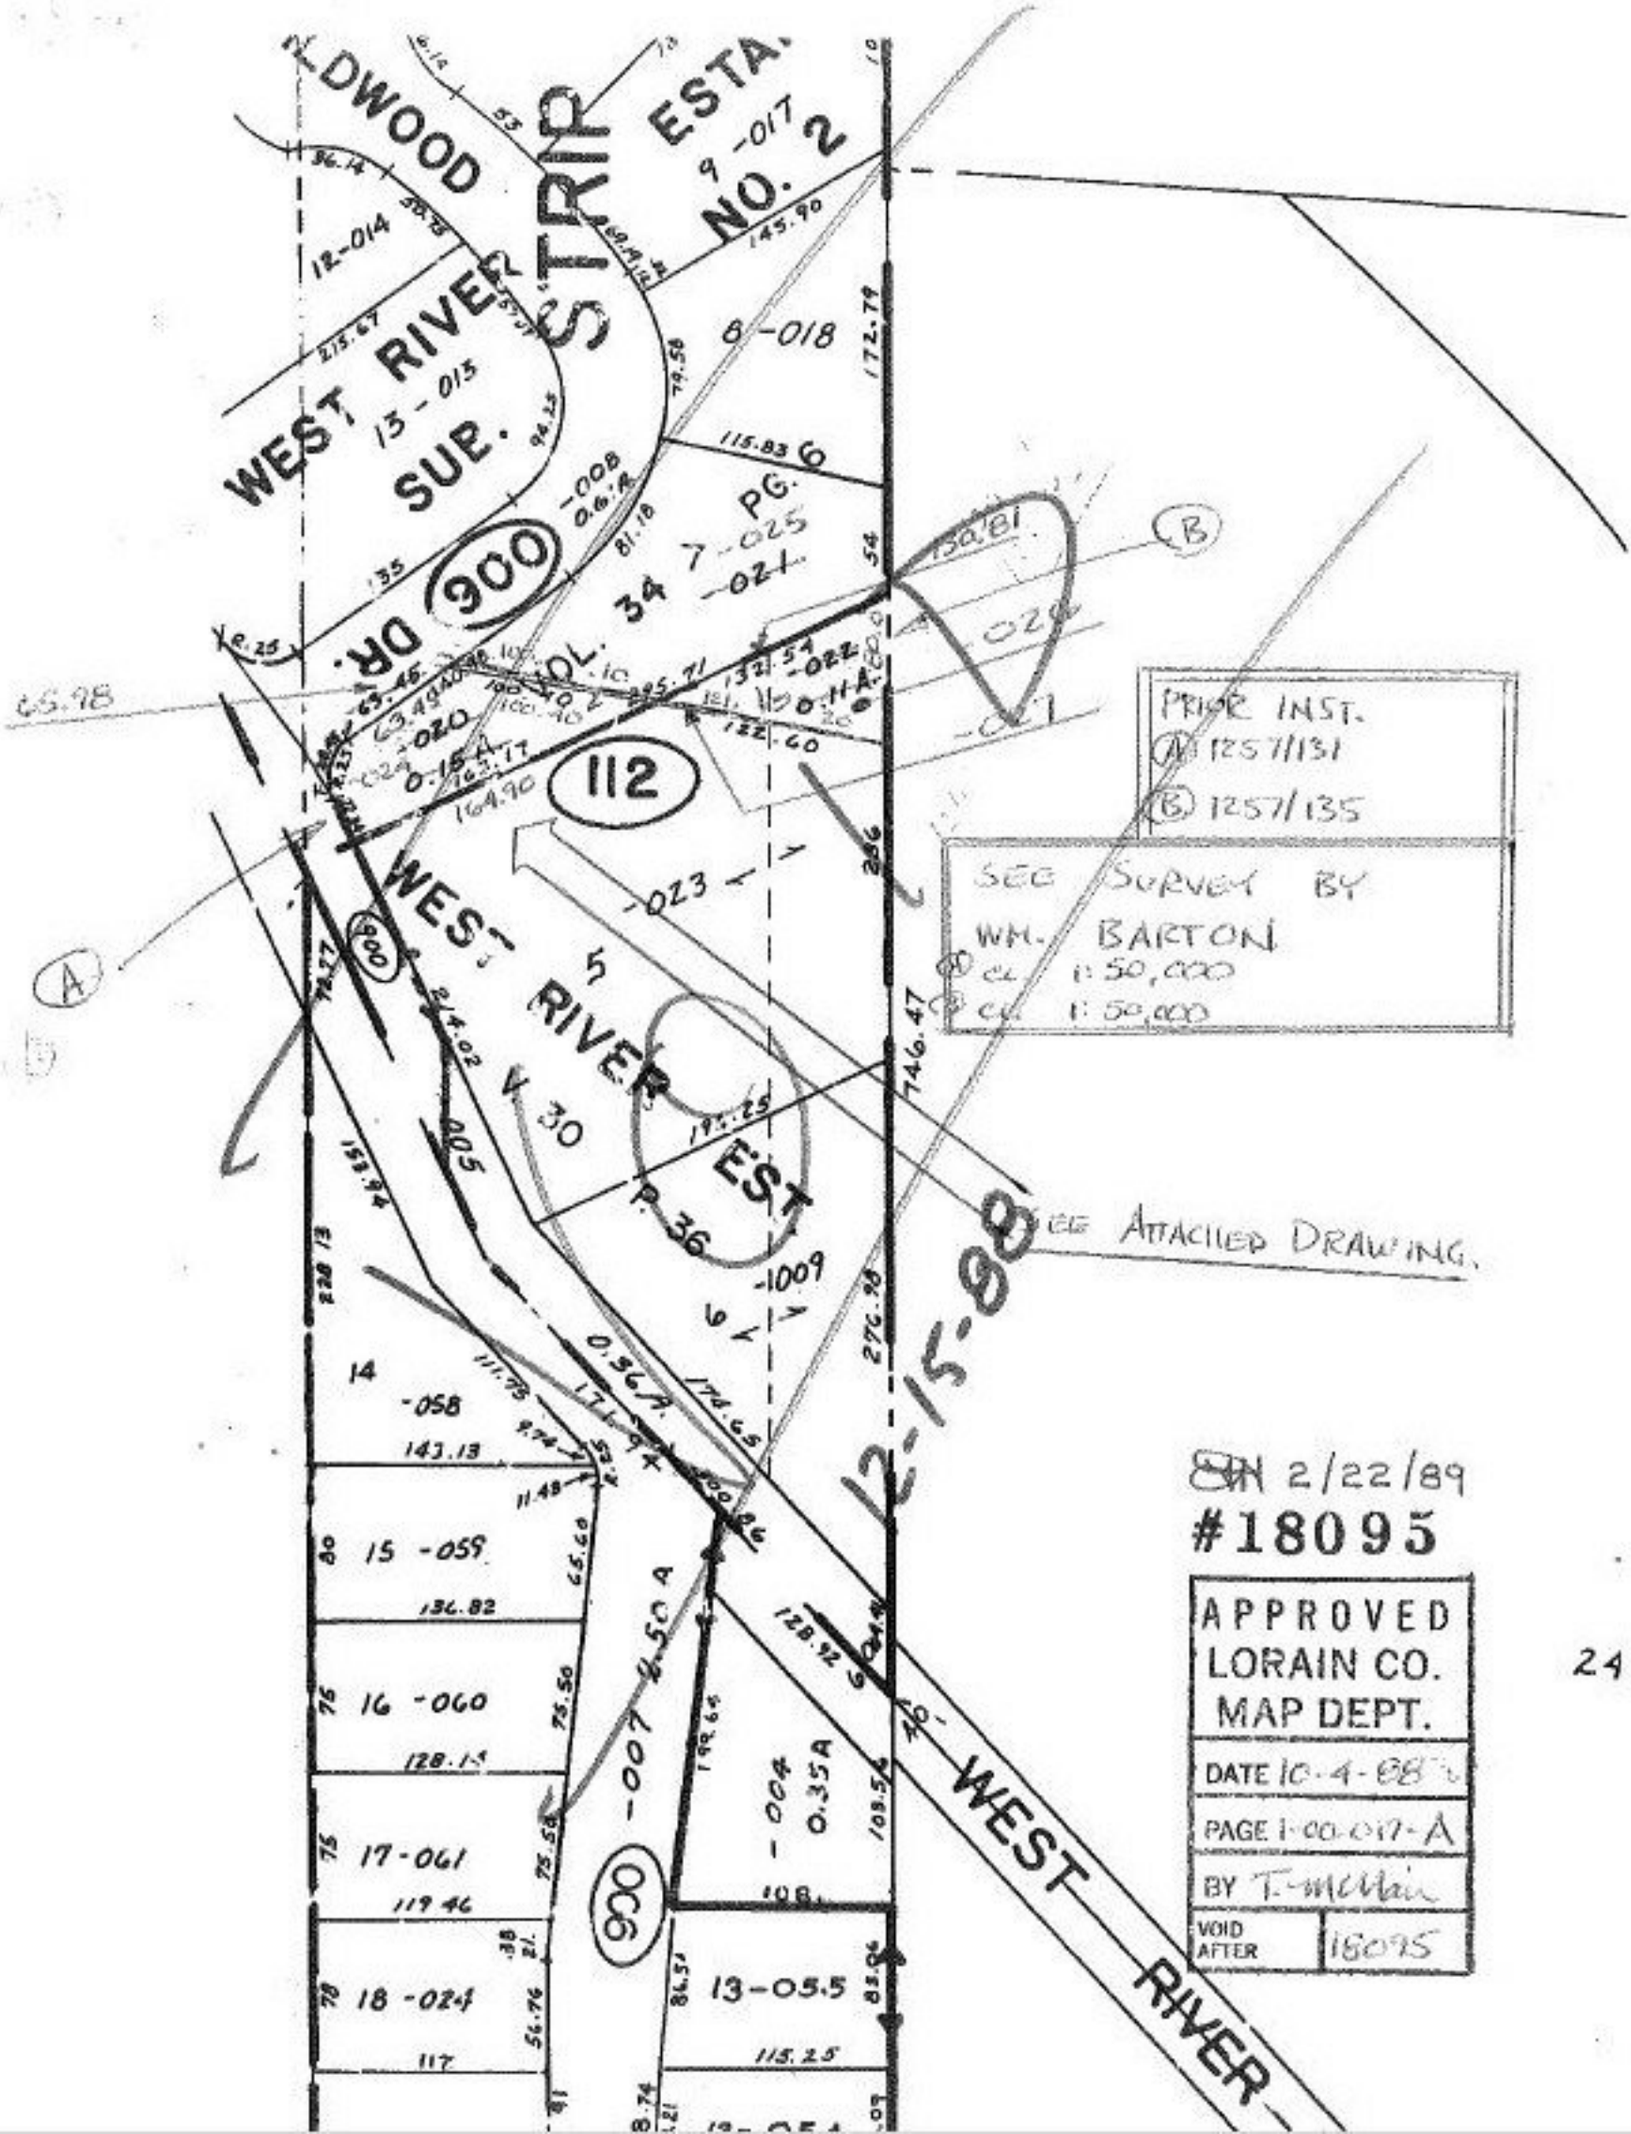
WEST RIVER STRIP
WEST RIVER SUB.
13-015
9-017
6-018
12-014
7-025
-021
-022
-020
-023
-1
-1009
-007
-004
-058
15-059
16-060
17-061
18-024
13-05.5
900
112
PG. 34
VOL. 10
PG. 36
VOL. 30
0.15 A.
0.11 A.
0.96 A.
4.50 A.
0.35 A.
PRIOR INST.
(A) 1257/131
(B) 1257/135
SEE SURVEY BY
WM. BARTON
1" = 50,000
1" = 50,000
SEE ATTACHED DRAWING.
12-15-88
#18095
APPROVED
LORAIN CO.
MAP DEPT.
DATE 10-4-88
PAGE 1-00-017-A
BY T. McClain
VOID AFTER 18095
WEST RIVER
24