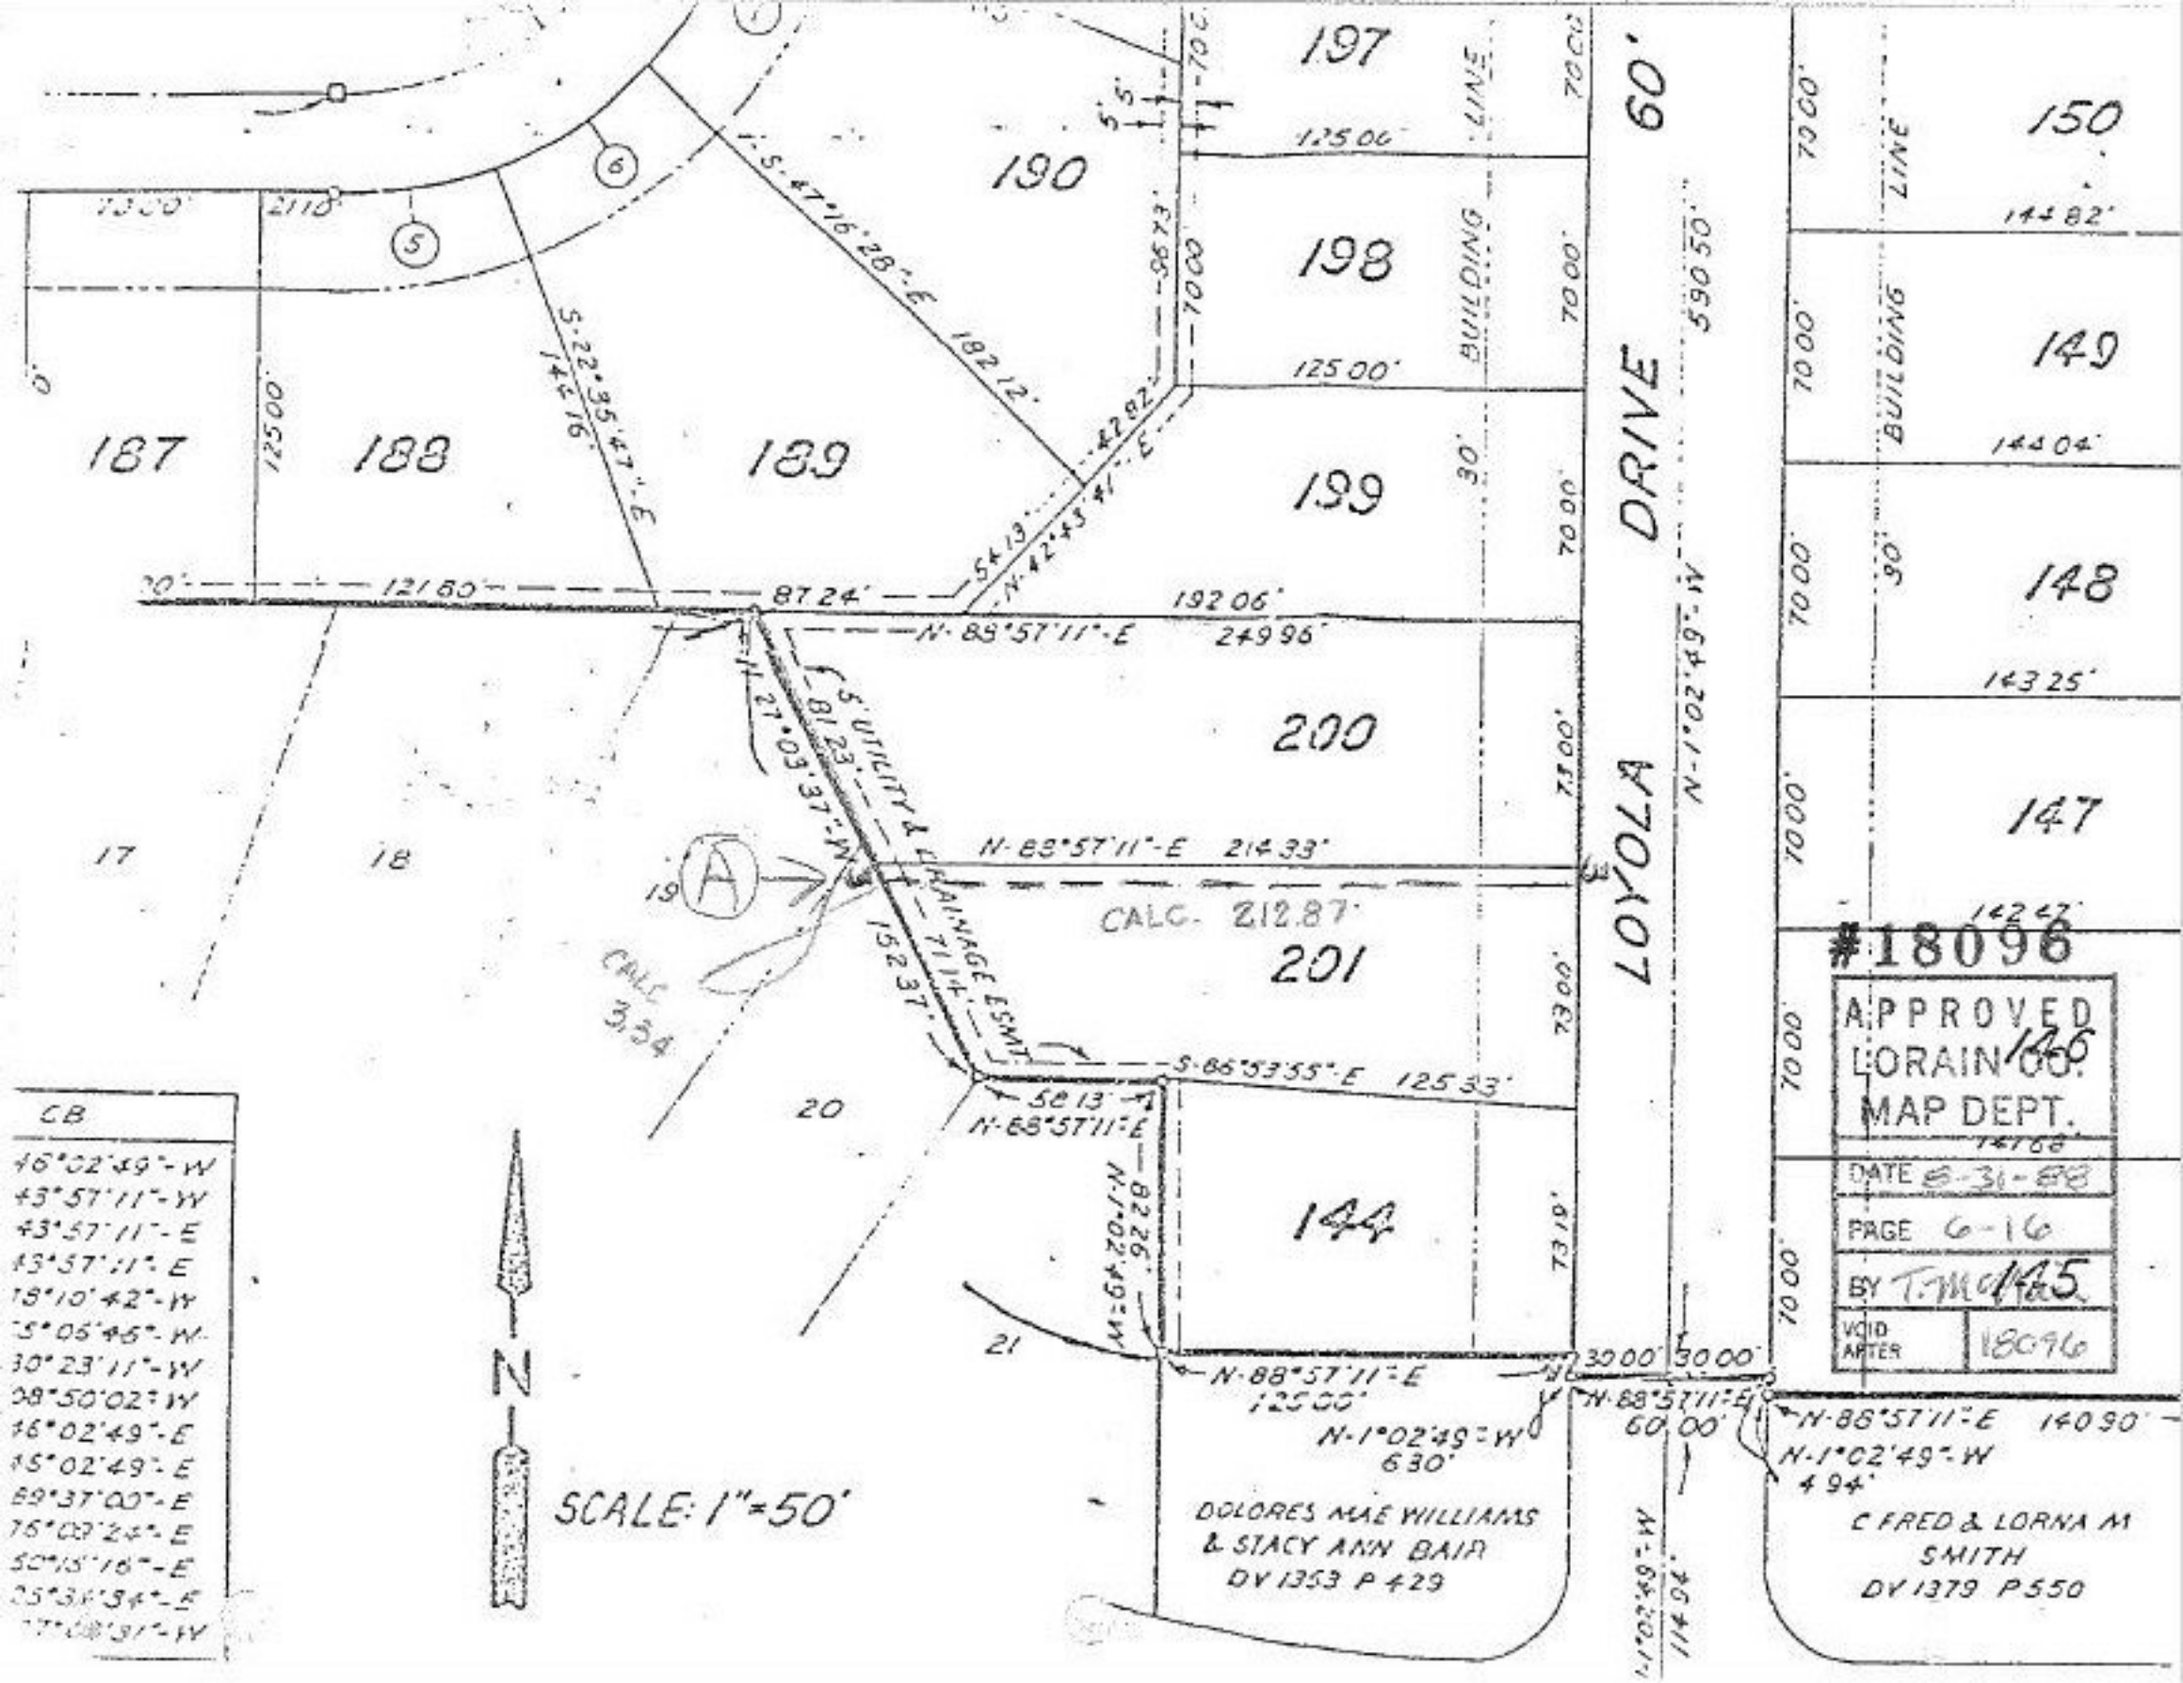
197
190
198
125.00'
70.00'
BUILDING LINE
187
188
189
199
125.00'
S.22°35'47"-E 142.76'
S.47°16'28"-E 182.12'
42.82'
S.42°43'41"-E
S.13°
N.42°43'41"-E
30'
121.60'
87.24'
192.06'
N.89°57'11"-E 249.96'
200
N.89°57'11"-E 214.33'
CALC. 212.87'
201
17
18
19
20
21
5' UTILITY & DRAINAGE ESMT.
N.27°03'37"-W 81.23'
N.27°03'37"-W 71.14'
152.37'
CALC. 3.34
S.86°53'55"-E 125.53'
S.13°
N.89°57'11"-E
N.1°02'49"-W 82.26'
144
N.1°02'49"-W 590.50'
60'
DRIVE
LOYOLA
150
144.82'
149
144.04'
148
143.25'
147
142.47'
#18096
APPROVED
LORAIN CO.
MAP DEPT.
DATE 6-31-88
PAGE 6-16
BY T.M.C.
VOID AFTER 18096
146
145
N.88°57'11"-E 125.00'
N.1°02'49"-W 630'
DOLORES MAE WILLIAMS & STACY ANN BAIR DV 1353 P 429
30.00'
30.00'
N.88°57'11"-E 60.00'
N.88°57'11"-E 140.90'
N.1°02'49"-W 494'
C FRED & LORNA M SMITH DV 1379 P 550
N.1°02'49"-W 114.94'
SCALE: 1"=50'
CB
46°02'49"-W
43°57'11"-W
43°57'11"-E
43°57'11"-E
18°10'42"-W
5°05'46"-W
30°23'11"-W
28°50'02"-W
46°02'49"-E
45°02'49"-E
89°37'00"-E
76°09'24"-E
50°13'16"-E
25°34'34"-E