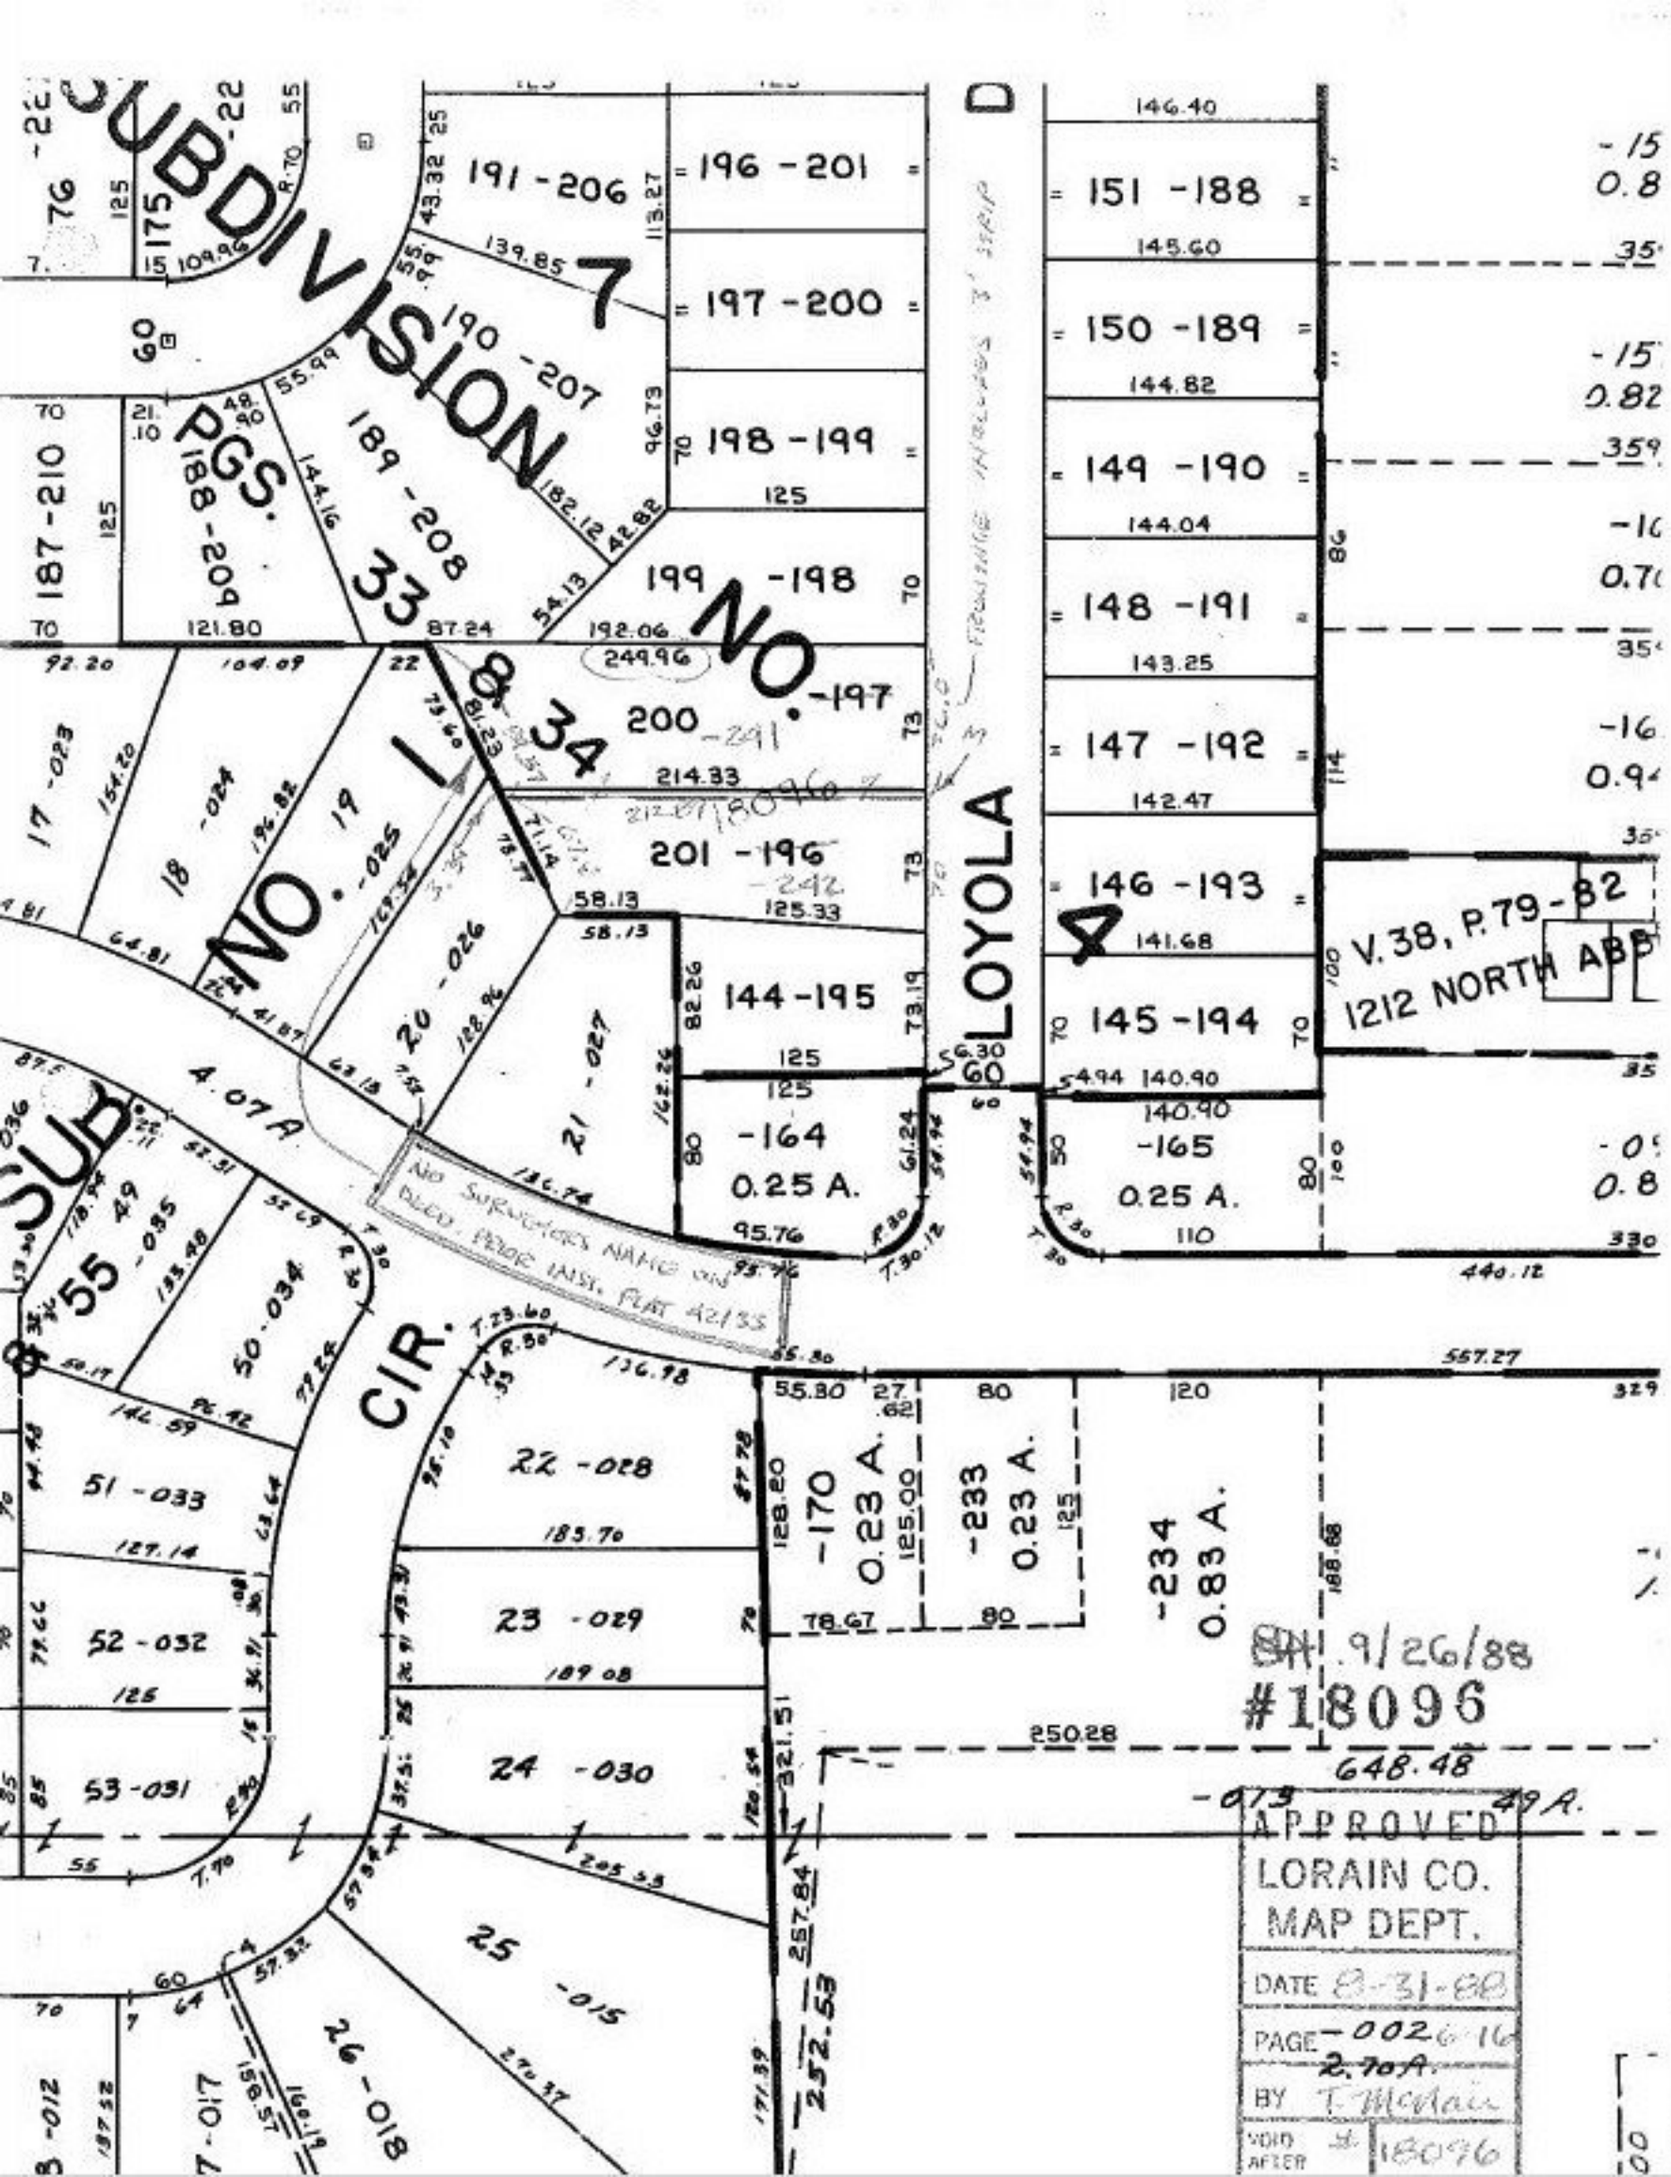
SUBDIVISION NO. 7
SUBDIVISION NO. 8
LOYOLA
CIR.
D
191 -206
196 -201
197 -200
198 -199
199 -198
200 -291
201 -196
-242
144 -195
-164
0.25 A.
-165
0.25 A.
-170
0.23 A.
-233
0.23 A.
-234
0.83 A.
151 -188
150 -189
149 -190
148 -191
147 -192
146 -193
145 -194
190 -207
189 -208
188 -209
187 -210
17 -023
18 -024
19 -025
20 -026
21 -027
22 -028
23 -029
24 -030
25 -015
26 -018
49 -035
50 -034
51 -033
52 -032
53 -031
55
60
No Surveyors Name on Deed. Page last. Plat 42/33
V. 38, P. 79-82
1212 NORTH ABB
9/26/88
#18096
APPROVED
LORAIN CO.
MAP DEPT.
DATE 8-31-88
PAGE 0026-16
BY T. McClain
VOID AFTER 18096