DETAIL: DEDICATION PLAT GUILFORD RD.

ST. RT. 6 V. 34 P. 44

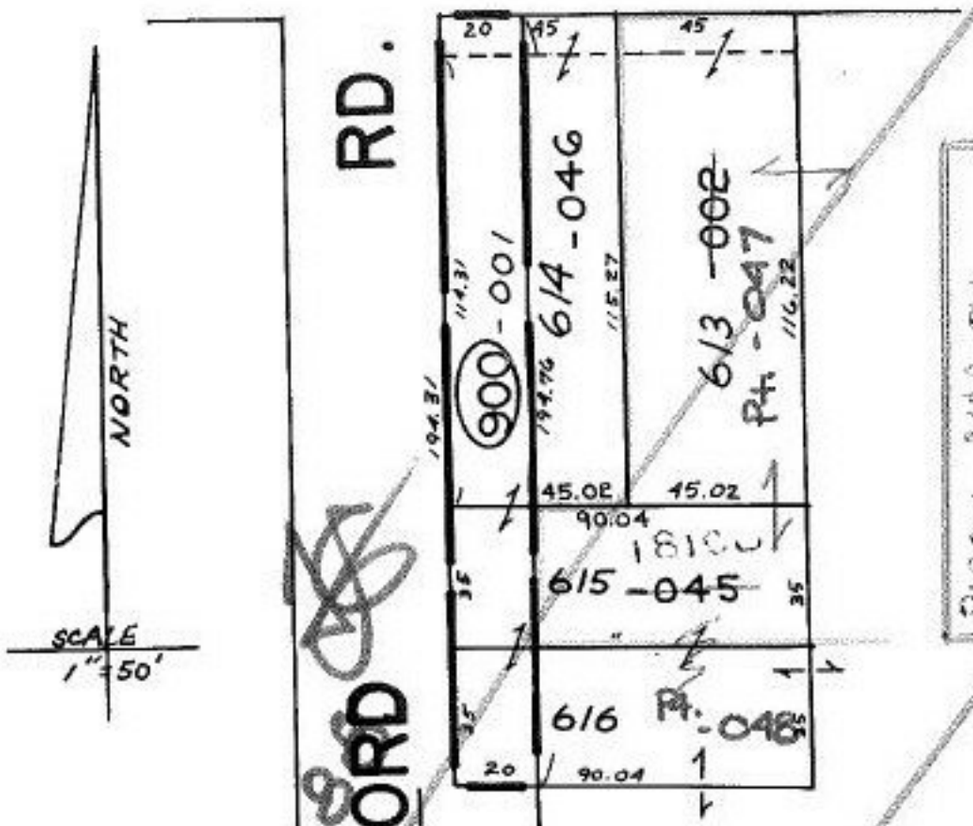

PARCEL MAP BY D. EDWARDS K.S. ASSOC. ALL SURVEYS - PAINT RUN AND SOURCE 6/1/920 PRIOR DEED 76/136

E SUB. NO. 2

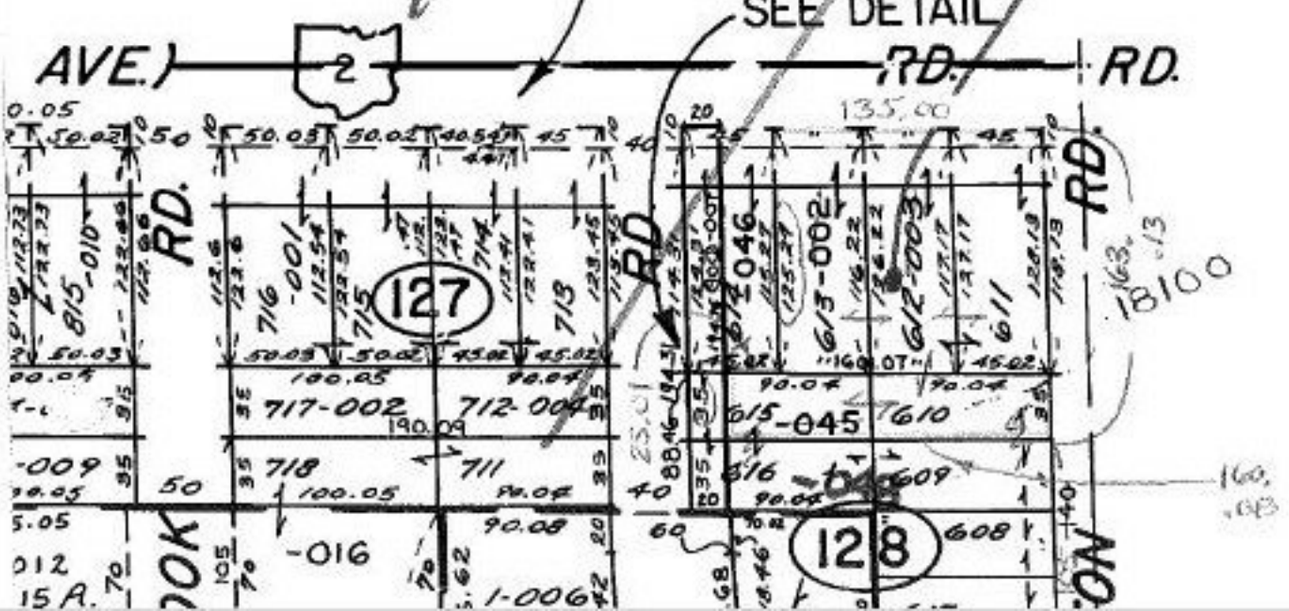

2/22/89

#18100

APPROVED LORAIN CO. MAP DEPT.	
DATE 9-21-88	
PAGE 1-00-005-C	
BY T. Meglan	
VOID AFTER	18100