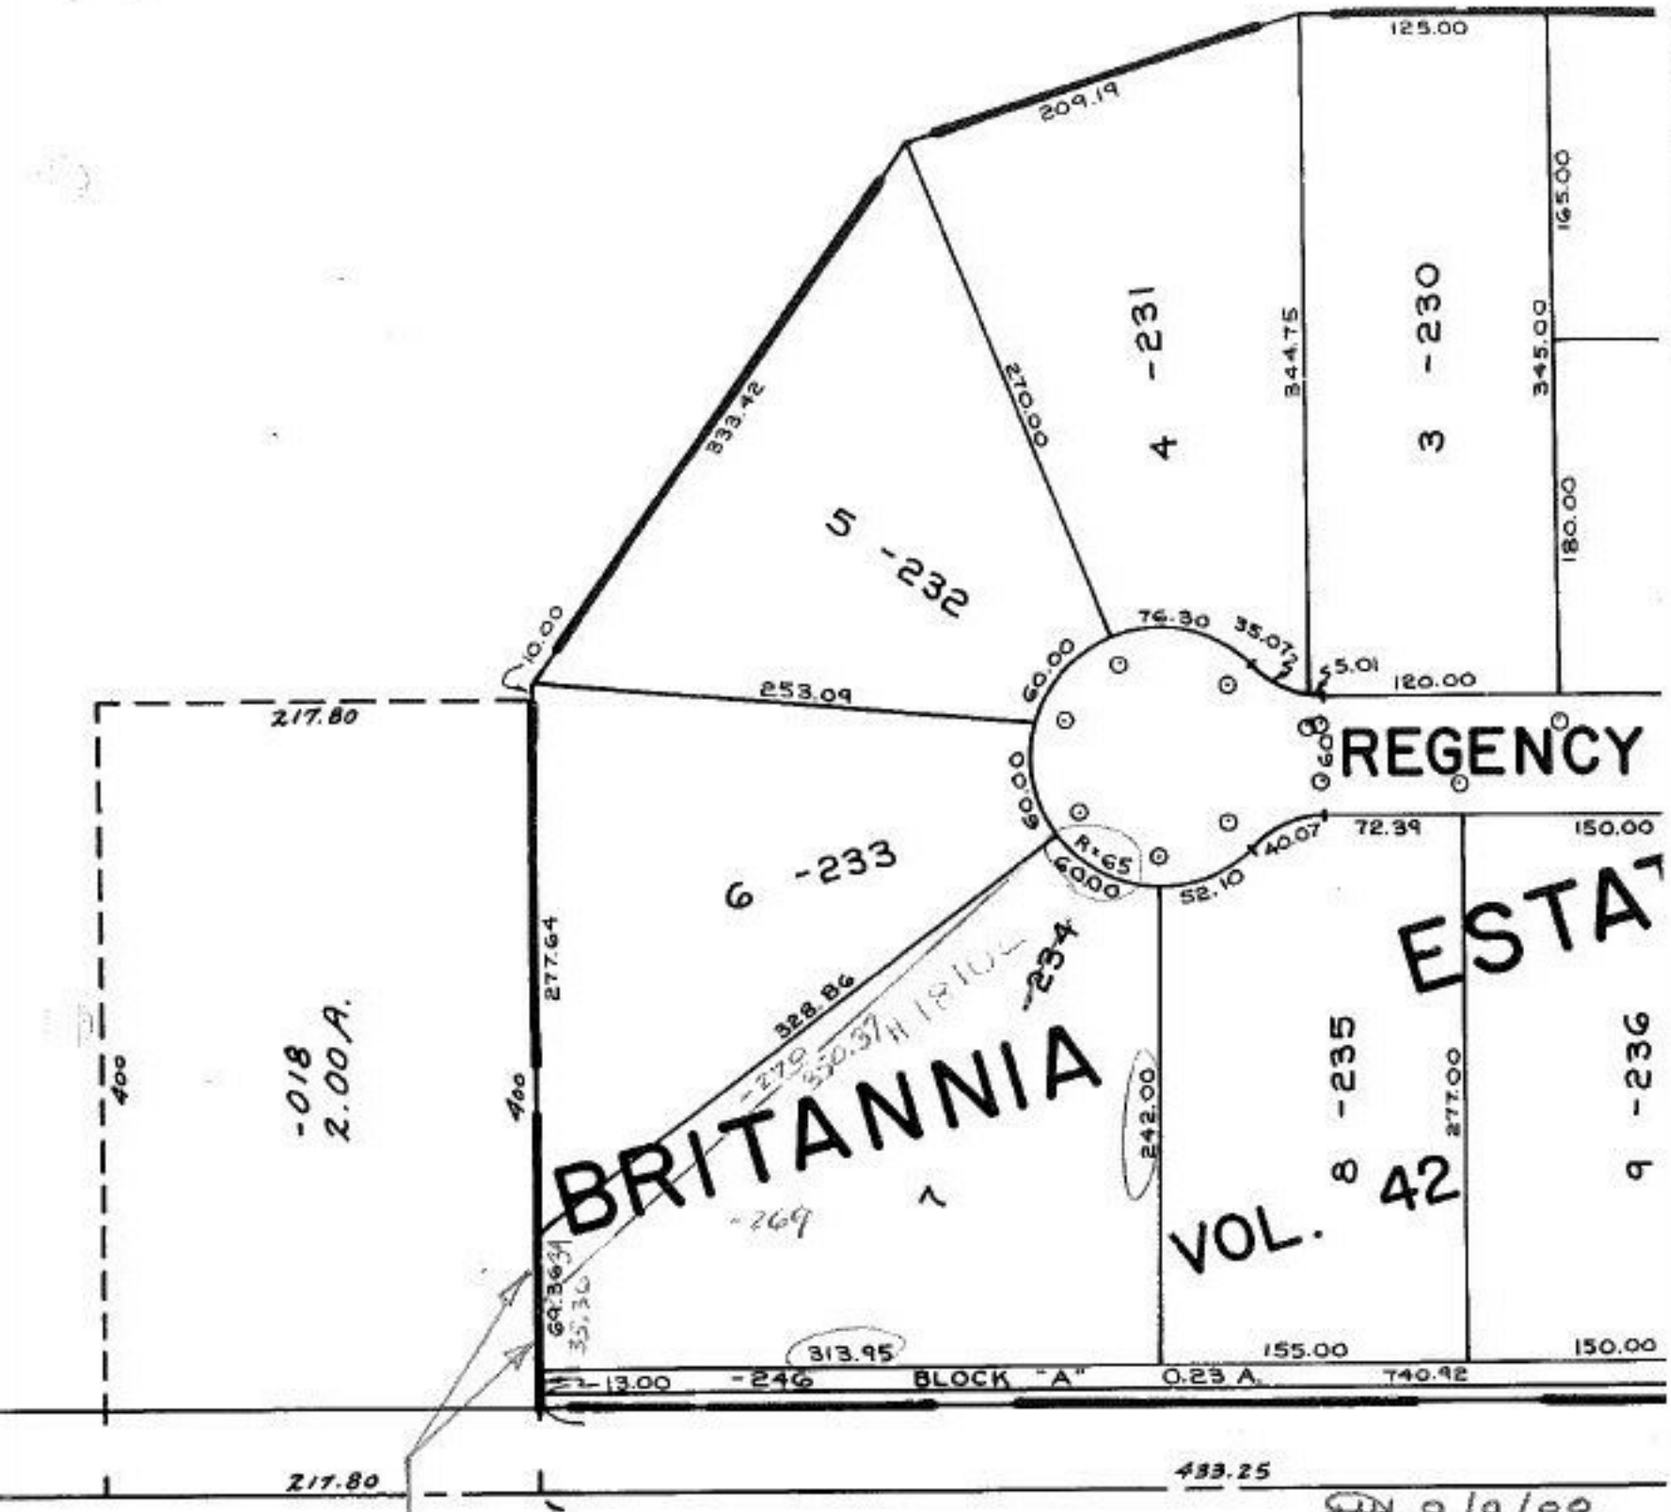

Surveyed by K.S. Assoc.
Cl. I: 200,000
Prior Deed 1375/132 & 137

9/9/88

SEE 4-00-020-#18102

APPROVED
LORAIN CO.
MAP DEPT.
DATE 9-1-88
PAGE 4-00-019-J
BY T. McClain
VOID AFTER 18102

AVON LAKE CITY