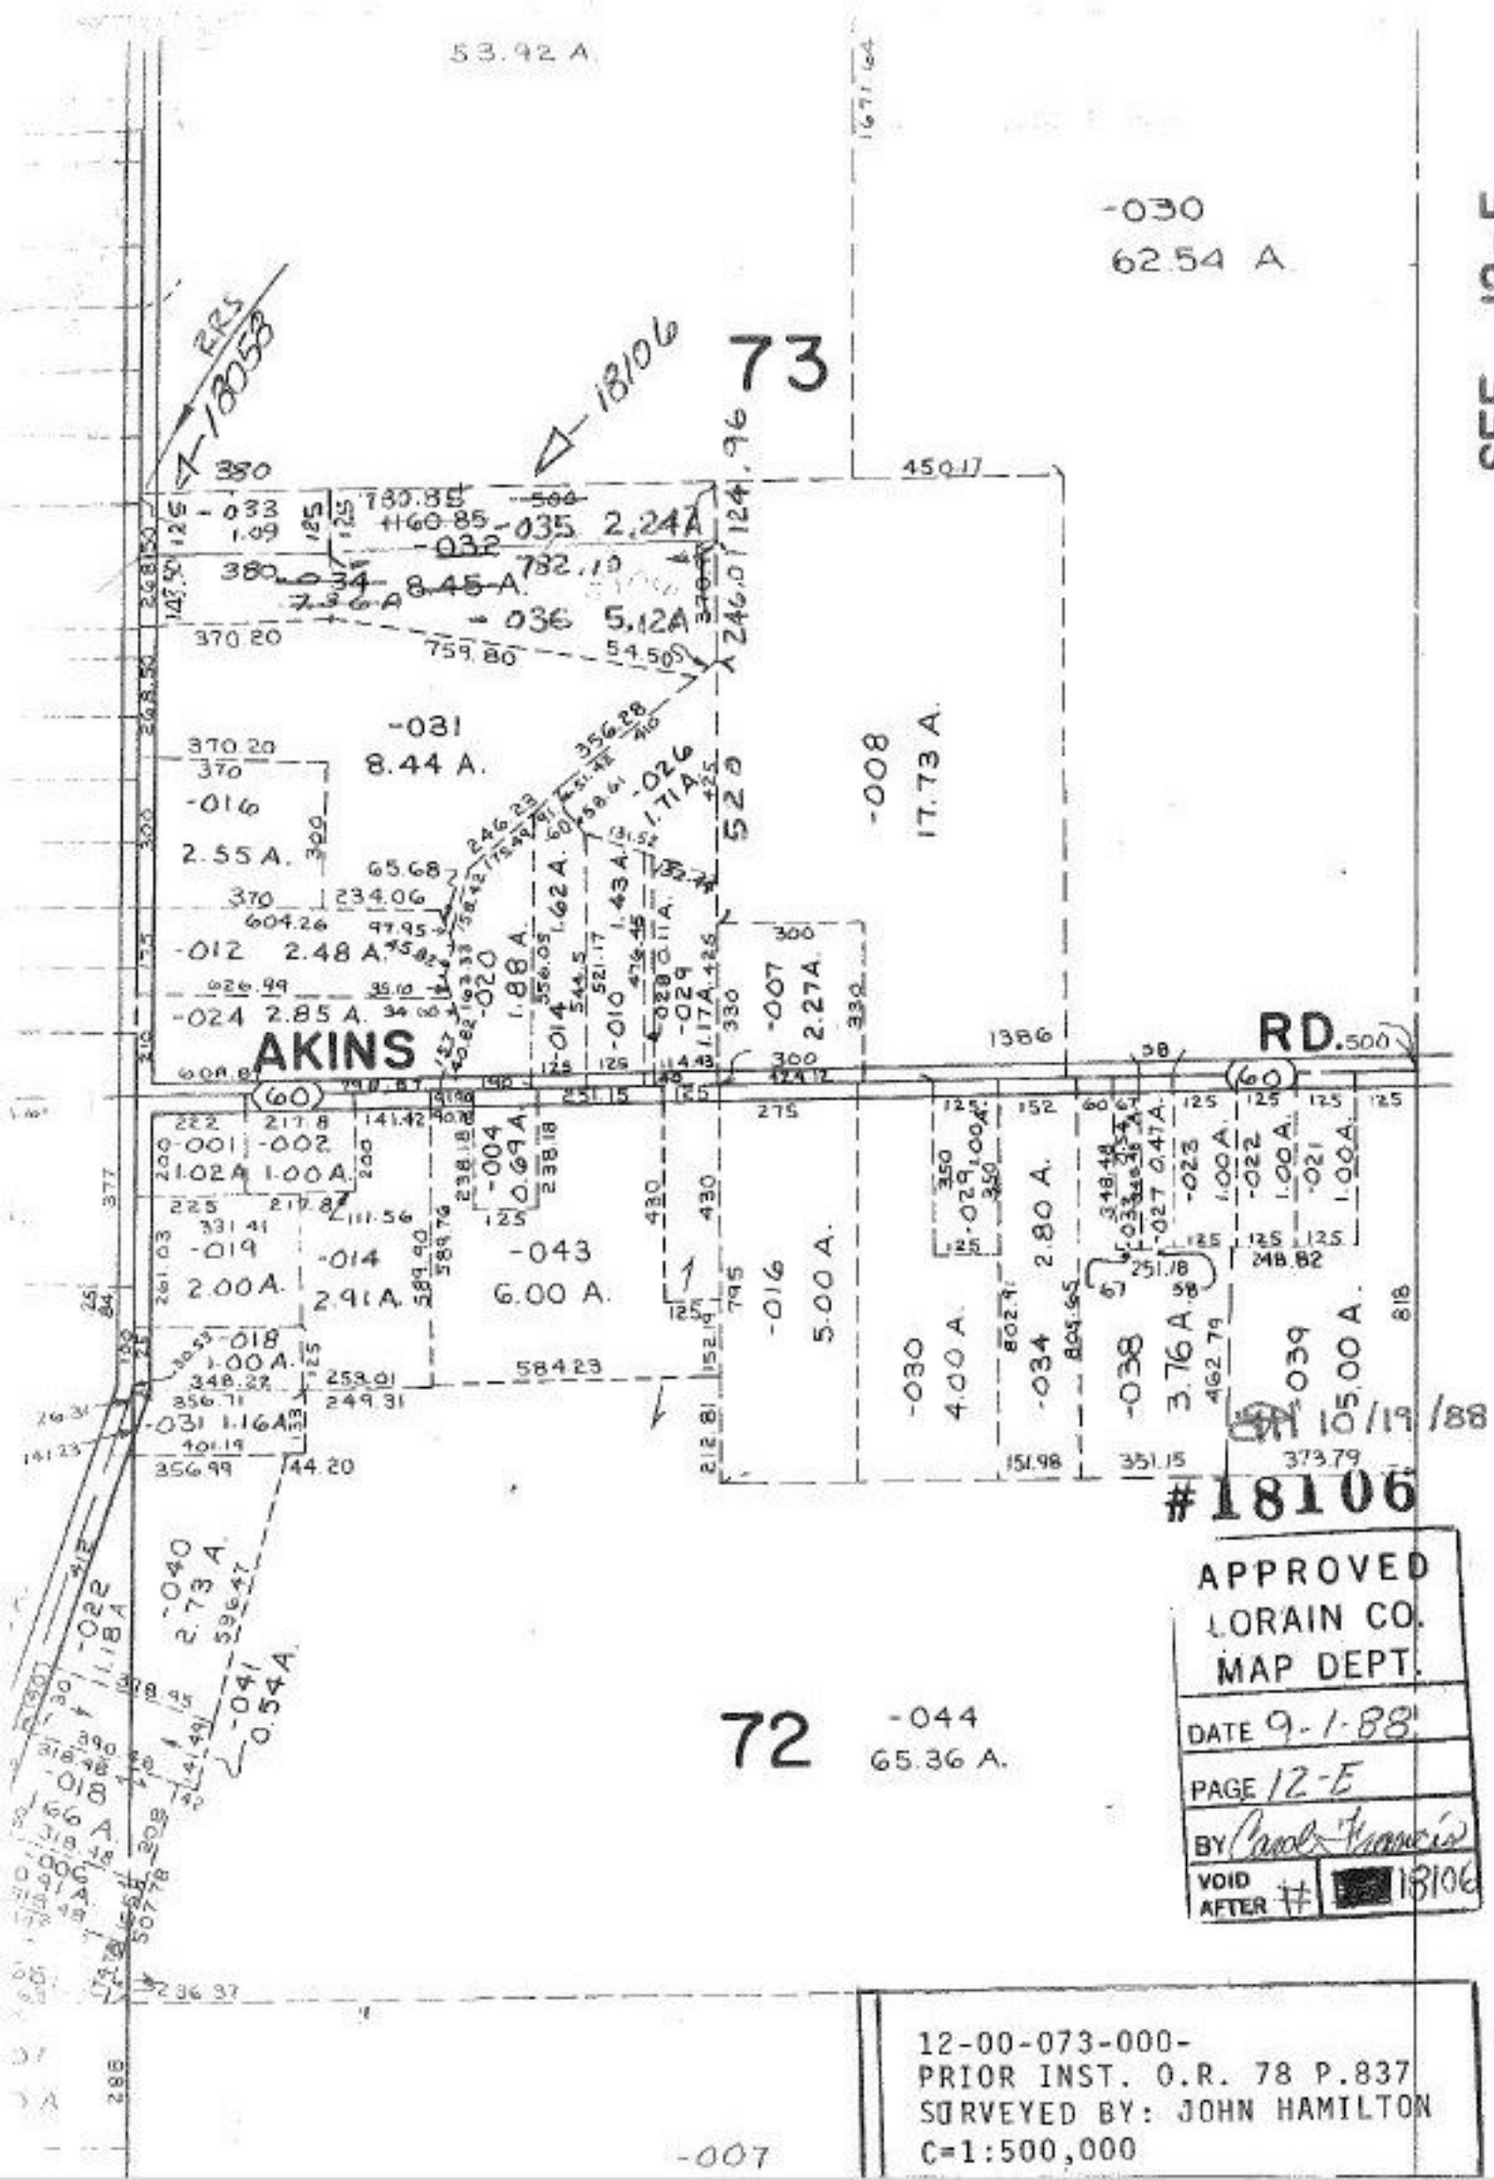
53.92 A.
-030
62.54 A.
SEE 12-F
73
18106
18053
-035 2.24A
-032
8.45 A.
-036 5.12A
-031
8.44 A.
-016
2.55 A.
-012 2.48 A.
-024 2.85 A.
-026
1.71A.
-008
17.73 A.
-020
1.88 A.
-029
1.17A.
-007
2.27A.
AKINS RD.
-001
1.02A.
-002
1.00A.
-004
0.69A.
-019
2.00A.
-014
2.91A.
-043
6.00 A.
-016
5.00 A.
-030
4.00 A.
-034
2.80 A.
-038
3.76 A.
-039
105.00 A.
-018
1.00A.
-031 1.16A.
-040
2.73 A.
-041
0.54A.
-022
1.18A.
72
-044
65.36 A.
-007
#18106
APPROVED
LORAIN CO.
MAP DEPT.
DATE 9-1-88
PAGE 12-E
BY Carol Francis
VOID AFTER # 18106
12-00-073-000-
PRIOR INST. O.R. 78 P.837
SURVEYED BY: JOHN HAMILTON
C=1:500,000