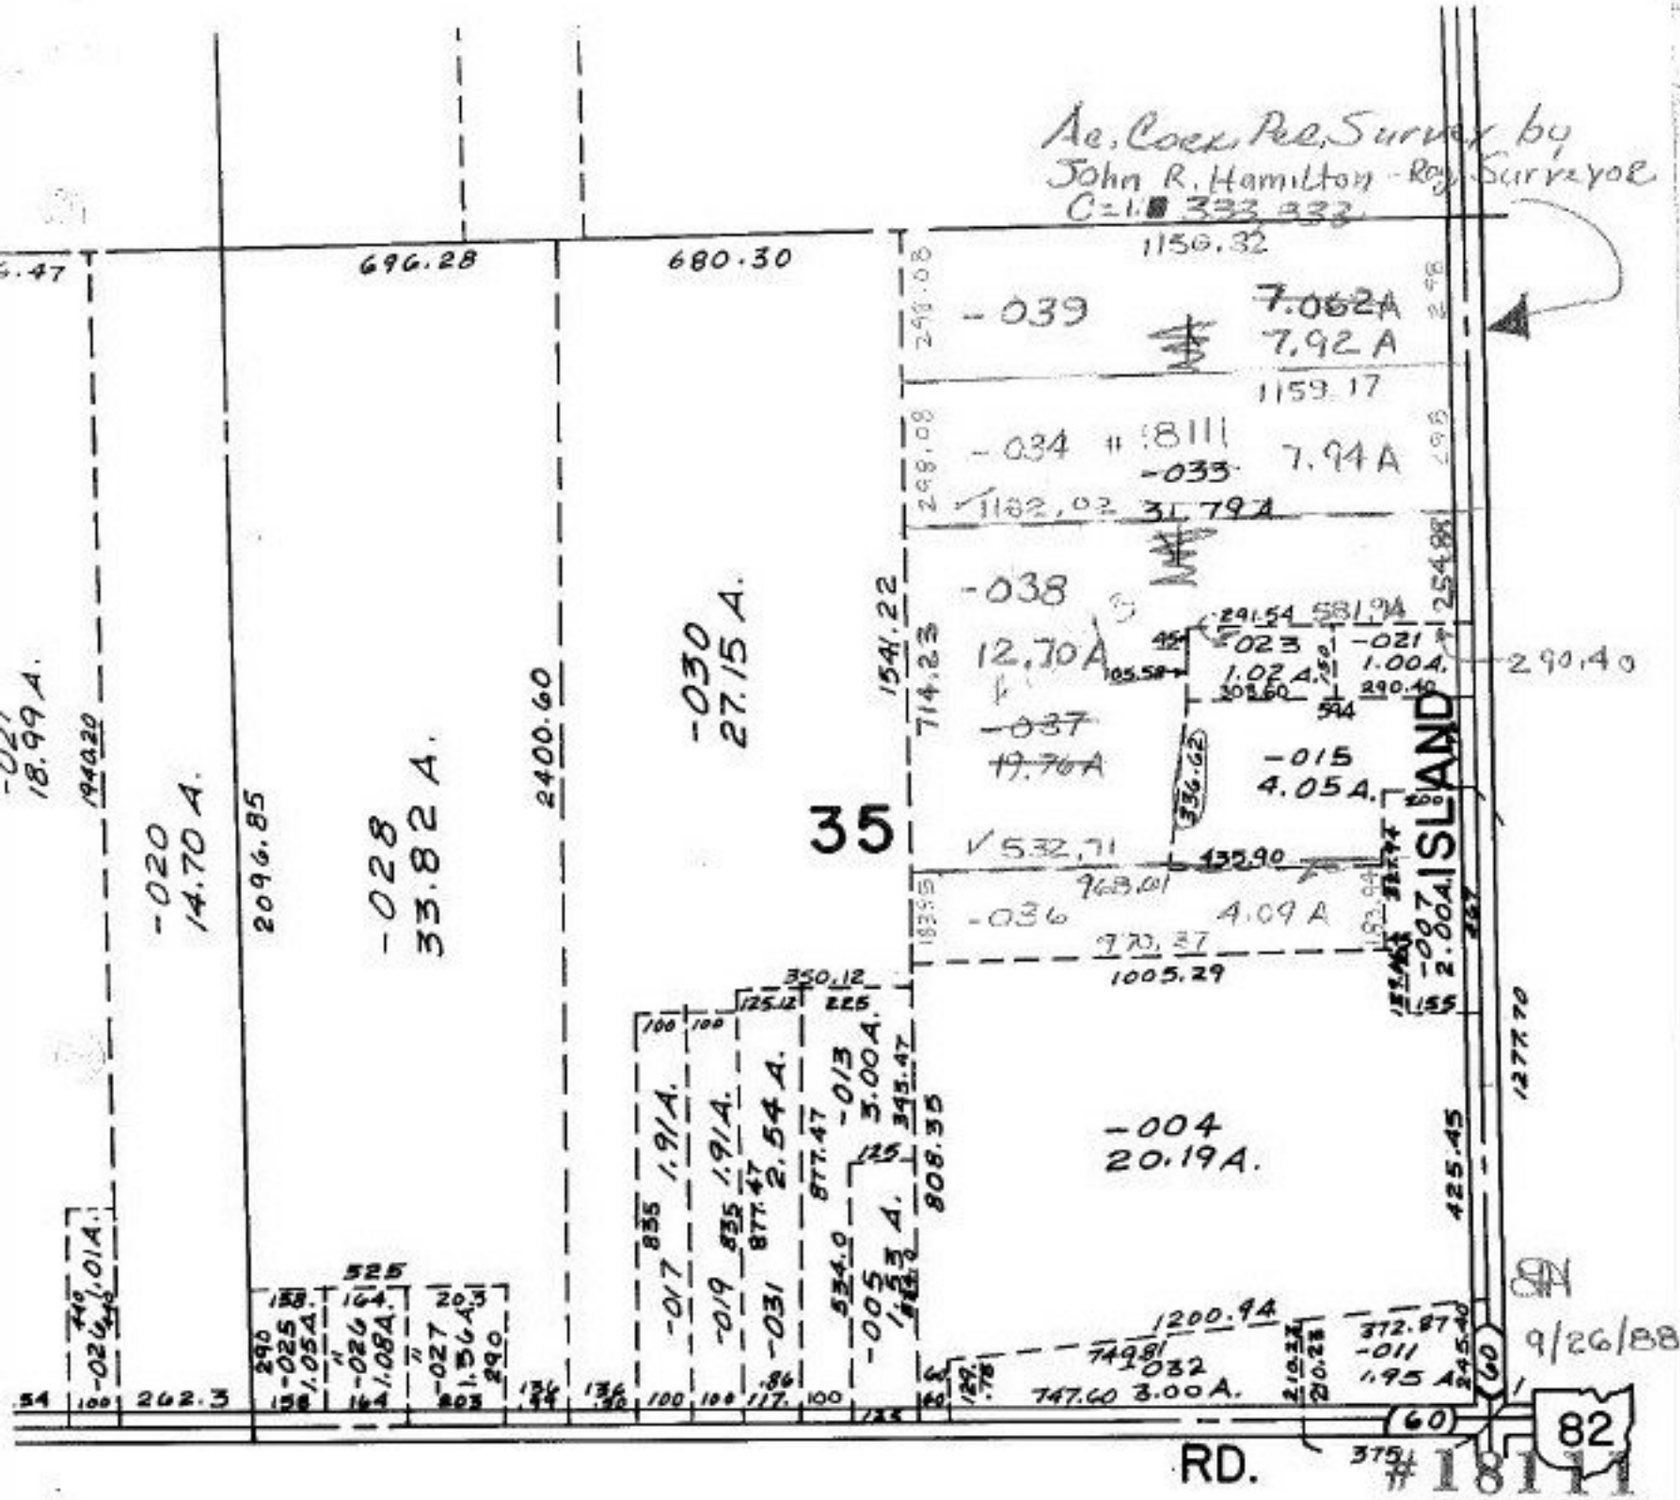

S 31 THRU 35,46 THRU 50

APPROVED
LORAIN CO.
MAP DEPT.
DATE 9-7-88
PAGE 11-C
BY Carol Frances
VOID AFTER #18111

11-00-035-000-
PRIOR INST. DV. 961 - Pgs. 133, 5, 7
SURVEYED BY: J. HAMILTON
C=1:333,333. REG. SURVEYOR