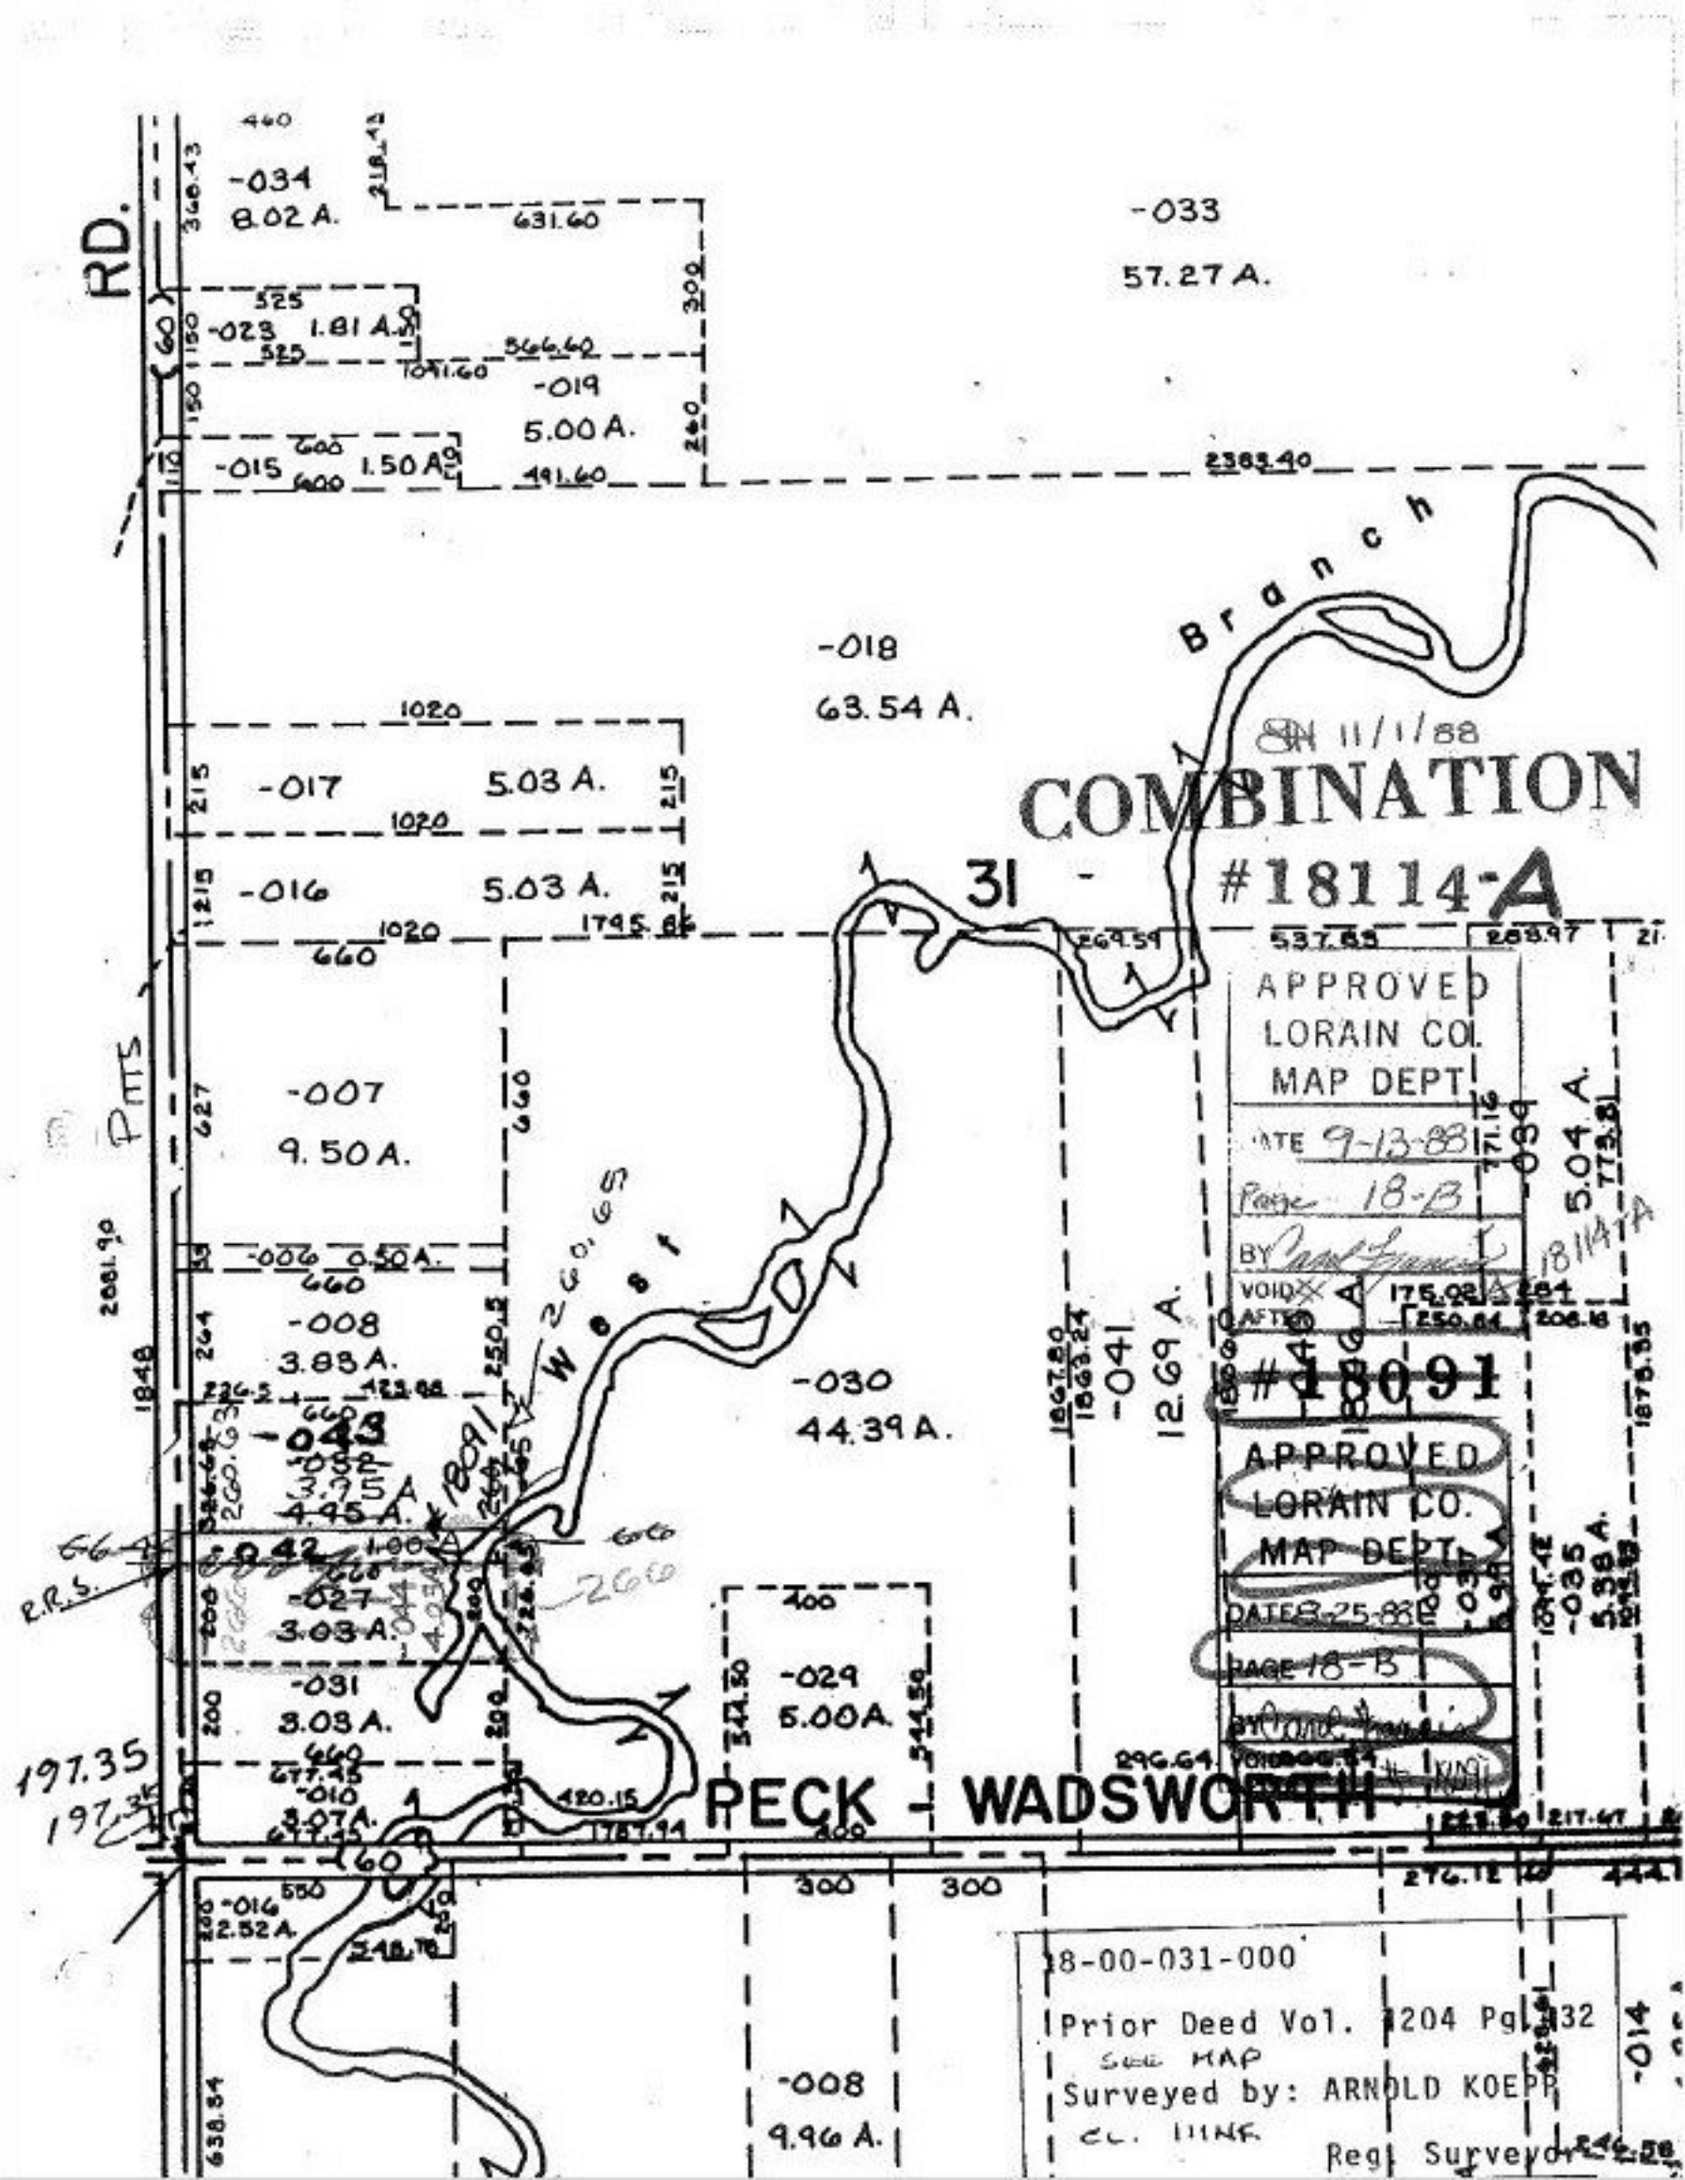
RD.
-034
8.02 A.
-033
57.27 A.
-023 1.81 A.
-019
5.00 A.
-015 1.50 A.
-018
63.54 A.
Branch
-017 5.03 A.
-016 5.03 A.
31
COMBINATION
#18114-A
APPROVED
LORAIN CO.
MAP DEPT.
DATE 9-13-88
Page 18-B
BY
VOID
AFTER
-007
9.50 A.
-006 0.50 A.
-008
3.83 A.
-043
-032
3.75 A
4.45 A.
-042
-027
3.03 A.
-031
3.03 A.
-010
3.07 A.
-030
44.39 A.
-041
12.69 A.
#18091
APPROVED
LORAIN CO.
MAP DEPT.
DATE 8-25-88
PAGE 18-B
-029
5.00 A.
PECK - WADSWORTH
-016
2.52 A.
-008
9.96 A.
-014
-039
5.04 A.
-035
5.38 A.
R.R.S.
197.35
18-00-031-000
Prior Deed Vol. 1204 Pg. 132
SEE MAP
Surveyed by: ARNOLD KOEPP
Reg. Surveyor