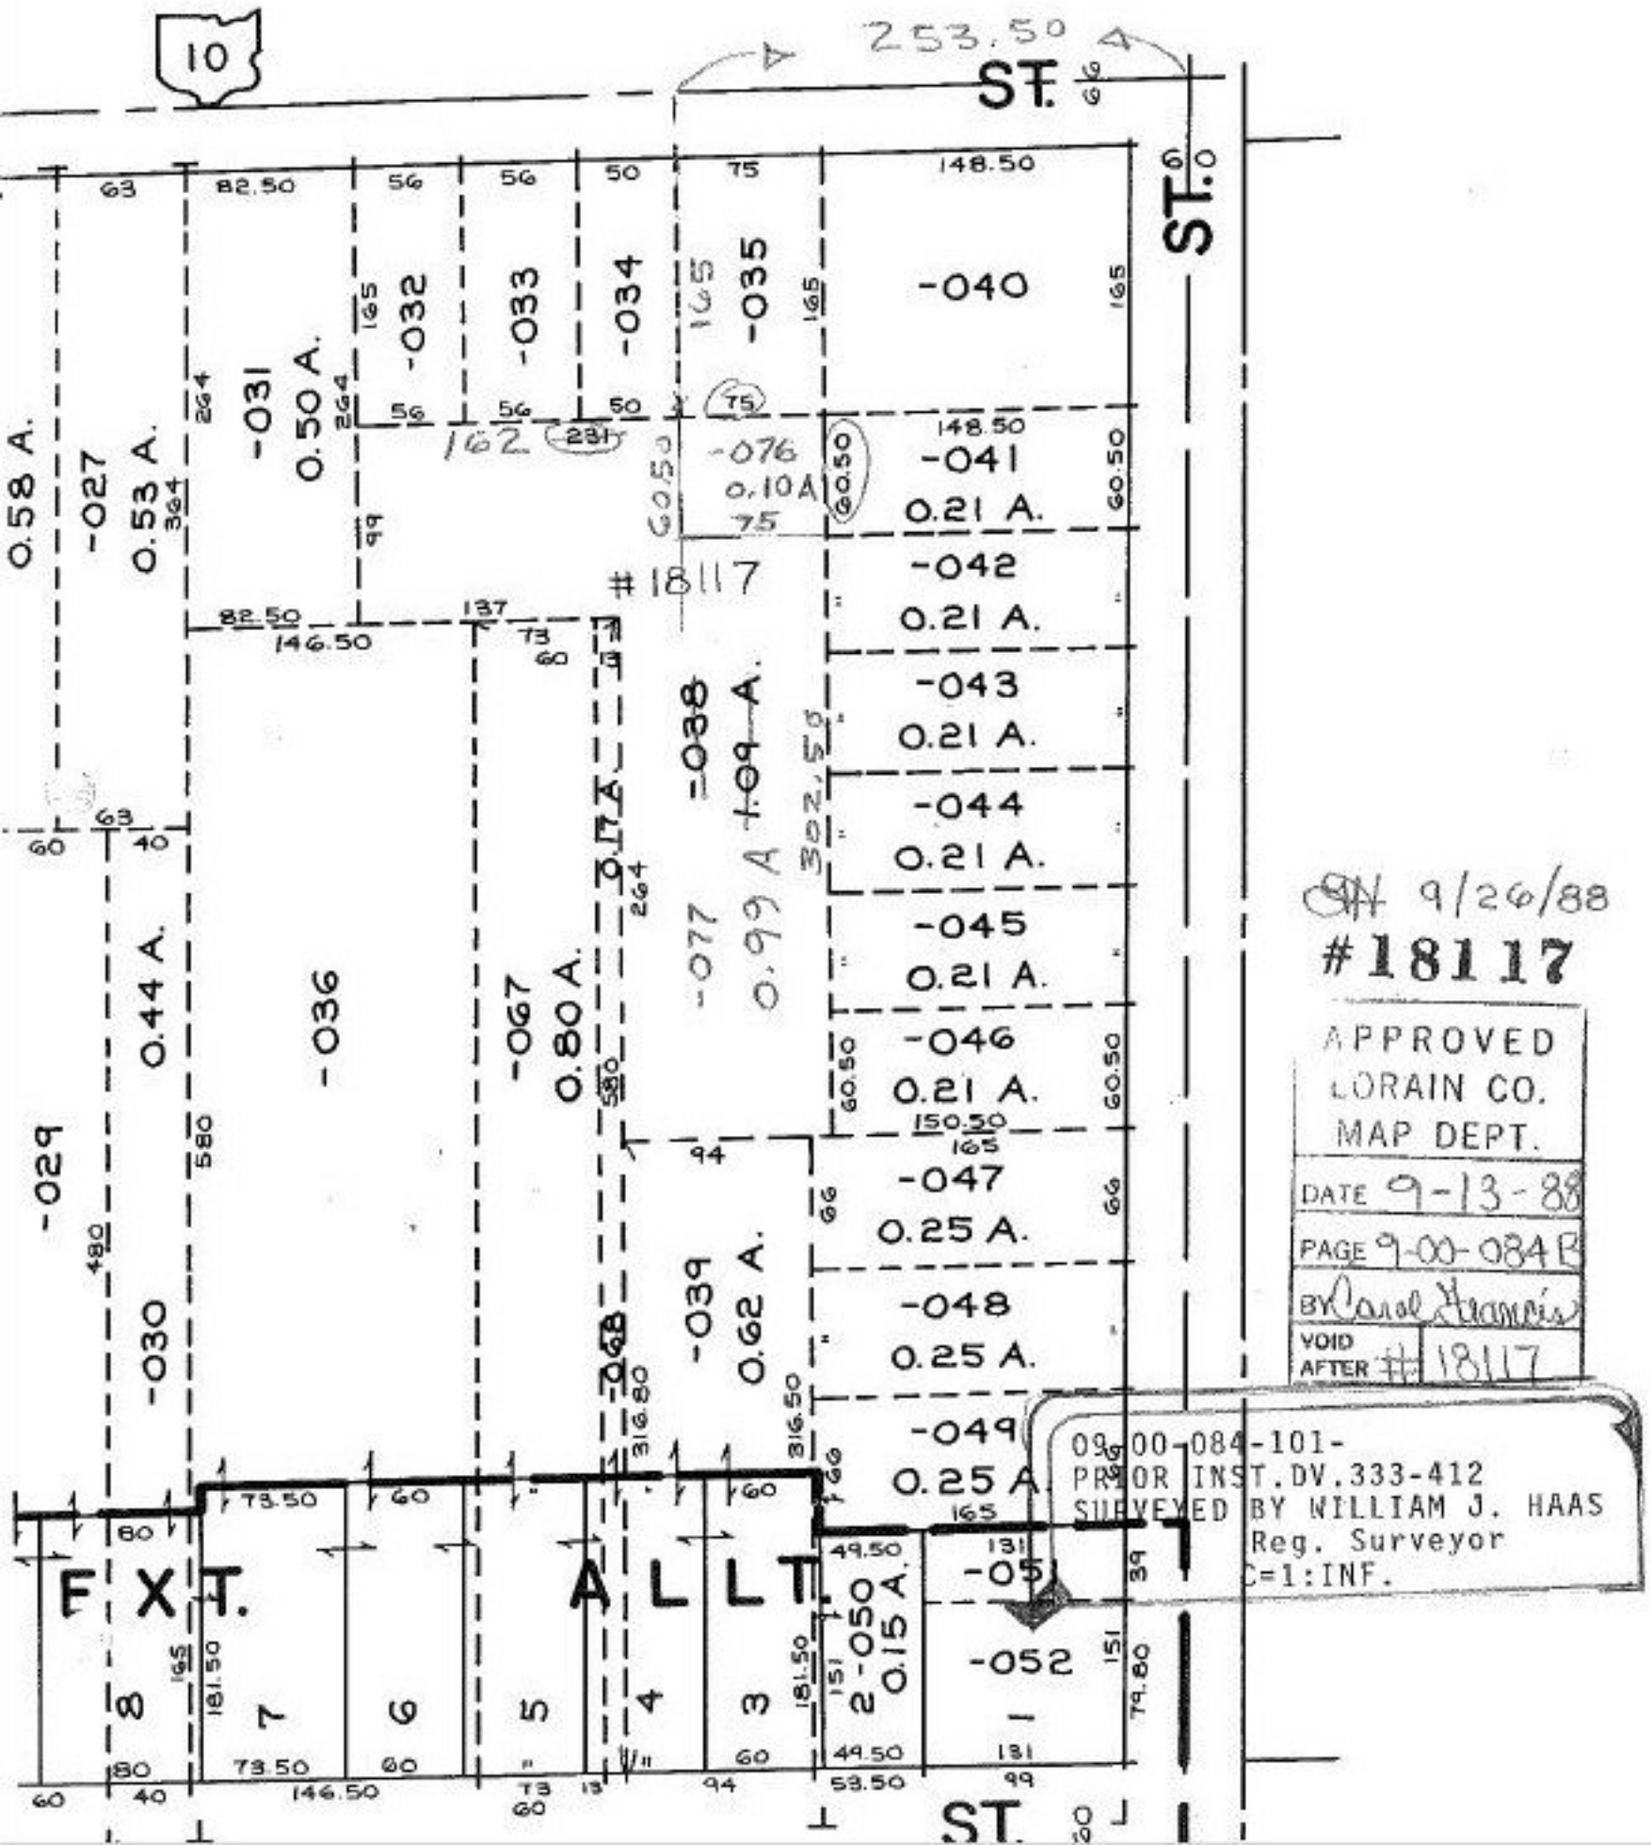

9/26/88
#18117

APPROVED
LORAIN CO.
MAP DEPT.
DATE 9-13-88
PAGE 9-00-084B
BY Carol Francis
VOID AFTER #: 18117

09-00-084-101-
PRIOR INST. DV. 333-412
SURVEYED BY WILLIAM J. HAAS
Reg. Surveyor
C=1:INF.