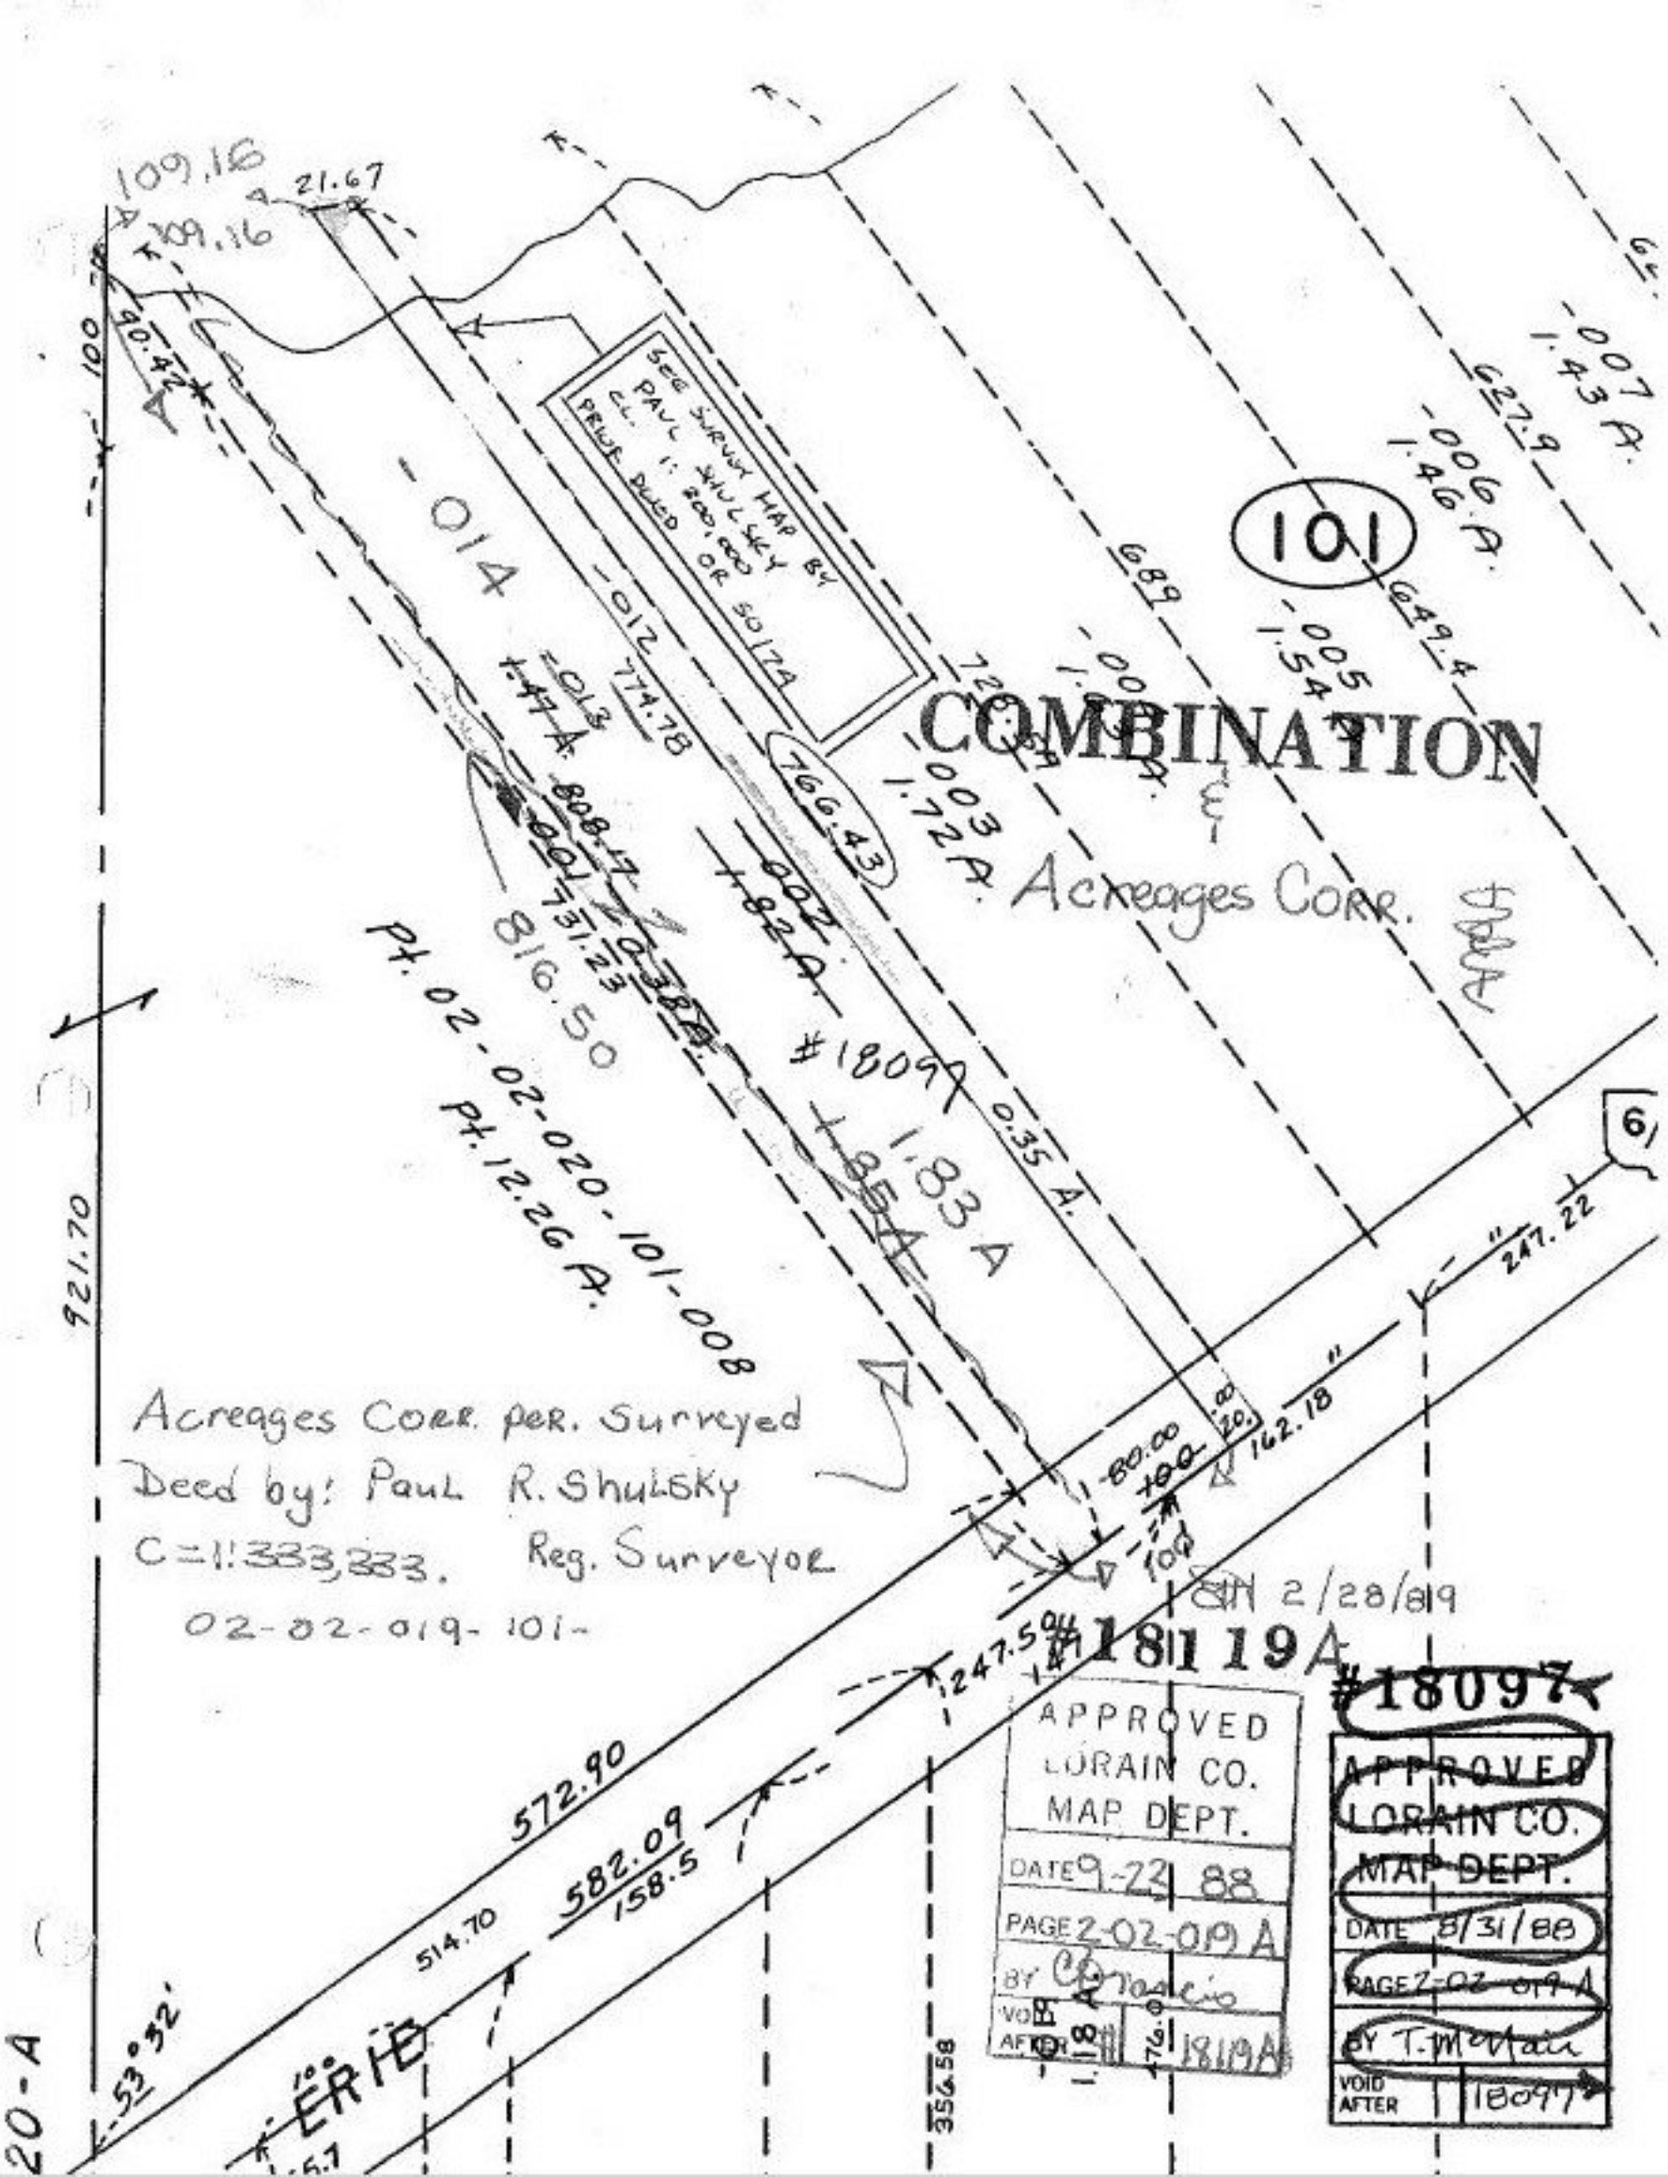

109.16
21.67
109.16
90.42
100
-014
-012
774.78
-013
1.47 A.
808.17
-001
731.23
816.50
Pt. 02-02-020-101-008
Pt. 12.26 A.
SEE SURVEY MAP BY PAUL SHULSKY CL. 1: 200,000 PRIOR DEED OR 50174
766.43
-002
1.82 A.
#18097
1.83 A
1.85 A
0.35 A.
689
-003
1.72 A.
-005
1.54 A.
649.4
-006
1.46 A.
627.9
-007
1.43 A.
101
COMBINATION
Acreages Corr.
Acreages Corr. per. Surveyed
Deed by: Paul R. Shulsky
C=1:333,333. Reg. Surveyor
02-02-019-101-
921.70
247.22
162.18
80.00
100
20.
100
2/28/89
#18119A
247.50
572.90
582.09
158.5
514.70
53°32'
ERIE
356.58
20-A
APPROVED
LORAIN CO.
MAP DEPT.
DATE 9-23 88
PAGE 2-02-019 A
BY
VOID AFTER
#18119A
#18097
APPROVED
LORAIN CO.
MAP DEPT.
DATE 8/31/88
PAGE 2-02-019-A
BY T. McNair
VOID AFTER
18097