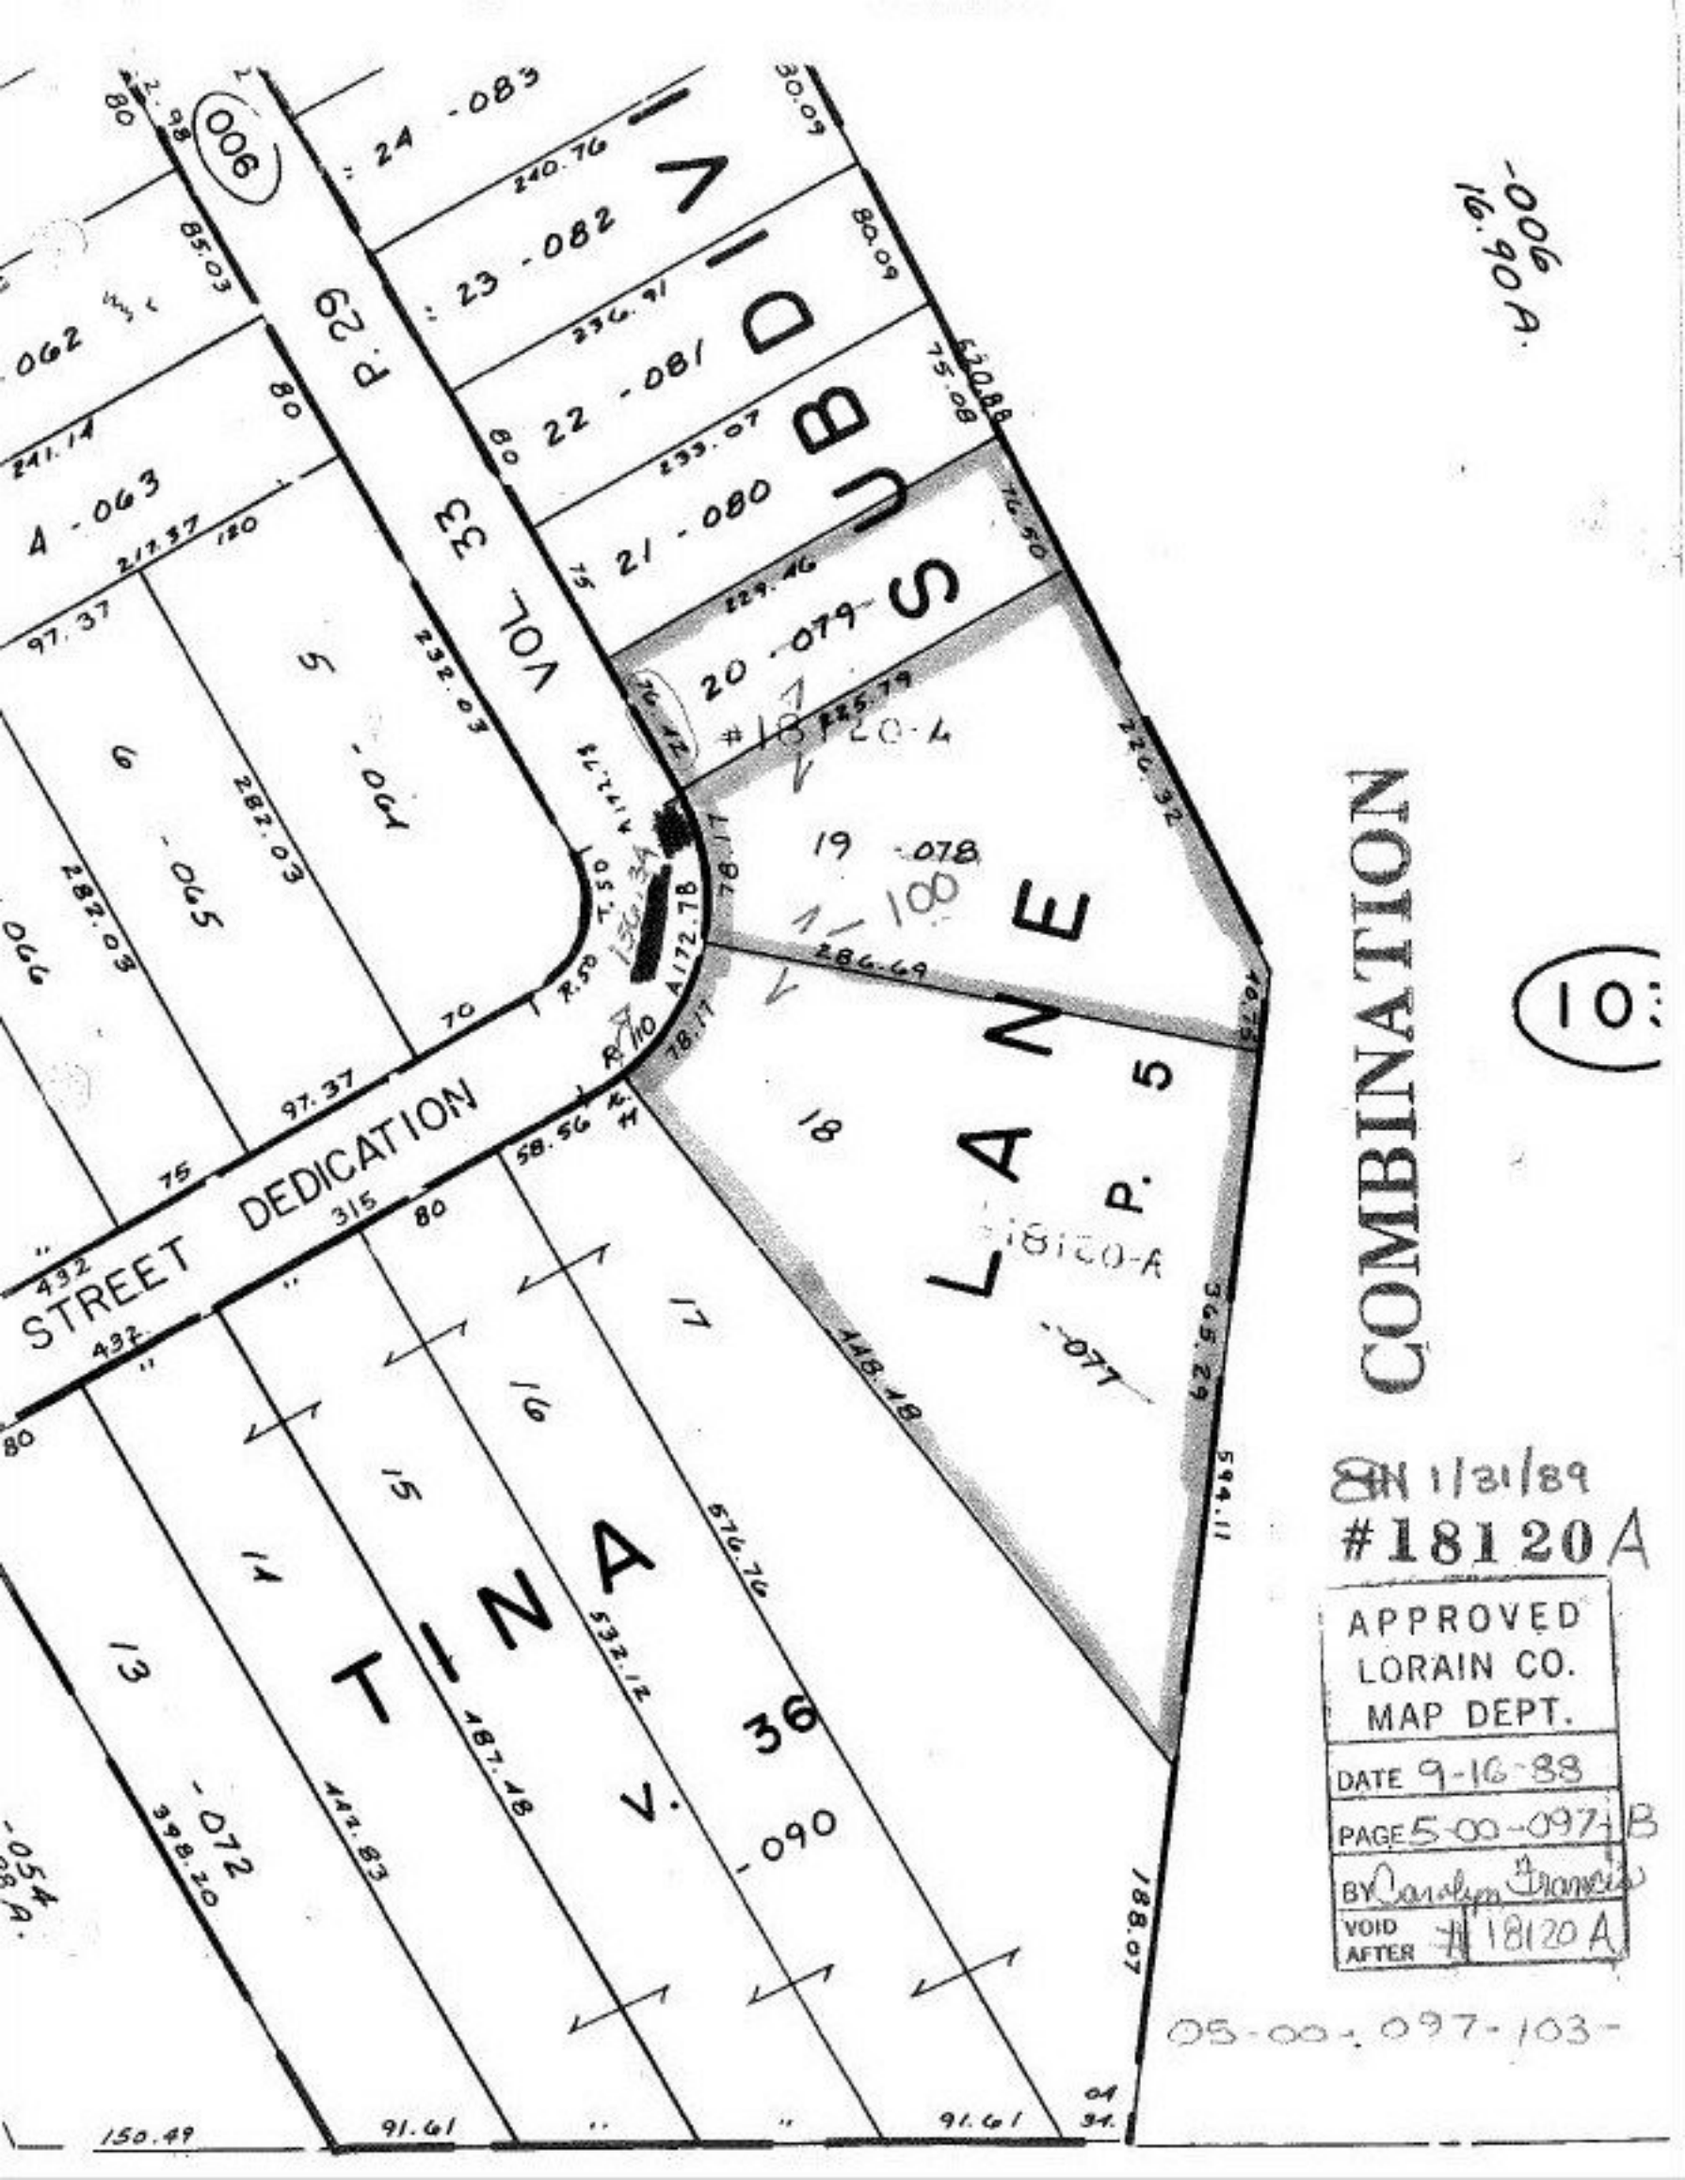
006
.24 -083
240.76
30.09
.23 -082
80.09
80 22 -081
236.91
75.08
233.07
21 -080
75
229.46
76.50
20 -079
#18120-A
225.79
226.92
19 -078
100
286.69
78.17
18
17
16
15
14
13
12
11
10
9
8
7
6
-065
-064
-063
-062
-054
-072
-090
-077
VOL 33 P. 29
SUBDIVISION
LANE
P. 5
STREET DEDICATION
COMBINATION
10
-006
16.90 A.
BN 1/31/89
#18120A
APPROVED
LORAIN CO.
MAP DEPT.
DATE 9-16-88
PAGE 5-00-097-B
BY Carolyn Francis
VOID
AFTER #18120A
05-00-097-103-